


G-12815

T.17S.R.22E.W.M.

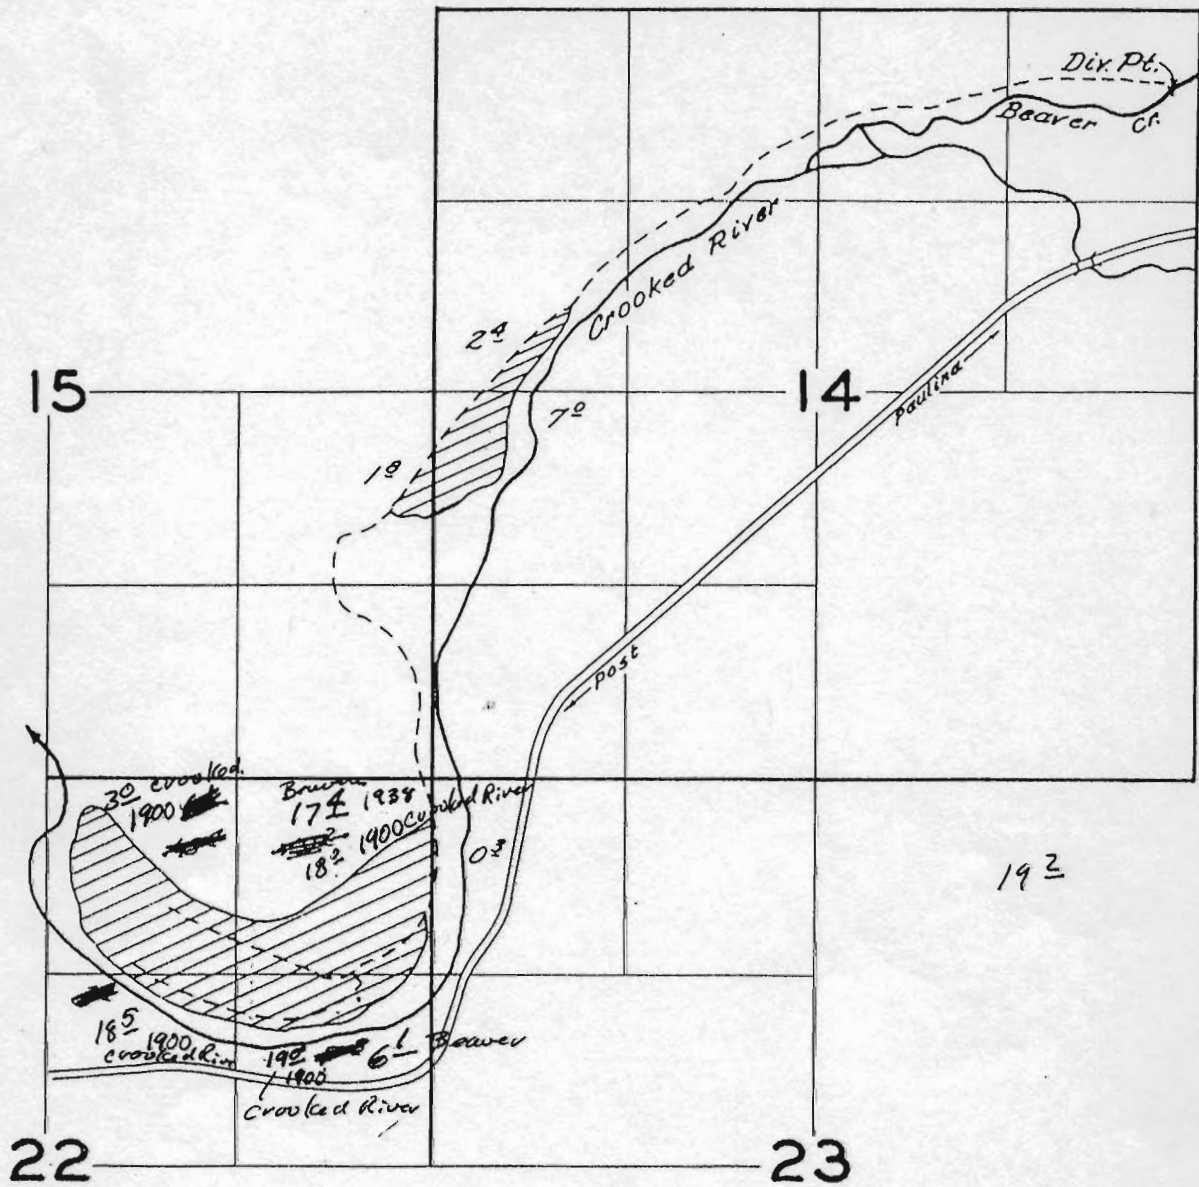

FINAL PROOF SURVEY
 UNDER

Application No. 17246... Permit No. 12966...
 IN NAME OF 1938

H. F. Severance

Surveyed Sept. 25 1957, by C. D. Bartels