


T. 16 S., R. 43 E., W.M.

T-8616

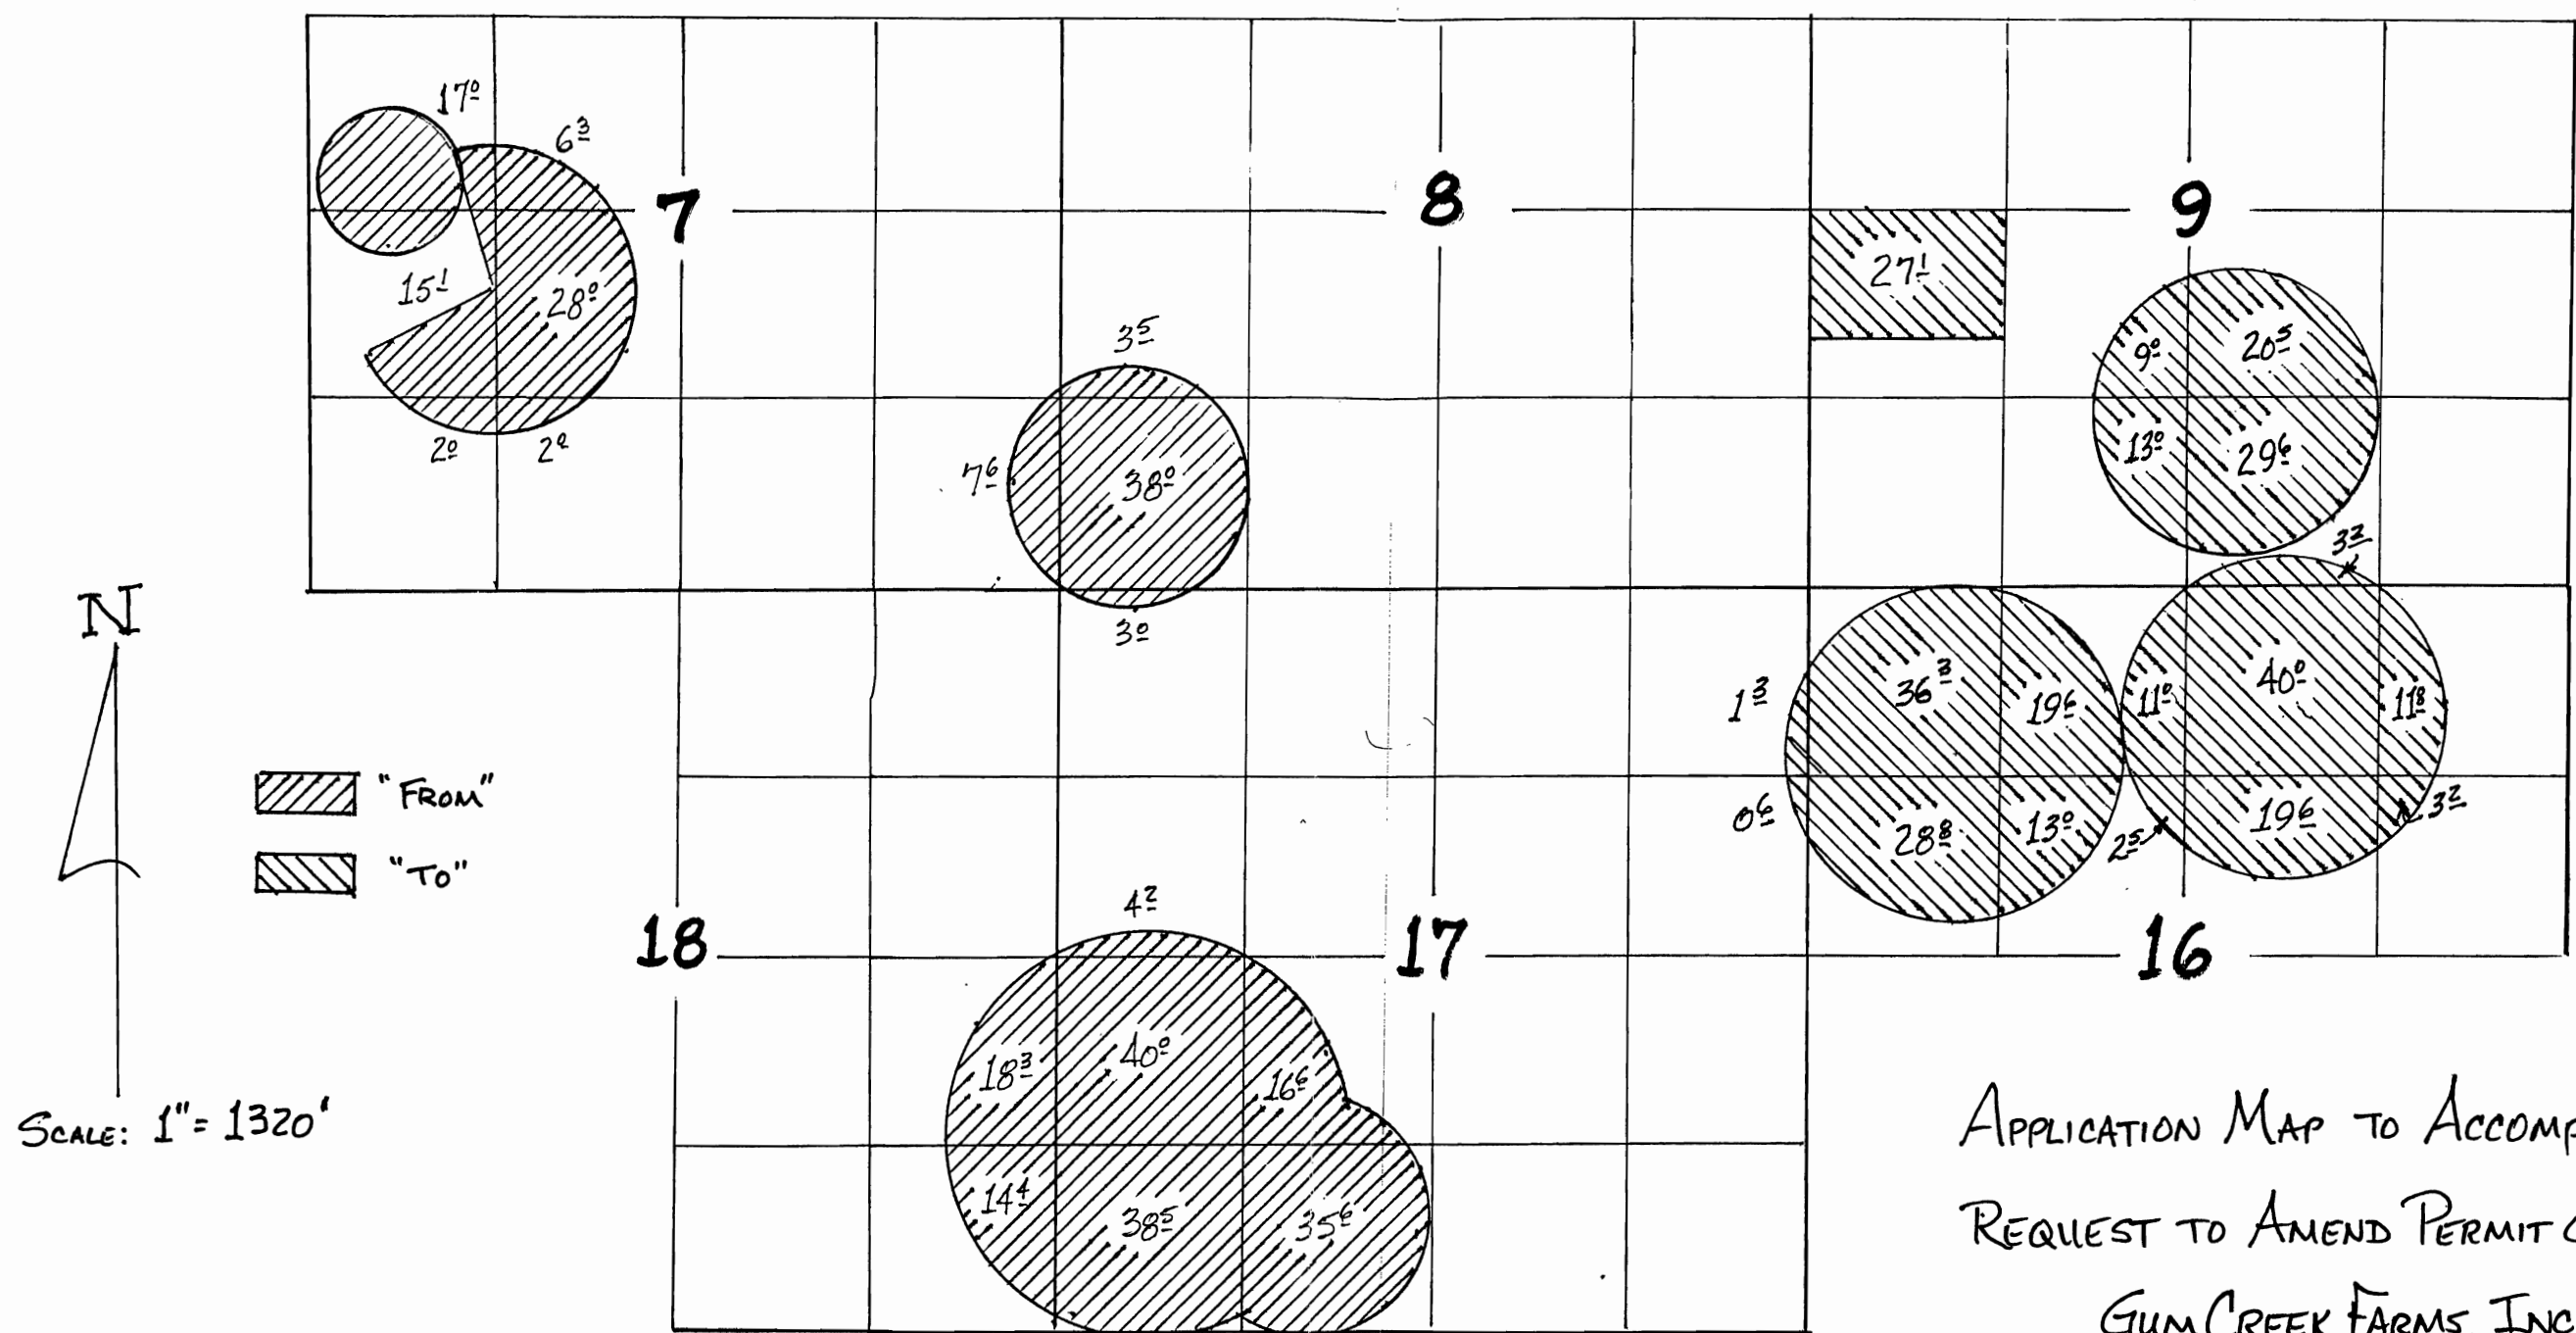

APPLICATION MAP TO ACCOMPANY
REQUEST TO AMEND PERMIT G-13533
GUM CREEK FARMS, INC.

RECEIVED

OCT 16 2000

WATER RESOURCES DEPT.
SALEM, OREGON