


Map to accompany application  
for transfer of water right


B. Morrison, applicant  
Amended July, 2006

AMENDED MAR., 2007


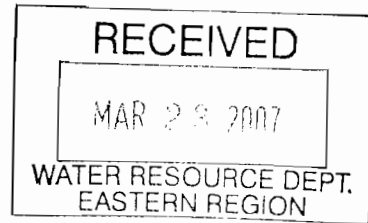


SCALE 1" = 1320'

T. 9S., R. 45E., W.M.

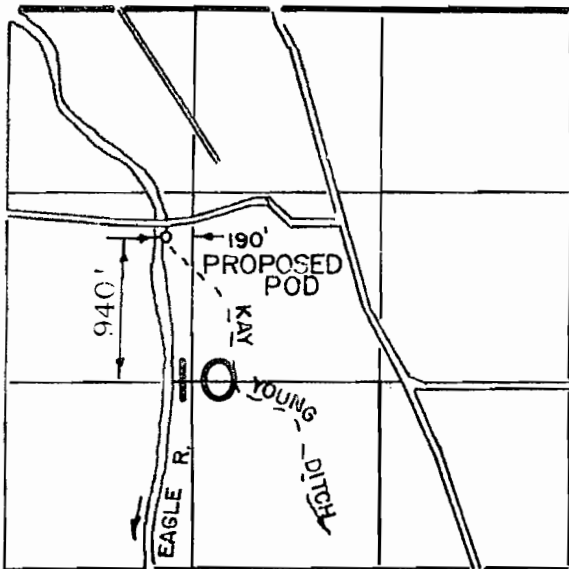

T. 8S., R. 45E., W.M.

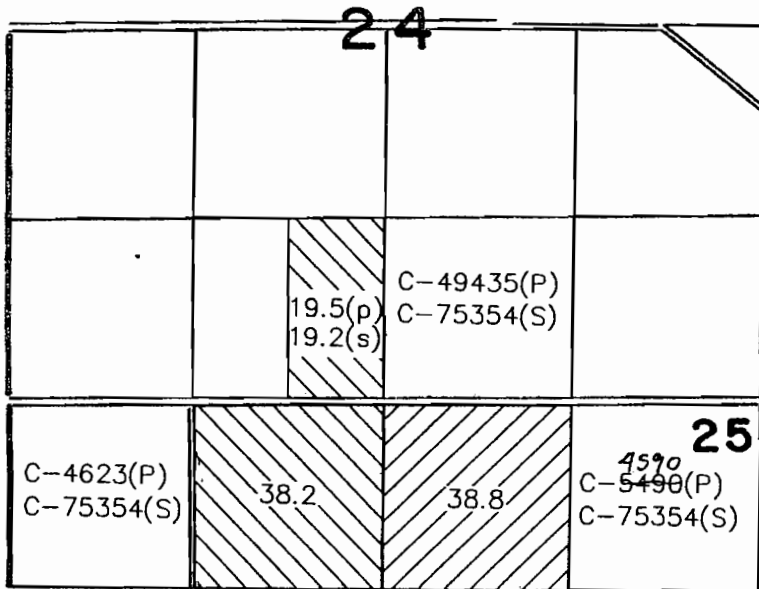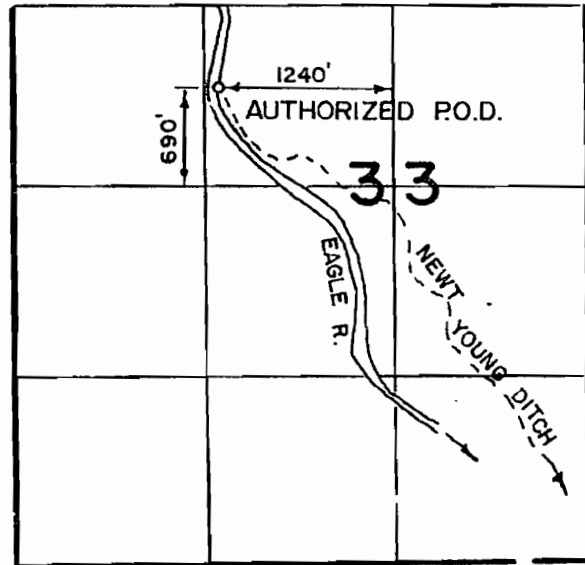

T. 9S., R. 45E., W.M.

LEGEND

- T-9980
- T-9979

NOTE:

Remaining Lands Under Roads

