


TOWNSHIP 9 SOUTH, RANGE 14 EAST, W.M.

T-8643

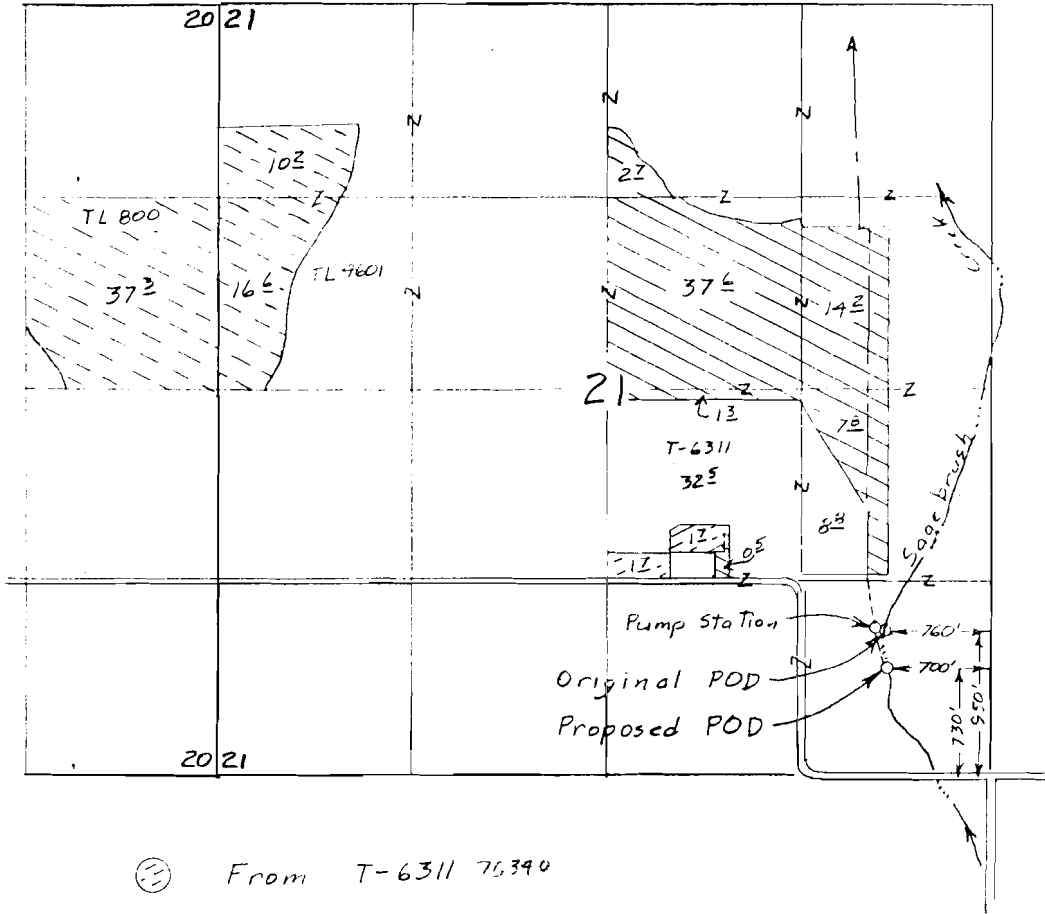


- ⊖ From T-6311 76390
- ⊖ To T-6311 16142
- ⊖ From C-64424 1211
- ⊖ To C-64424

RECEIVED

DEC 18 2000

WATER RESOURCES DEPT.
SALEM, OREGON

Transfer Application Map
for
WILLIAM & CAROLYN DURETTE

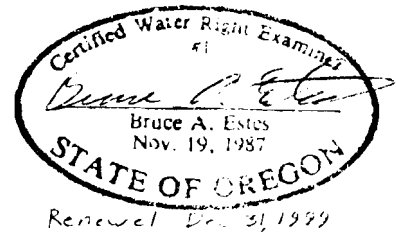

This map is for the purpose of locating a water right only and has no intent to provide legal dimensions or the location of property lines.

ESTES SURVEYS

PO Box 17519 60382 Arnold Rd
Salem, OR 97305-7519 Bend, OR 97702
(503) 585-7593 (541) 382-7391