

T-8649

East Fork Irrigation District 2000 District Transfer						
Legal Description	Name	To	From	Cert. Type	Cert. #	Comments
Certificate # 74642	ZN-10-26 NW/NW (BB)					
Use: Irrigation						
ZN-10-26 NW/NW 1700	Ewe & I, Corp.		0.41	P	74642	Open Space
ZN-10-26 NW/NW 2000	Ewe & I, Corp.		0.30	P	74642	Open Space
ZN-10-26 NW/NW Homestead Drive	Ewe & I, Corp.		1.73	P	74642	Roadway
ZN-10-26 NW/NW Farwig Road	Ewe & I, Corp.		1.18	P	74642	Roadway
ZN-10-26 NW/NW Vance Road	Ewe & I, Corp.		0.33	P	74642	Roadway
	Total		3.95			

RECEIVED

DEC 29 2000

WATER RESOURCES DEPT.
SALEM, OREGON


THIS MAP WAS PREPARED FOR ASSESSMENT PURPOSE ONLY

NW1/4 NW1/4 SEC. 26 T.2N. R.10E. W.M.
HOOD RIVER COUNTY

2N 10 26BB

1" = 100'

T-8649

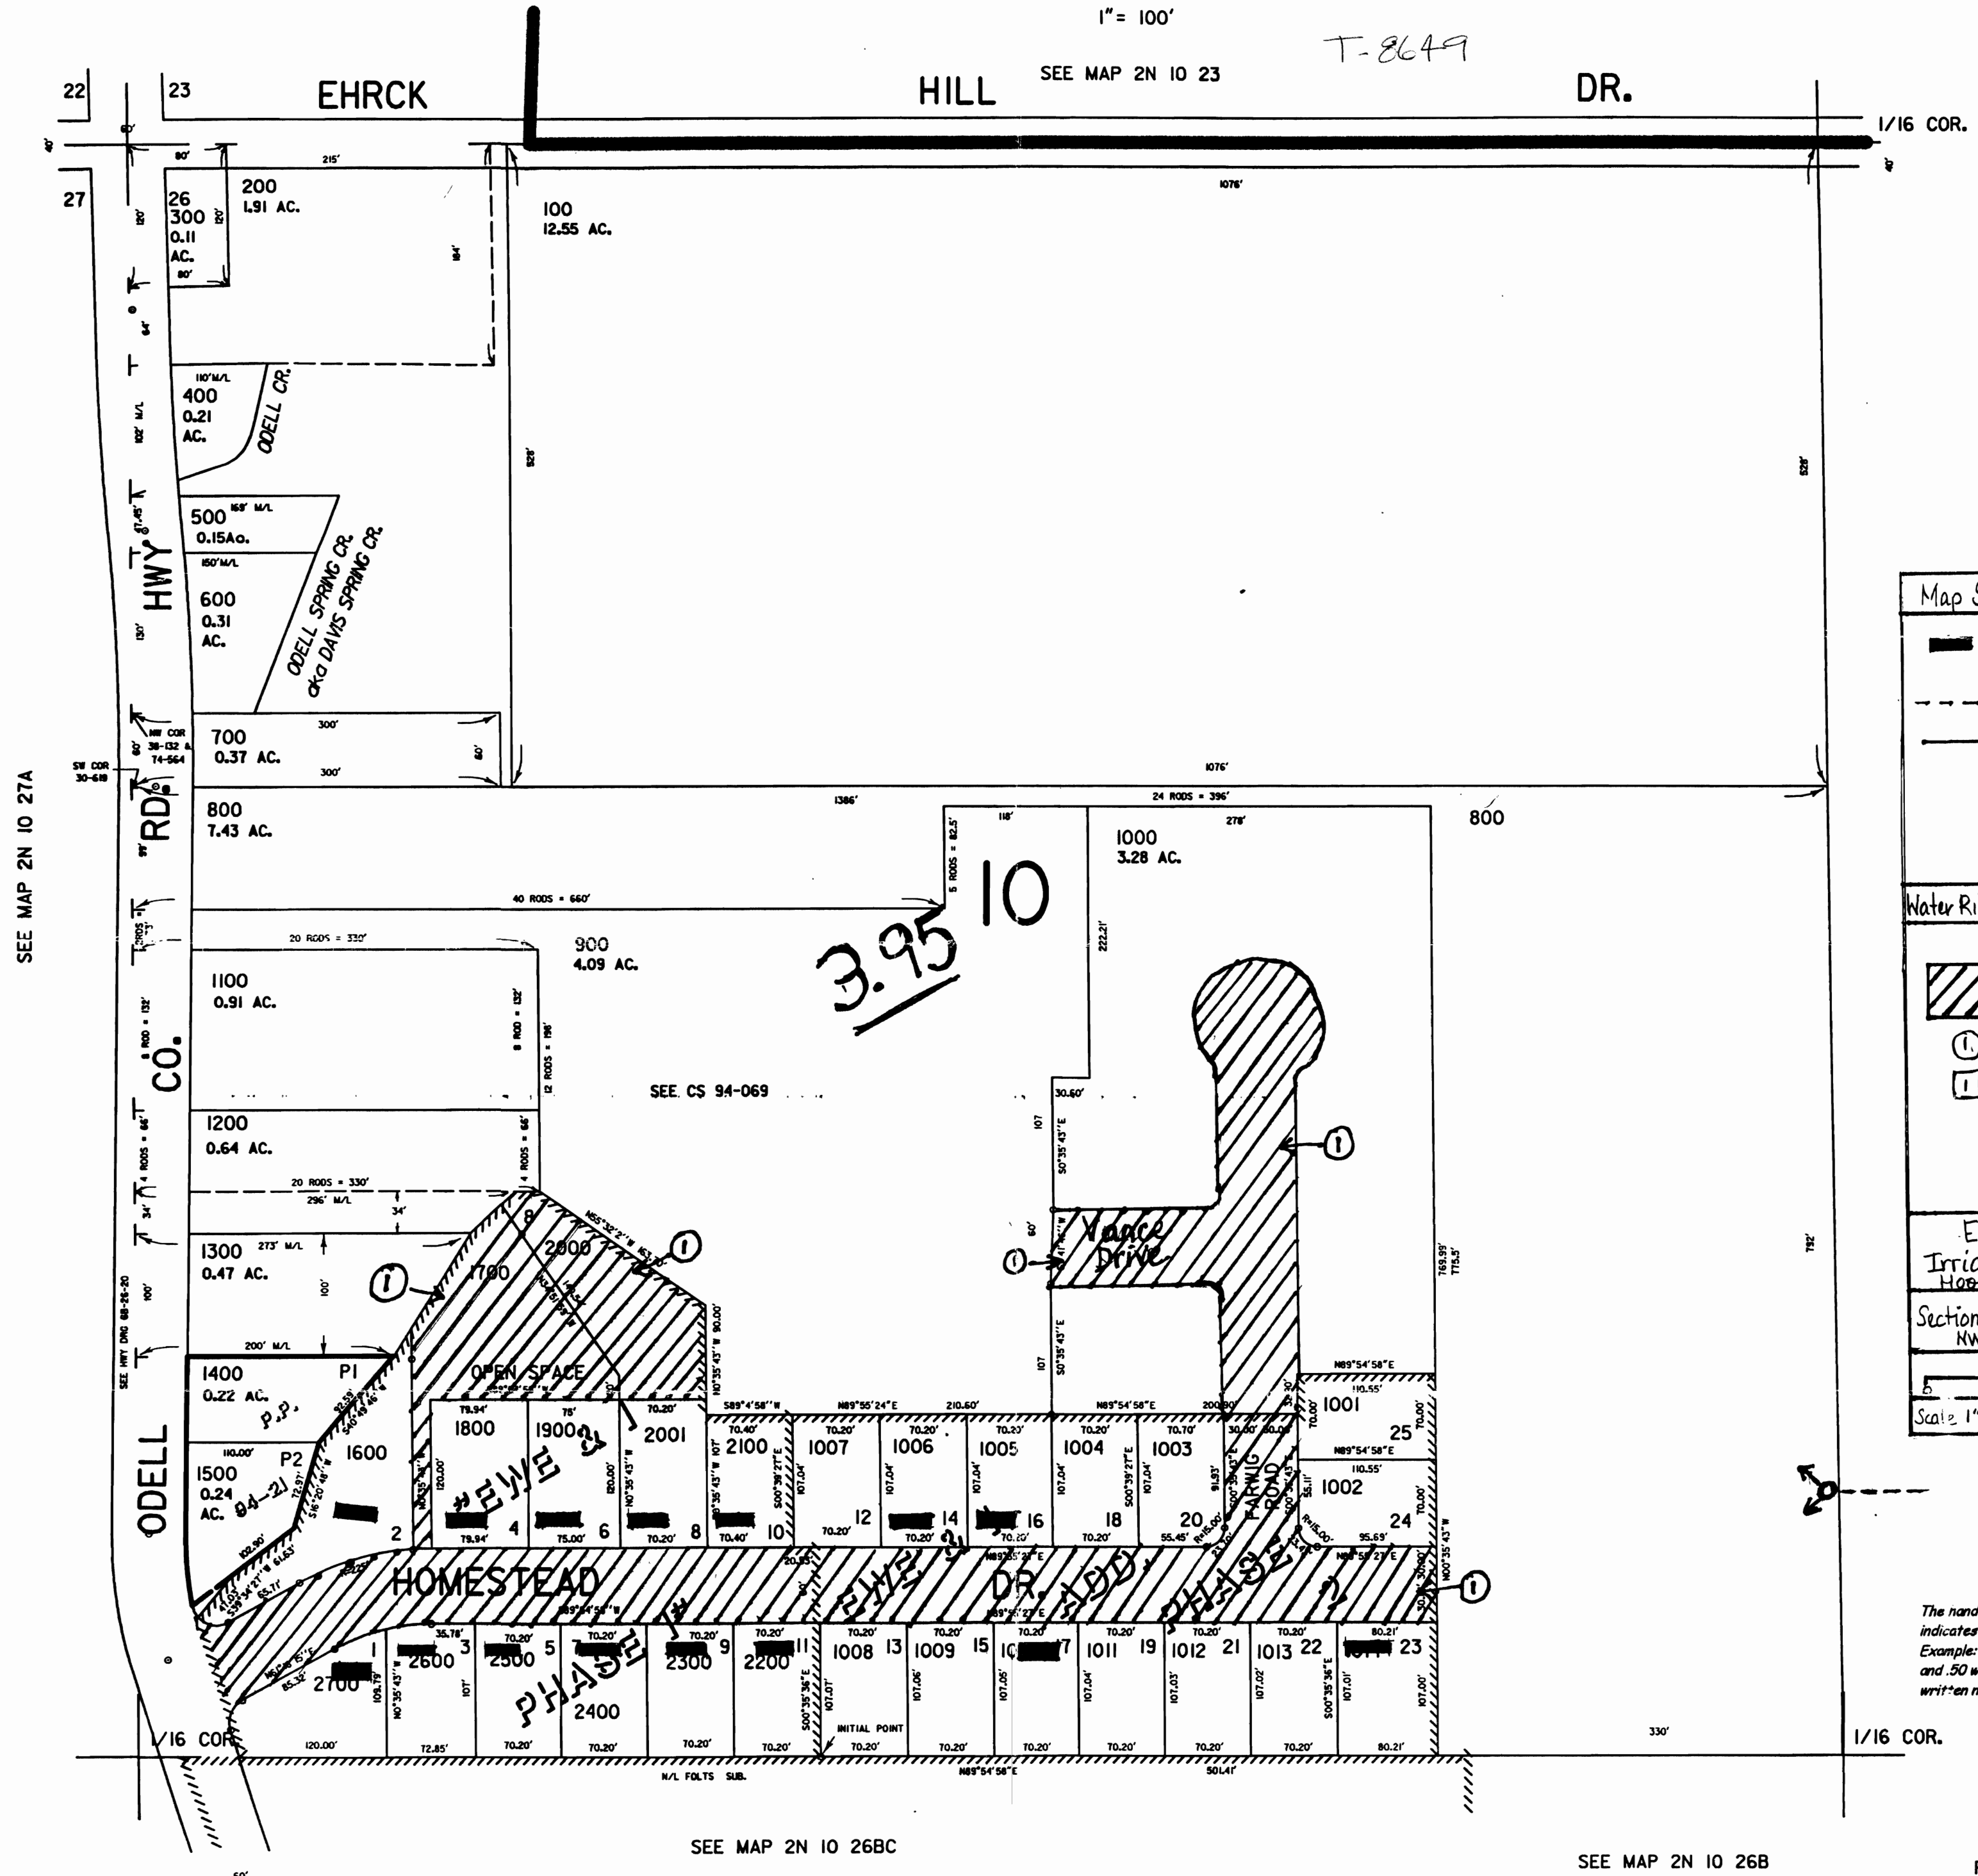

SEE MAP 2N 10 27A

SEE CS 94-069

SEE MAP 2N 10 26BC

SEE MAP 2N 10 26B

Map Symbol Legend

- House
- Turnout Box
- property line

Water Right Certificate Legend

- C-74642
- Transfer from
- Transfer to

East Fork
Irrigation District
Hood River, Oregon

Section 26 T.2N R.10E
NW/NW (BB)

Scale 1" = 100' CMS

The hand-written number in the Qtr/Qtr indicates the total amount of water moved. Example: If .20 water right acres are added and .50 water right acres are removed, the written number would be .70.

Revised 11/4/99, JD

2N 10 26BB