


T. 8 S. R. 39 E. W. M.

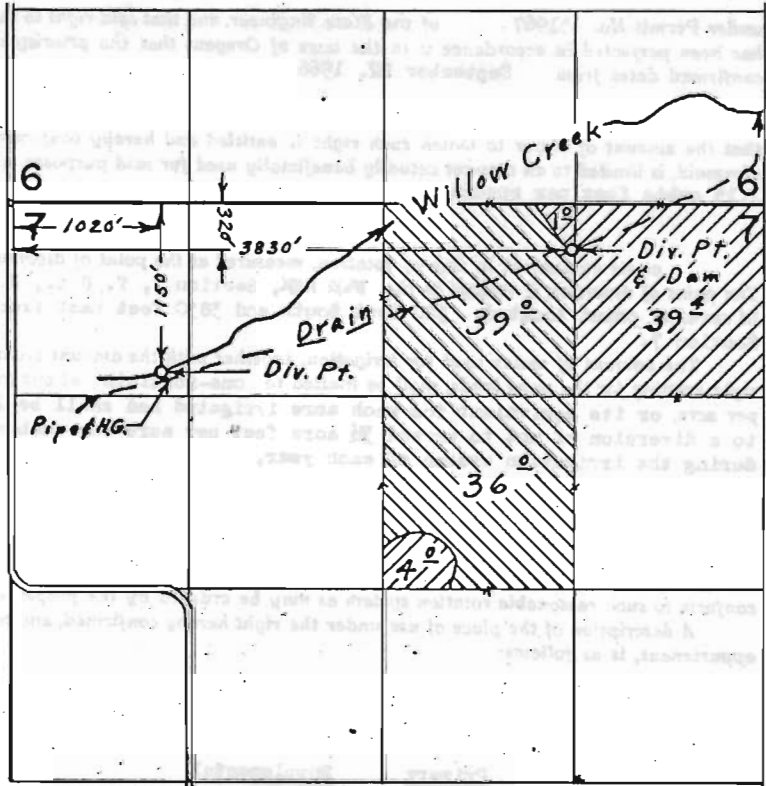

FINAL PROOF SURVEY UNDER

Application No. 44284 Permit No. 33077
42446 IN NAME OF

PAUL K. & MARTHA J. JACOBS

Surveyed June 6, 1970, by L. E. Gould