


T.4S.R.1E.W.M.

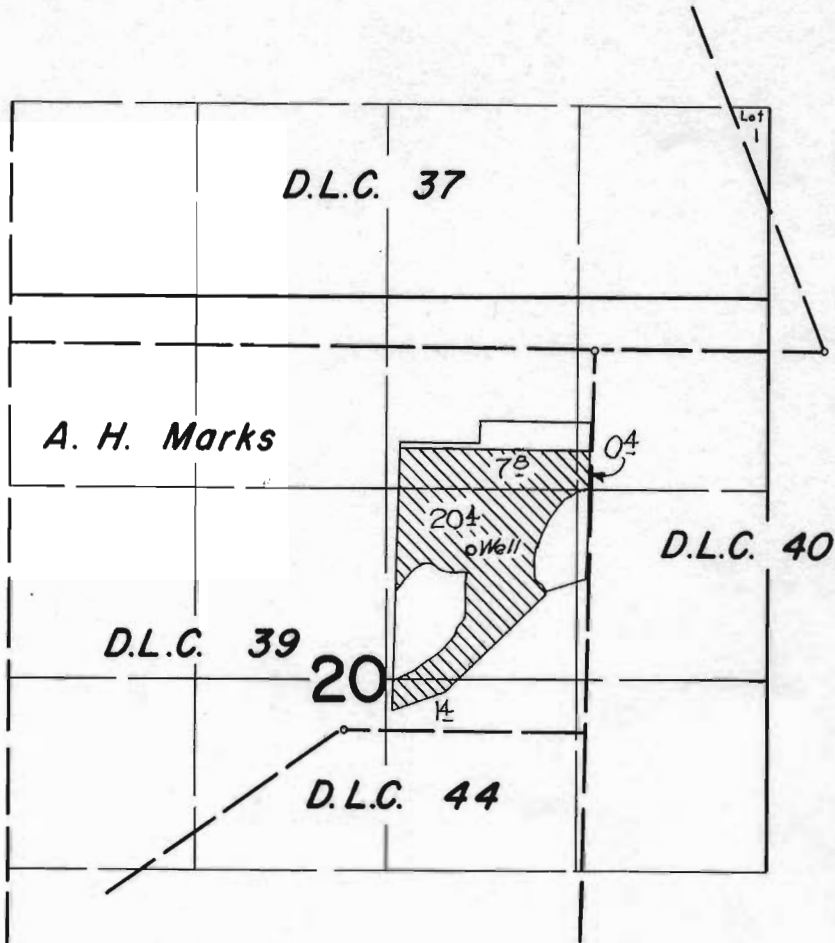

FINAL PROOF SURVEY UNDER

Application No. G-1698 Permit No. G-1558
IN NAME OF

ROBERT RATCLIFF

Surveyed May 28, 1963, by

Jackson

