


TIN. R. 3 W. W.M.

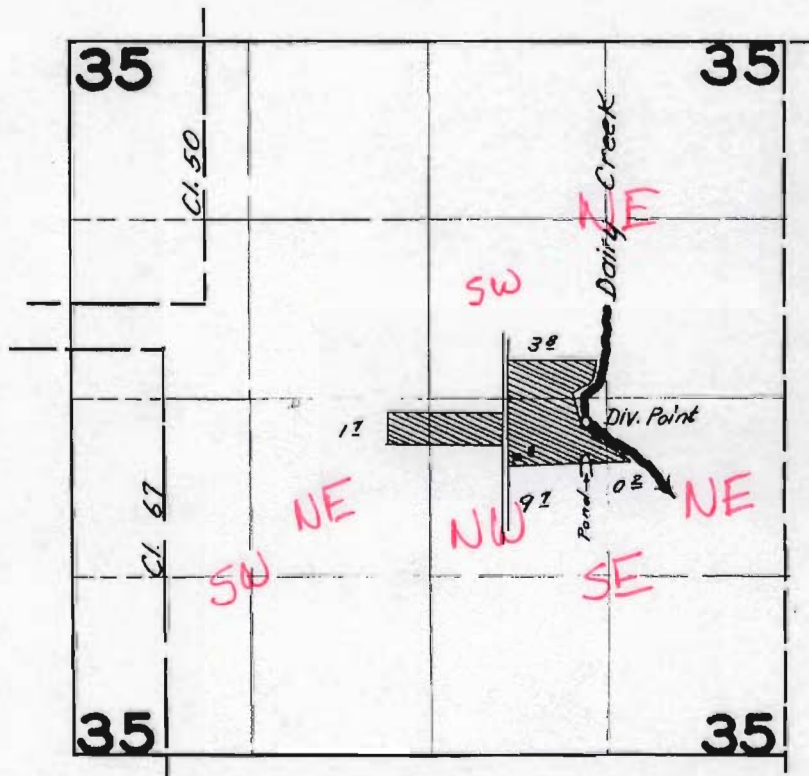

FINAL PROOF SURVEY
UNDER

Application No. 21561 Permit No. 16905
IN NAME OF

A. A. THOMAS AND SURETY COMPANY

Surveyed June 2, 1952, by H. L. COFFMAN