


T.4S. R.13E. W.M.

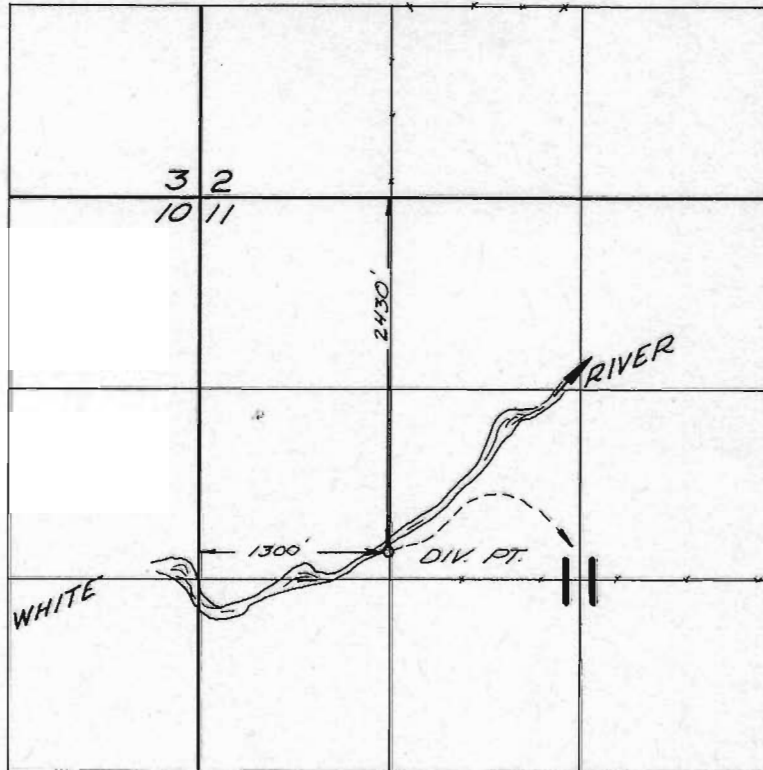

FINAL PROOF SURVEY
UNDER

TRANSFER V-25

Application No. Permit No.

IN NAME OF

PAUL R. VOGT and MRS. JOE CHASTAIN

Surveyed *Nov. 16, 1967*, by *V. Garner*.....