


T.17S. R.21E. W.M.

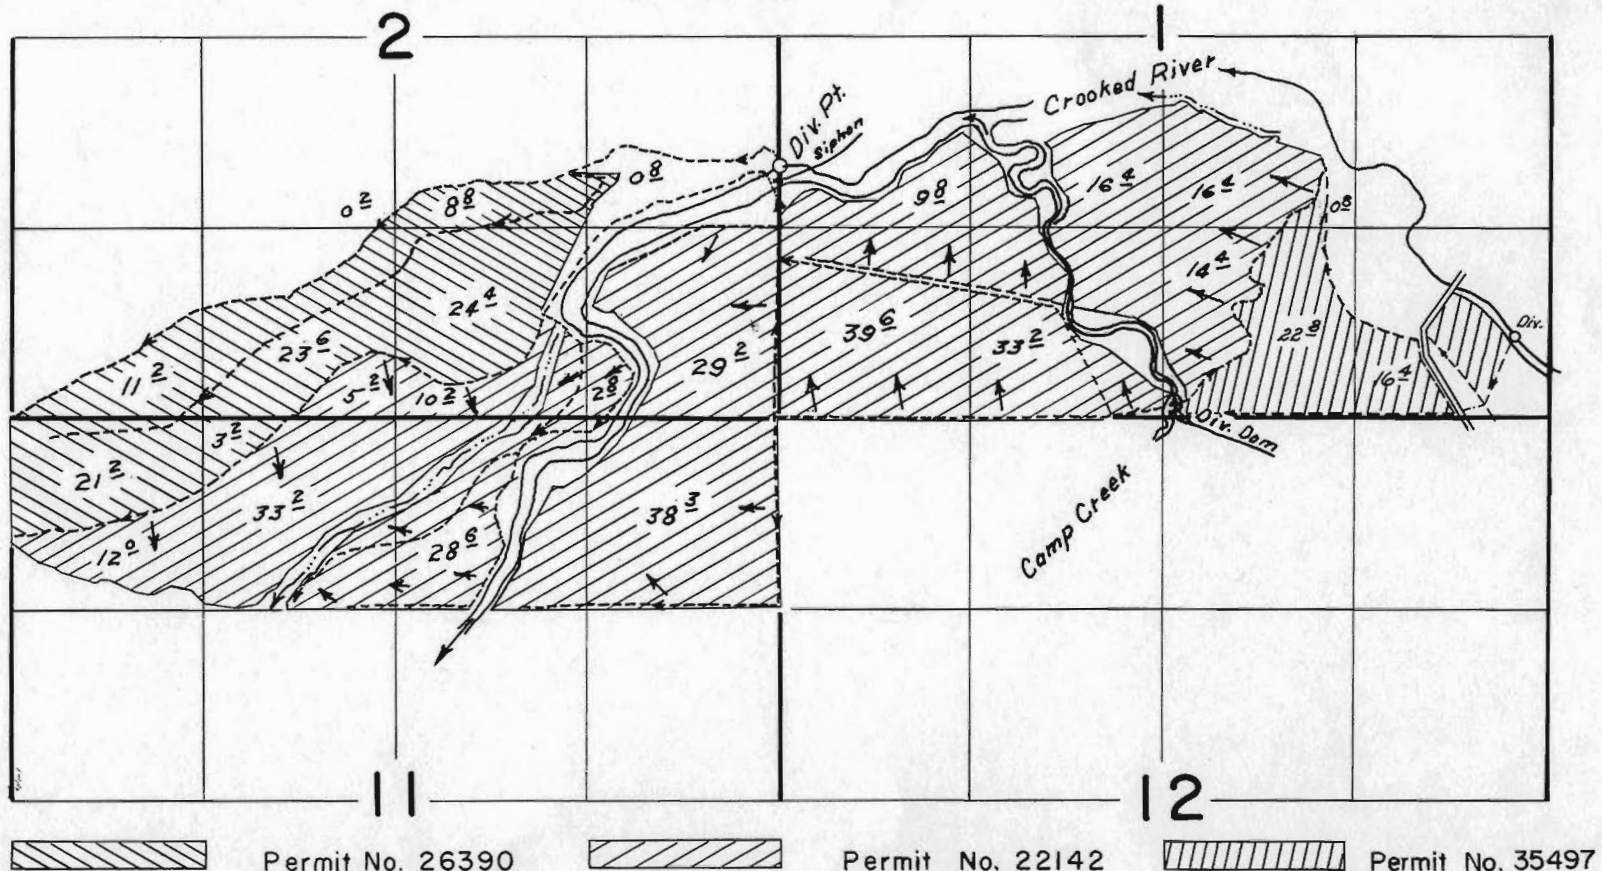

Permit No. 26390 Permit No. 22142 Permit No. 35497

FINAL PROOF SURVEY
UNDER

Application Nos. 47742, 28130, 33409 Permit Nos. 35497, 22142, 26390

IN NAME OF

GALE MERWIN

Aug. 4, 1977 D. NORBY
Surveyed Sept. 29, 30, 1964 By: R. Jackson