

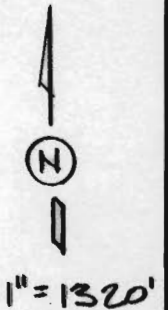


SECTION 2 & 3, T.15., R.3W., W.M.

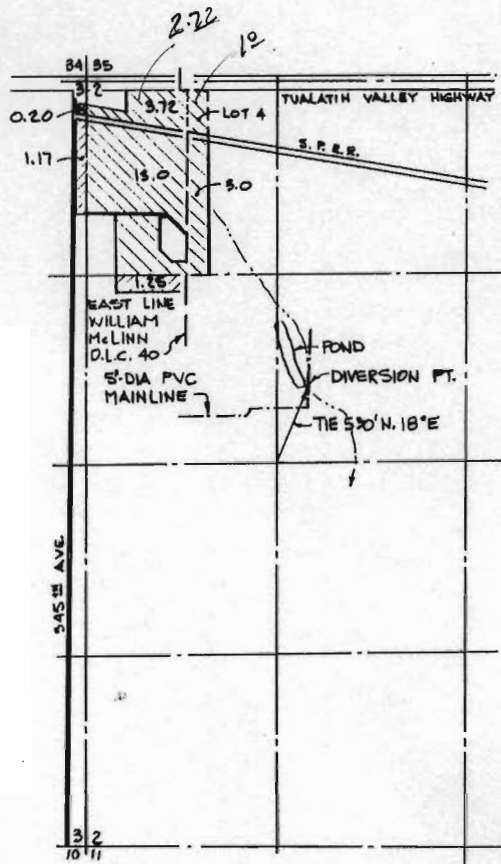

PREPARATION OF THIS MAP IS FOR THE PURPOSE OF IDENTIFYING THE LOCATION OF THE WATER RIGHT ONLY. THERE IS NO INTENT TO PROVIDE DIMENSIONS OR LOCATION OF PROPERTY OWNERSHIP LINES.

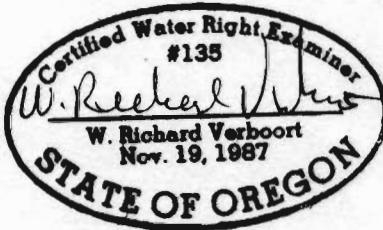

FINAL PROOF SURVEY
UNDER

APPLICATION No. 69610 PERMIT No. 50740

SURVEYED JULY 3, 1991

REVISED 01.26.92

T 10265

VERBOORT ENGINEERING
AGRICULTURE · CIVIL · WATER RESOURCES
HILLSBORO, OREGON

	by date
designed	WRV 7.7.91
drawn	JER 7.7.91
checked	WRV 7.7.91
drawing no.	91-A-11
sheet no.	1/1

EDMUND DUYCK
2020 S.W. 325 TH
HILLSBORO, OR 97123