


T-8652

T. 35 S., R. 1 W., W.M.

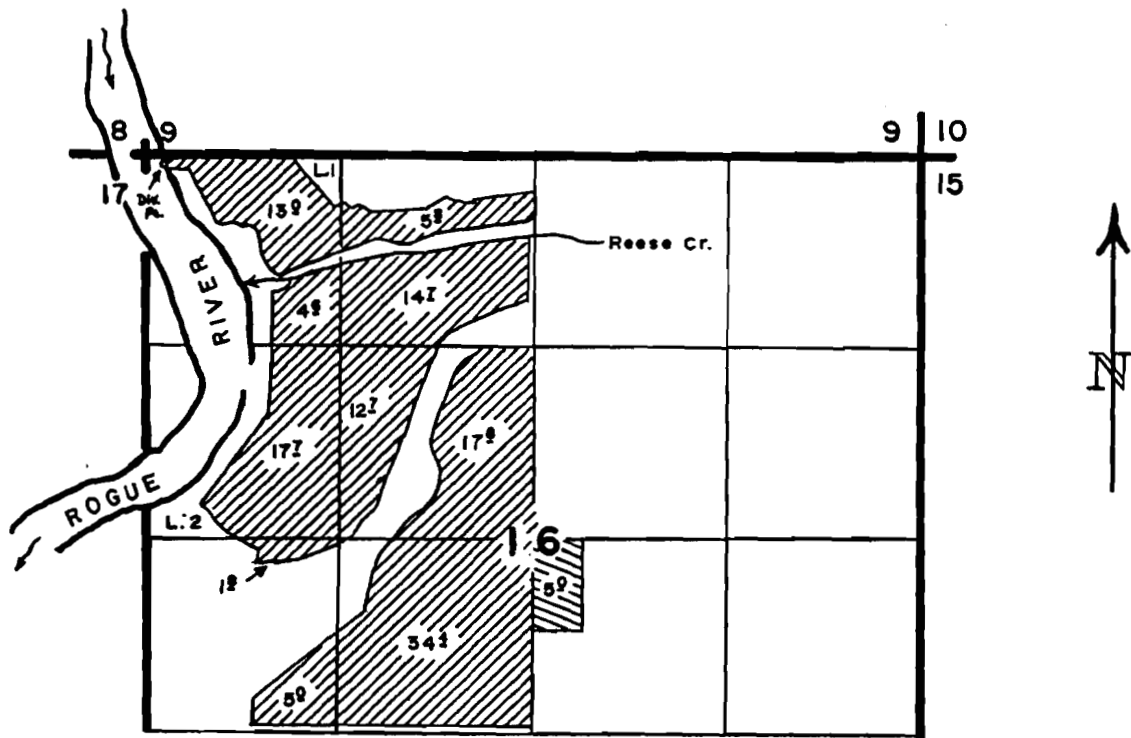

Location of Diversion Point: 48' S. and 120' E. from the NW Cor. of Sec. 16, T.35S.,R.1W.

SCALE: 1" = 1320'

 PRIMARY
 SUPPLEMENTAL

FINAL PROOF SURVEY UNDER

Application No. 59455 Permit No. 44691
IN NAME OF

THOMAS M. & MARY CALDWELL

Surveyed JULY 6 1983, by B.S. JAMES

RECEIVED

DEC 04 2000

WATER RESOURCES DEPT
SALEM, OREGON

EPID - 63 TWB
Corrected 5-22-92 