

SCALE 1" = 1320'


RECEIVED

OCT 05 1998

WATER RESOURCES DEPT.
SALEM, OREGON



Primary lands to be irrigated by well.

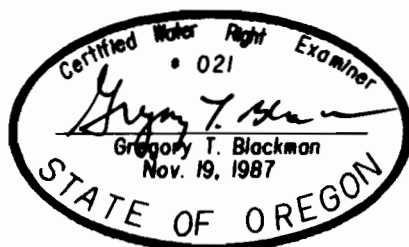

NOTE: The preparation of this map was for the purpose of identifying the location of the proposed water right and has no intent to provide dimensions or location of property ownership lines. Location information shown hereon was furnished by the applicant.

FINAL PROOF MAP OF WATER RIGHTS FOR JANIS CONKLIN

BY
BAGETT - GRIFFITH & BLACKMAN
2006 ADAMS AVENUE
LAGRANDE, OREGON 97850

JULY 30, 1998

APPLICATION NO. G- 14137

PERMIT NUMBER G- 13078