


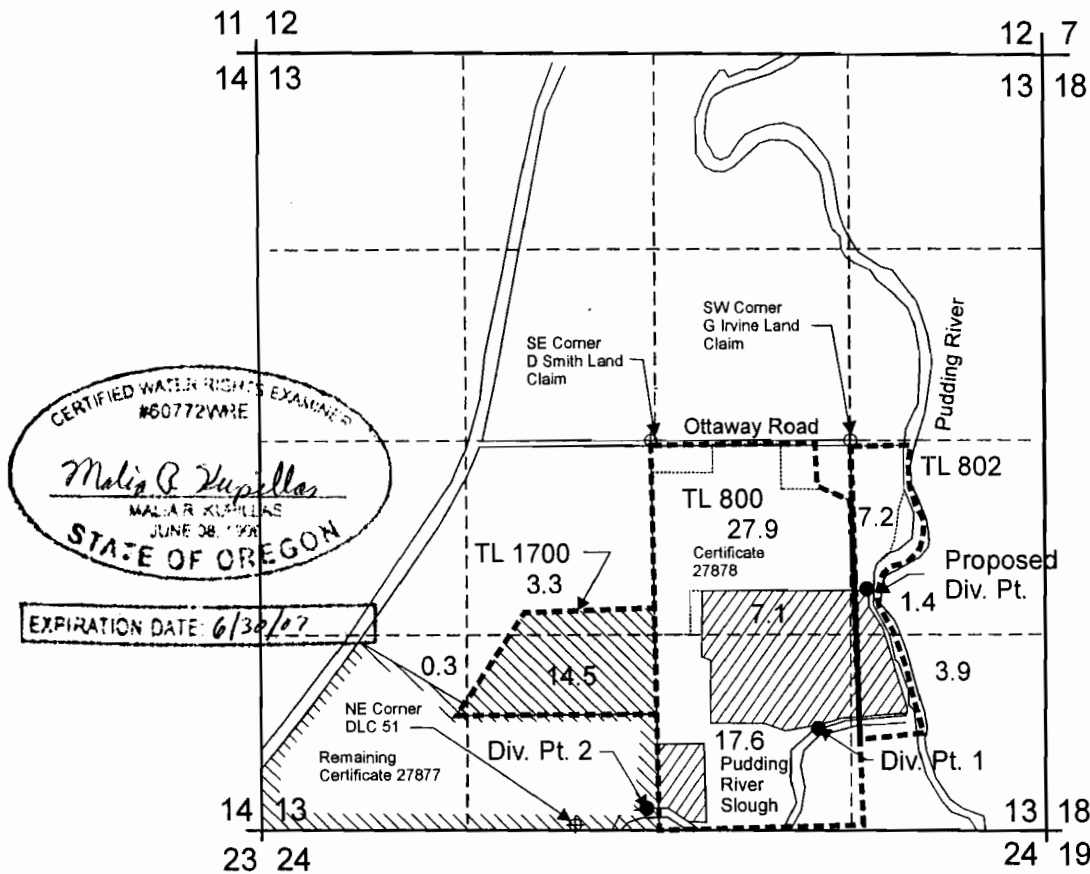


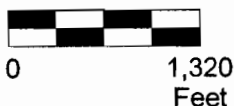
T.4S. R.1W. Sec. 13, W.M.



Div. Pt. 1 (Existing for Permit 19189) is located in the SW 1/4 SE 1/4, Sec. 13. T.4S. R.1 W., W.M.
 Div. Pt. 2 (Existing for Permit 24051) is located in the SE 1/4 SW 1/4, Sec. 13. T.4S. R.1 W., W.M.
 Proposed Div. Pt. 3 is located 1,030 ft south and 1,470 feet east from the center of Sec. 13.

-  Area (30.0 Acres) irrigated under Application S-23978, Permit S-19189, Certificate 22661.
-  Area (18.1 Acres) irrigated under Application S-30546, Permit S-24051, Certificate 27877.
-  Tax Lot Boundary

Scale: 1" = 1,320'



This map was prepared for the purpose of identifying the location of a water right only and is not intended to provide legal dimensions or location of property ownership lines.



T 10029

RECEIVED

DEC 01 2005

Transfer Application Map
 Proposed Diversion Point for
 Certificates 22661 and 27877

10029


Pacific Hydro-Geology Inc.

WATER RESOURCES DEPT
 SALEM, OREGON


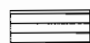
Netterland Nursery

T.4S. R.1W. Sec. 13, W.M. TL 800, 802, 1700


T.4S. R.1W. Sec. 13, W.M.

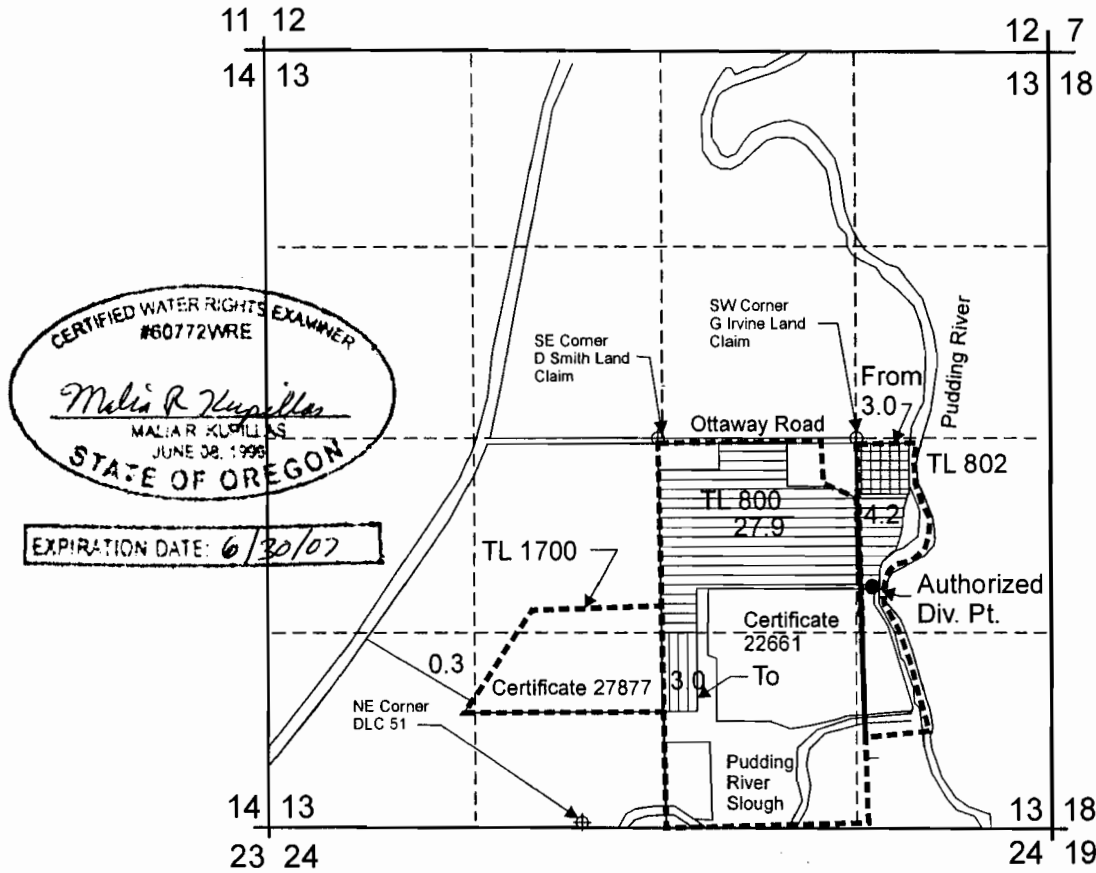

Existing Div. Pt. is located 1,030 ft south and 1,470 feet east from the center of Sec. 13.

-  From Area (3.0 Acres) irrigated under Application S-30949, Permit S-24444, Certificate 27878.
-  To Area (3.0 Acres)
-  Remaining portion of Application S-30949, Permit S-24444, Certificate 27878.
-  Tax Lot Boundary

Scale: 1" = 1,320'

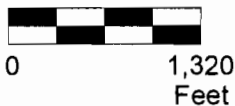

This map was prepared for the purpose of identifying the location of a water right only and is not intended to provide legal dimensions or location of property ownership lines.



T 10029

RECEIVED

Transfer Application Map

Change in Place of Use for Certificate 27878

DEC 01 2005

Netterland Nursery

Pacific Hydro-Geology Inc.

WATER RESOURCES DEPT.
SALEM, OREGON

T.4S. R.1W. Sec. 13, W.M. TL 800, 802, 1700