



RECEIVED

MAR 19 2008

WATER RESOURCES DEPT
SALEM, OREGON


T. 3N., R. 30 E.W.M.

"FROM"

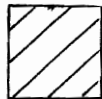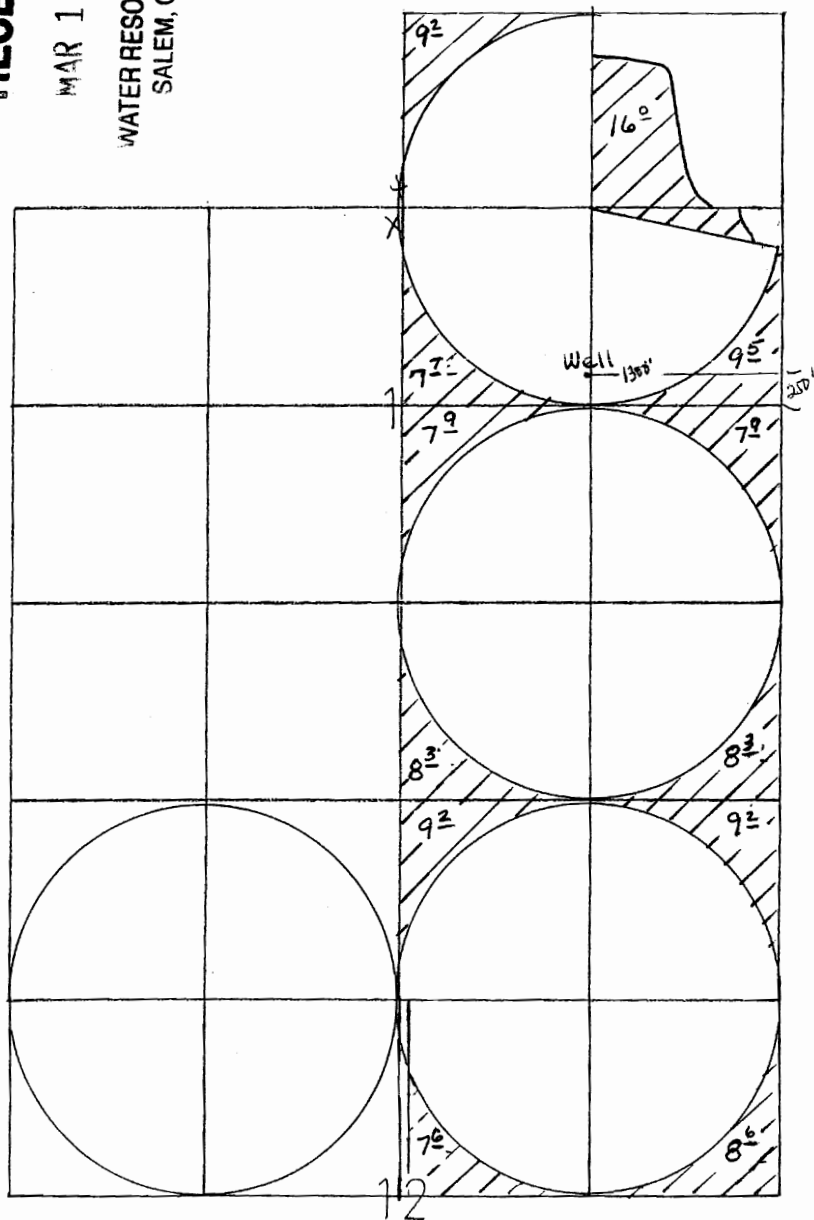

Cert. 54085 109.4 Ac.


"TO"

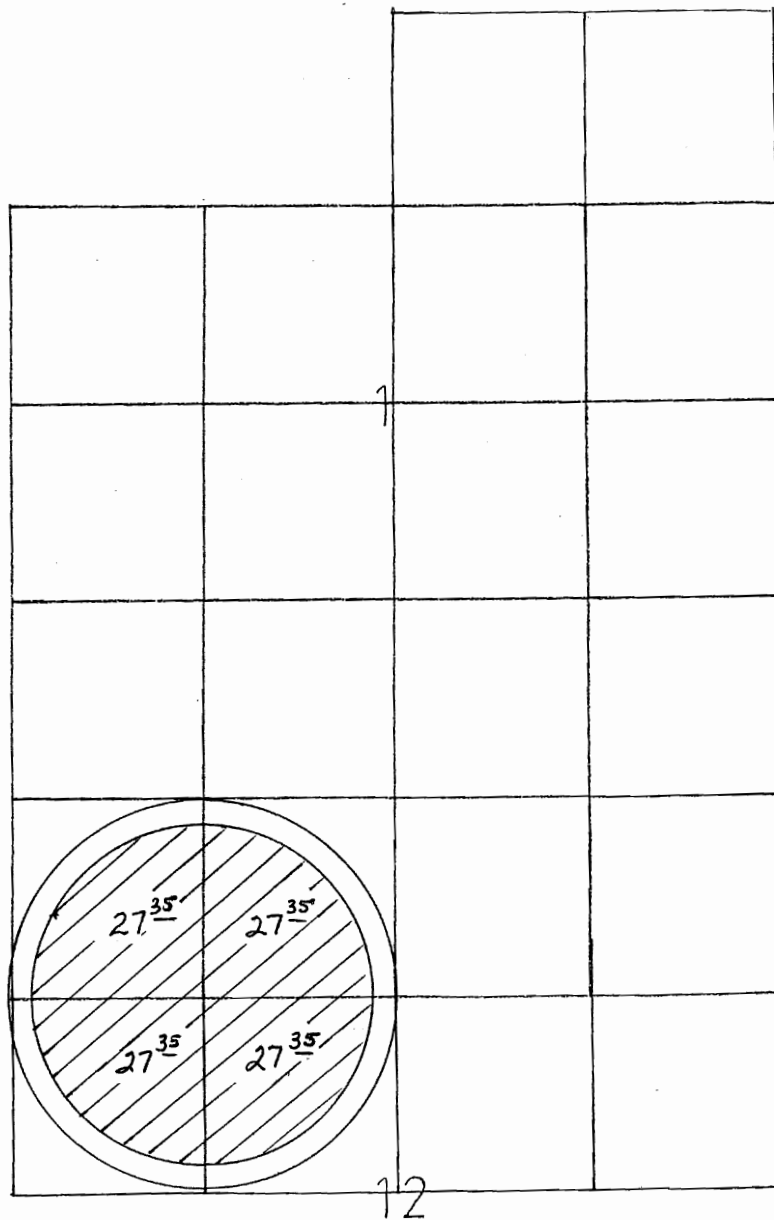

MAP AMENDED
REC'D OCT 16 2008



1" = 1,320'

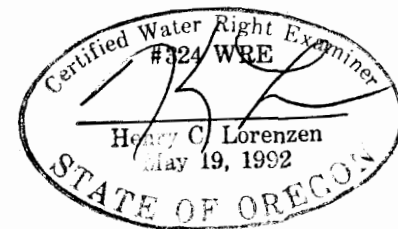


1. 3 N., R. 30 E.W.M.

RECEIVED


MAR 19 2008

WATER RESOURCES DEPT
SALEM, OREGON

"FROM"

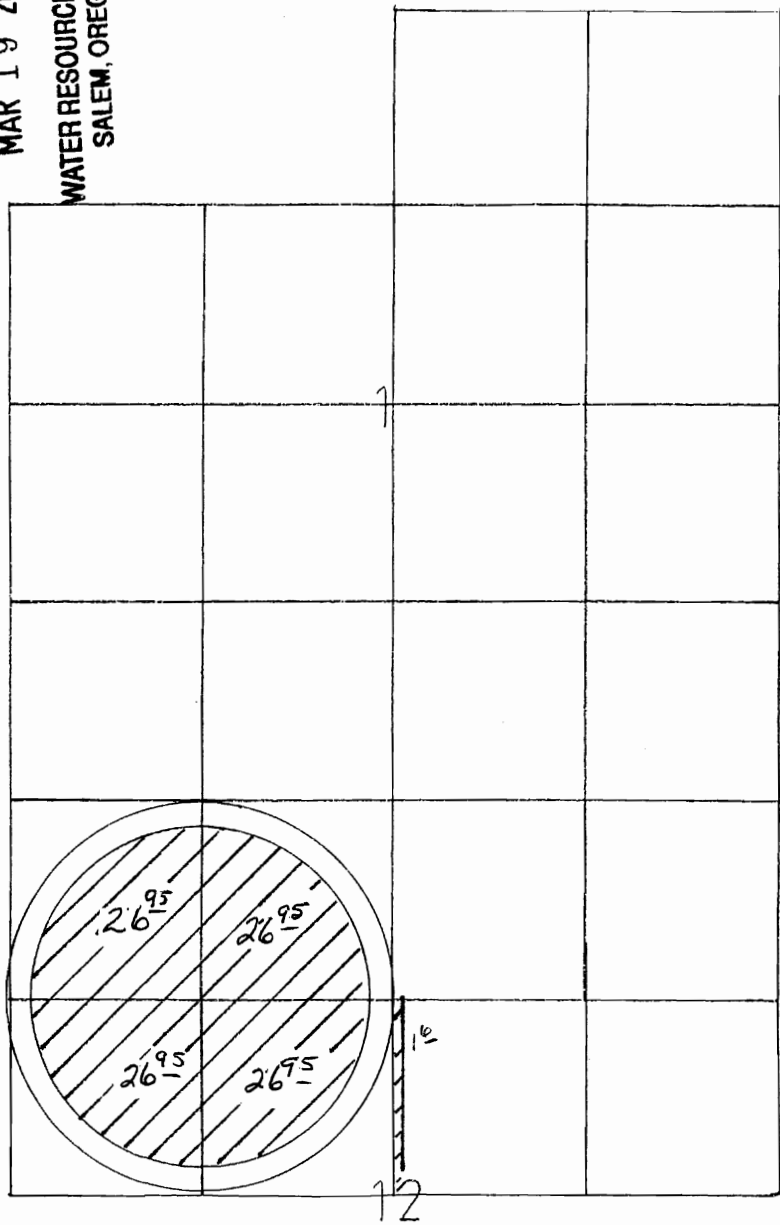


"TO"

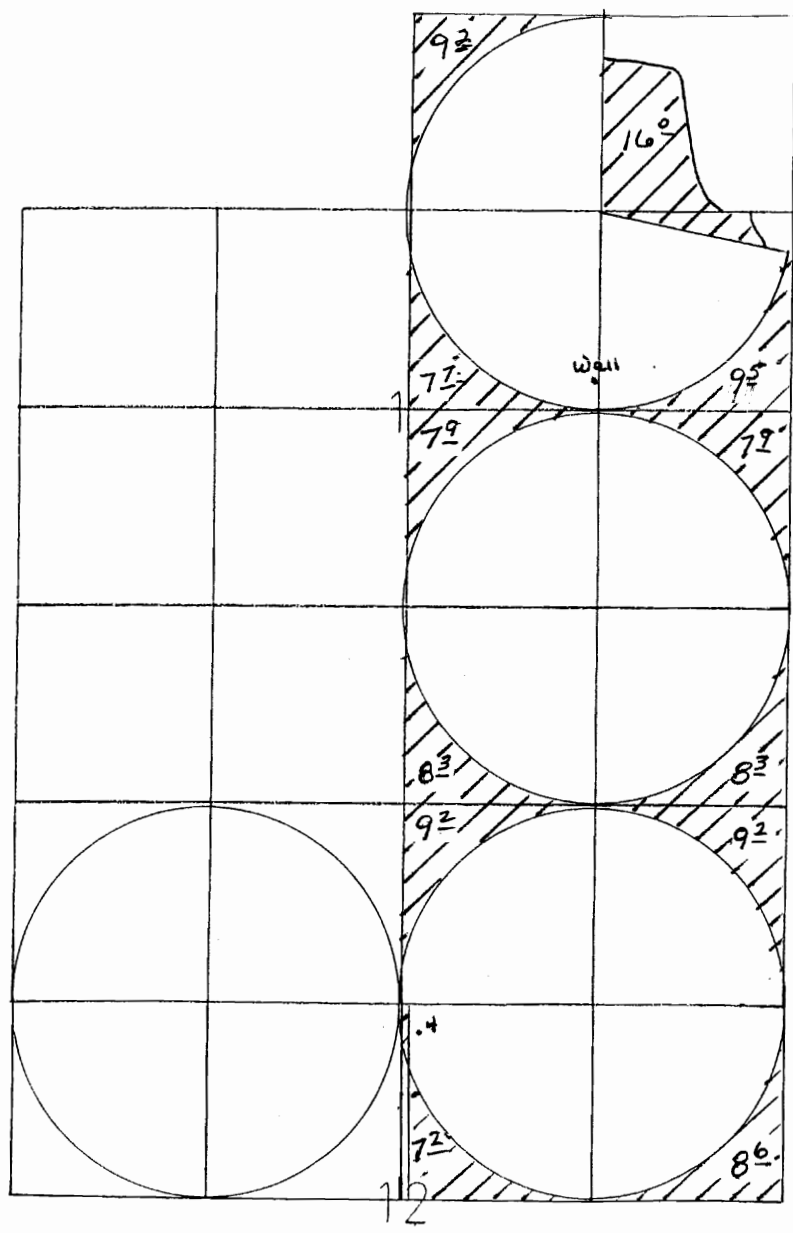

MAP AWARDED
REC'D OCT 16 2008



1" = 1,320'

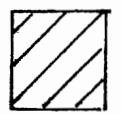

Cert. 54086 109.4 Ac.

