

TRANSFER FROM

● **Authorized POD**
 Surface water diversion located in the SE/4 of NW/4 of Section 22 at a distance 940 feet N and 800 feet W from the Center of Section 22.

▨ **Authorized POU (FROM)**
 3.6 acres, including:
 0.2 acre in SE/NE of Section 21
 3.4 acres in SW/NW of Section 22

▤ **Authorized POU (NOT INCLUDED)**
 10.5 acres in SW/NW of Section 22

T5N, R36E, WM
 Sections 21 & 22
 Umatilla County

1 inch = 400 feet

TRANSFER TO

● **Authorized POD**
 No change proposed to POD.


▨ **Proposed POU (TO)**
 3.6 acres, including:
 2.4 acres in SW/NW of Section 22
 1.2 acres in SE/NW of Section 22

RECEIVED

JUN 27 2007

WATER RESOURCES DEPT
 SALEM, OREGON

The purpose of this map is to identify the location of a water right. It is not intended to provide information regarding the location of property ownership boundary lines.

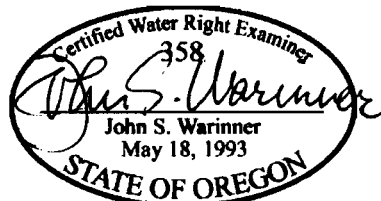

FOUNTAINHEAD
 1860 Blue Creek Road
 Walla Walla, WA 99362
 509.529.2646 phone

TRANSFER MAP
Certificate No. 13259
Change Place of Use

in the name of
 CAYUSE VINEYARDS

Revised 04 JUN 2007