

SECTION FLA1


Section 3  
34

Township 26-S  
25-S

Range 30-E

County of HARNEY State of OR

NORTH

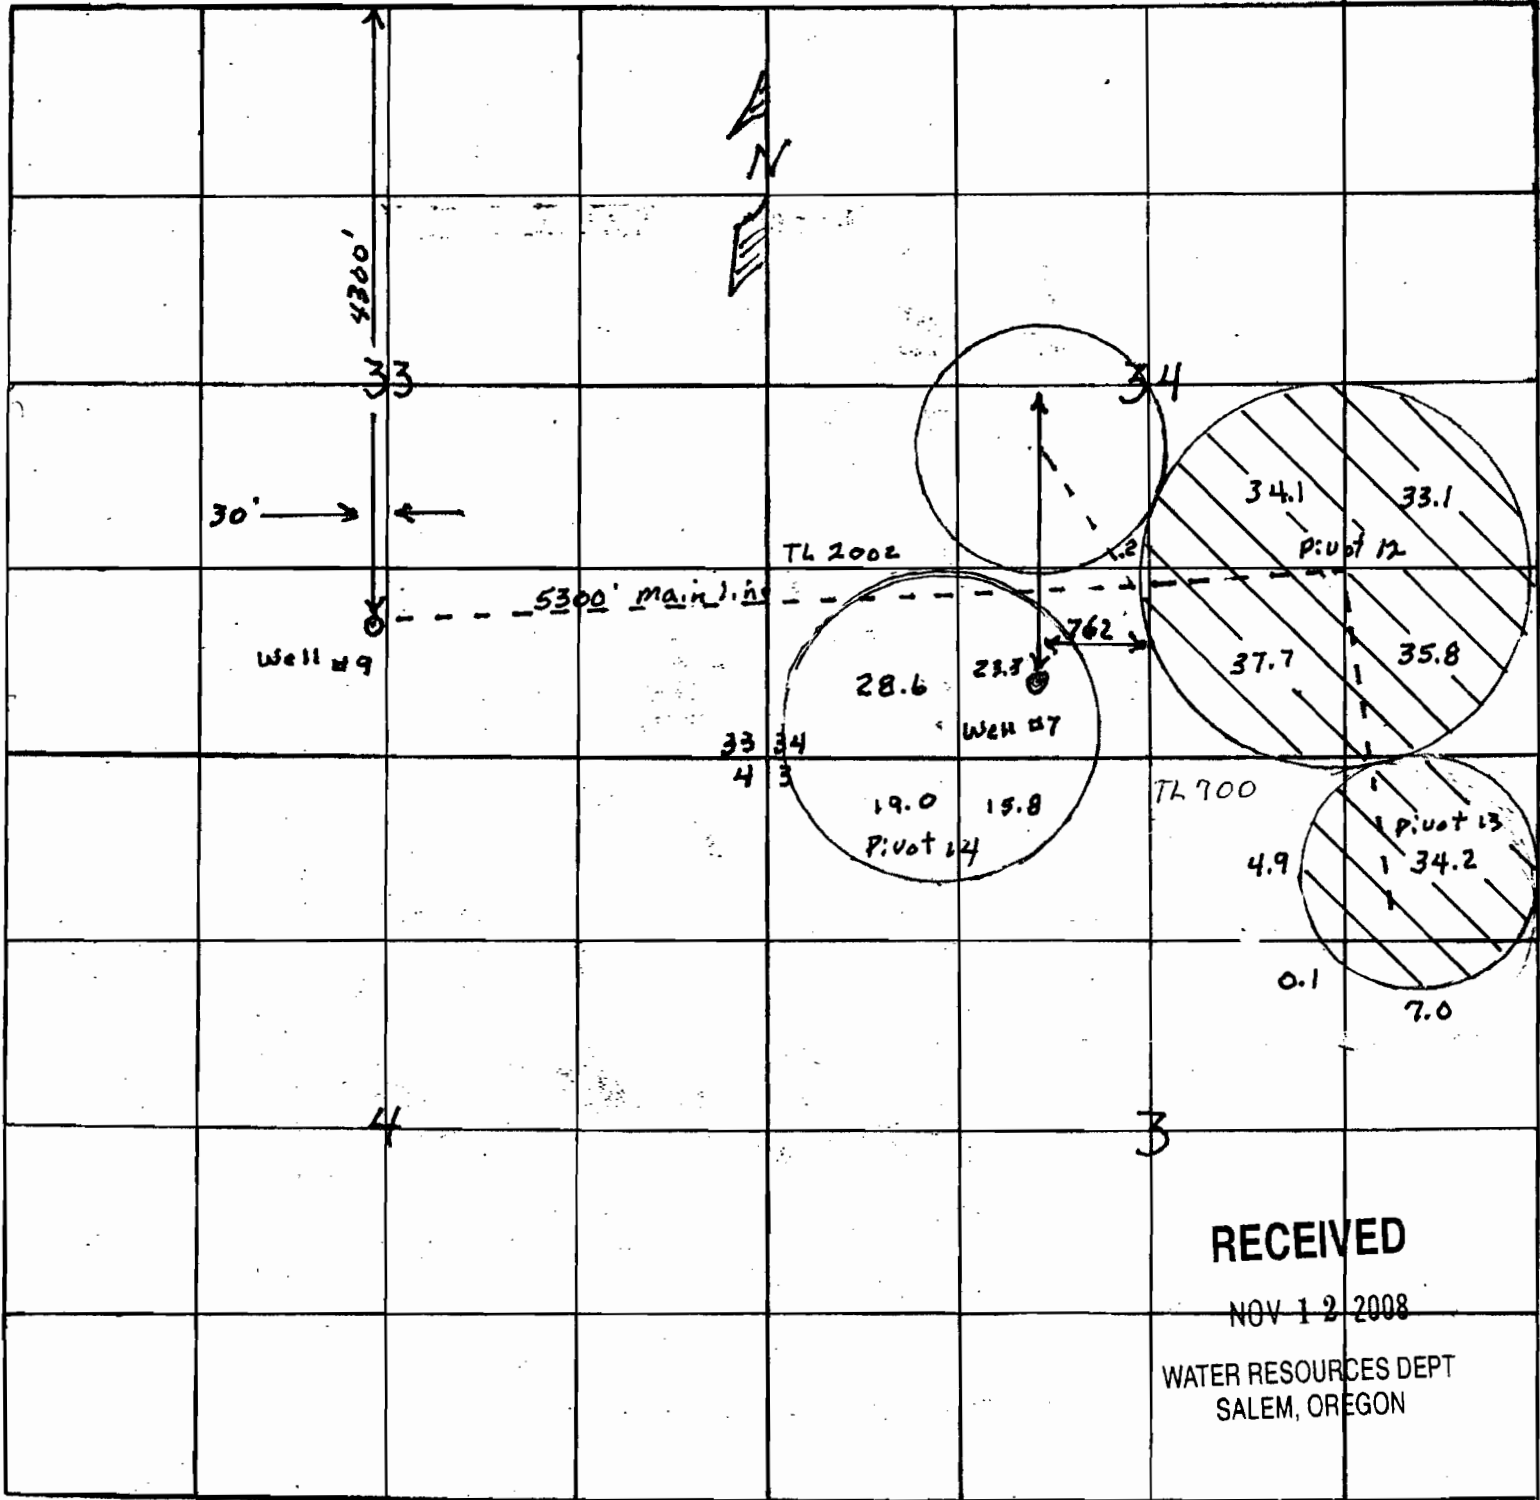

RECEIVED

NOV 12 2008

WATER RESOURCES DEPT  
SALEM, OREGON

Remarks scale - 8" = 1 mile - 660' -

Well #9 will replace well #7 To irrigate  
Pivots #12 and #13

T 10725

Transfer POA