


T5N, R35E, WM
Sections 3, 4, 5, 8, 9, 10
T6N, R35E, WM
Sections 31 and 32
UMATILLA COUNTY

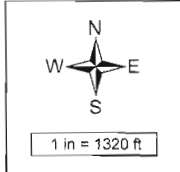

NOTES
The partial diminishments and cancellations indicated on this map were required in order to amend the Authorized Place of Use for Permit G-15883 (Application G-16322). The associated Permit Amendment is referred to as Transfer 10777.

- PLACE OF USE**
- Diminish Cert 2180**
T5N, R35E, Sec 31, NE SE, 2.1 acres (diminish)
T6N, R35E, Sec 31, SE SE, 21.1 acres (diminish)
T6N, R35E, Sec 32, SW SW, 11.4 acres (diminish)
 - Cancel Cert 2180**
T5N, R35E, Sec 31, NE SE, 2.1 acres (cancel)
T6N, R35E, Sec 31, SE SE, 21.1 acres (cancel)
T6N, R35E, Sec 32, SW SW, 11.4 acres (cancel)
 - Diminish Cert 5539**
T5N, R35E, Sec 32, SE SW, 4.1 acres (diminish)
 - Cancel Cert 5539**
T5N, R35E, Sec 32, SE SW, 4.1 acres (cancel)
 - Diminish Cert 22860**
T5N, R35E, Sec 5, NW NE, 18.3 acres (diminish)
T5N, R35E, Sec 5, NE NW, 5.2 acres (diminish)
T5N, R35E, Sec 5, NW NW, 2.1 acres (diminish)
 - Cancel Cert 22860**
T5N, R35E, Sec 5, NW NE, 18.3 acres (cancel)
T5N, R35E, Sec 5, NE NW, 5.2 acres (cancel)
T5N, R35E, Sec 5, NW NW, 2.1 acres (cancel)
 - Diminish Cert 31336**
T5N, R35E, Sec 4, SW NW, 0.6 acres (diminish)
T5N, R35E, Sec 4, NW SW, 0.6 acres (diminish)
 - Cancel Cert 31336**
T5N, R35E, Sec 4, SW NW, 0.6 acres (cancel)
T5N, R35E, Sec 4, NW SW, 0.6 acres (cancel)
 - Diminish Cert 44557**
T5N, R35E, Sec 4, SW NW, 0.0 acres (diminish)
T5N, R35E, Sec 4, NW SW, 0.0 acres (diminish)
T5N, R35E, Sec 5, NE NE, 29.0 acres (diminish)
T5N, R35E, Sec 5, SW NE, 0.0 acres (diminish)
T5N, R35E, Sec 5, NW NE, 12.0 acres (diminish)
T5N, R35E, Sec 5, SE NE, 36.7 acres (diminish)
T5N, R35E, Sec 5, SE SW, 23.5 acres (diminish)
T5N, R35E, Sec 5, NE NW, 0.0 acres (diminish)
T5N, R35E, Sec 5, NW NW, 3.0 acres (diminish)
T5N, R35E, Sec 5, SW NW, 8.2 acres (diminish)
T5N, R35E, Sec 5, SE NW, 3.2 acres (diminish)
 - Cancel Cert 44557**
T5N, R35E, Sec 4, SW NW, 1.2 acres (cancel)
T5N, R35E, Sec 4, NW SW, 3.5 acres (cancel)
T5N, R35E, Sec 5, NE NE, 4.4 acres (cancel)
T5N, R35E, Sec 5, NW NE, 5.9 acres (cancel)
T5N, R35E, Sec 5, SW NE, 0.0 acres (cancel)
T5N, R35E, Sec 5, SE NE, 8.5 acres (cancel)
T5N, R35E, Sec 5, NE NW, 1.3 acres (cancel)
T5N, R35E, Sec 5, NW NW, 30.2 acres (cancel)
T5N, R35E, Sec 5, SW NW, 3.0 acres (cancel)
T5N, R35E, Sec 5, SE NW, 5.3 acres (cancel)

The purpose of this map is to identify the location of a water right. It is not intended to provide information regarding the location of property ownership lines.

FOUNTAINHEAD
1204 Alvarado Terrace
Walla Walla, WA 99362
(509) 529-2646 phone




DIMINISHMENT/CANCELLATION
of Water Rights Related To
Application G-16322
Permit G-15883
SEVEN HILLS PROPERTIES LLC
Revised 23 JUN 2009

R34E
R35E


36 31
1 6

T5N, R35E, WM
Sections 3, 4, 5, 8, 9, 10
T6N, R35E, WM
Sections 31 and 32
UMATILLA COUNTY




1 in = 1320 ft

PROPOSED CHANGES TO PLACE OF USE

 **Authorized POU (No Change)**
No changes proposed to Authorized Place of Use under this Permit Amendment. Permit Holder intends to apply for changes to Authorized Place of Use under separate, related Permit Amendments.

PROPOSED CHANGES TO POINTS OF APPROPRIATION

- **Authorized POA (No Change)**
POA 3B remains in NW/4 NE/4 S10, T5N, R35E, WM at a location 666 feet S and 1761 feet W from NE Corner S10.
POA 4B remains in NE/4 NE/4 S9, T5N, R35E, WM at a location 800 feet W and 380 feet S from NE Corner S9.
POA 5A remains in SW/4 NE/4 S5, T5N, R35E, WM at a location 61 feet N and 1292 feet E from Center S5.
POA 5B remains in SE/4 NE/4 S5, T5N, R35E, WM at a location 1090 feet W and 1615 feet S from NE Corner S5.
POA 5C remains in SE/4 SW/4 S32, T6N, R35E, WM at a location 612 feet N and 1985 feet E from SW Corner S32.
UMAT 50516 remains in NE/4 NW/4 S4, T5N, R35E, WM at a location 335 feet S and 1516 feet E from NW Corner S4.
- **Authorized POA (Change FROM)**
POA 3A relocate from SW/4 SE/4, S3, T6N, R35E, WM, 2900 feet E and 1225 feet N from SW Corner S3.
POA 4A relocate from NE/4 SW/4, S4, T6N, R35E, WM, 2960 feet S and 3140 feet W from NE Corner S4.
- **Proposed POA (Change TO)**
POA 3A relocate to SW/4 SE/4, S3, T6N, R35E, WM at a location 1156 feet N and 314 feet E from S/4 Corner S3 (Well Log UMAT 55526).
POA 4A relocate to NE/4 SW/4, S4, T6N, R35E, WM at a location 415 feet S and 500 feet W from Center S4 (Well Log UMAT 55523).
- **Proposed POA (Additional)**
POA 4C in NW/4 SW/4, S4, T6N, R35E, WM at a location 50 feet S and 1400 feet W from Center S4 (new, additional potential well site).
POA 4D in NE/4 SW/4, S4, T6N, R35E, WM at a location 375 feet S and 940 feet W from Center S4 (new, additional potential well site).
POA 4E in NW/4 NW/4, S4, T6N, R35E, WM at a location 335 feet S and 1466 feet E from NW Corner S4 (potential replacement of well UMAT 50516).

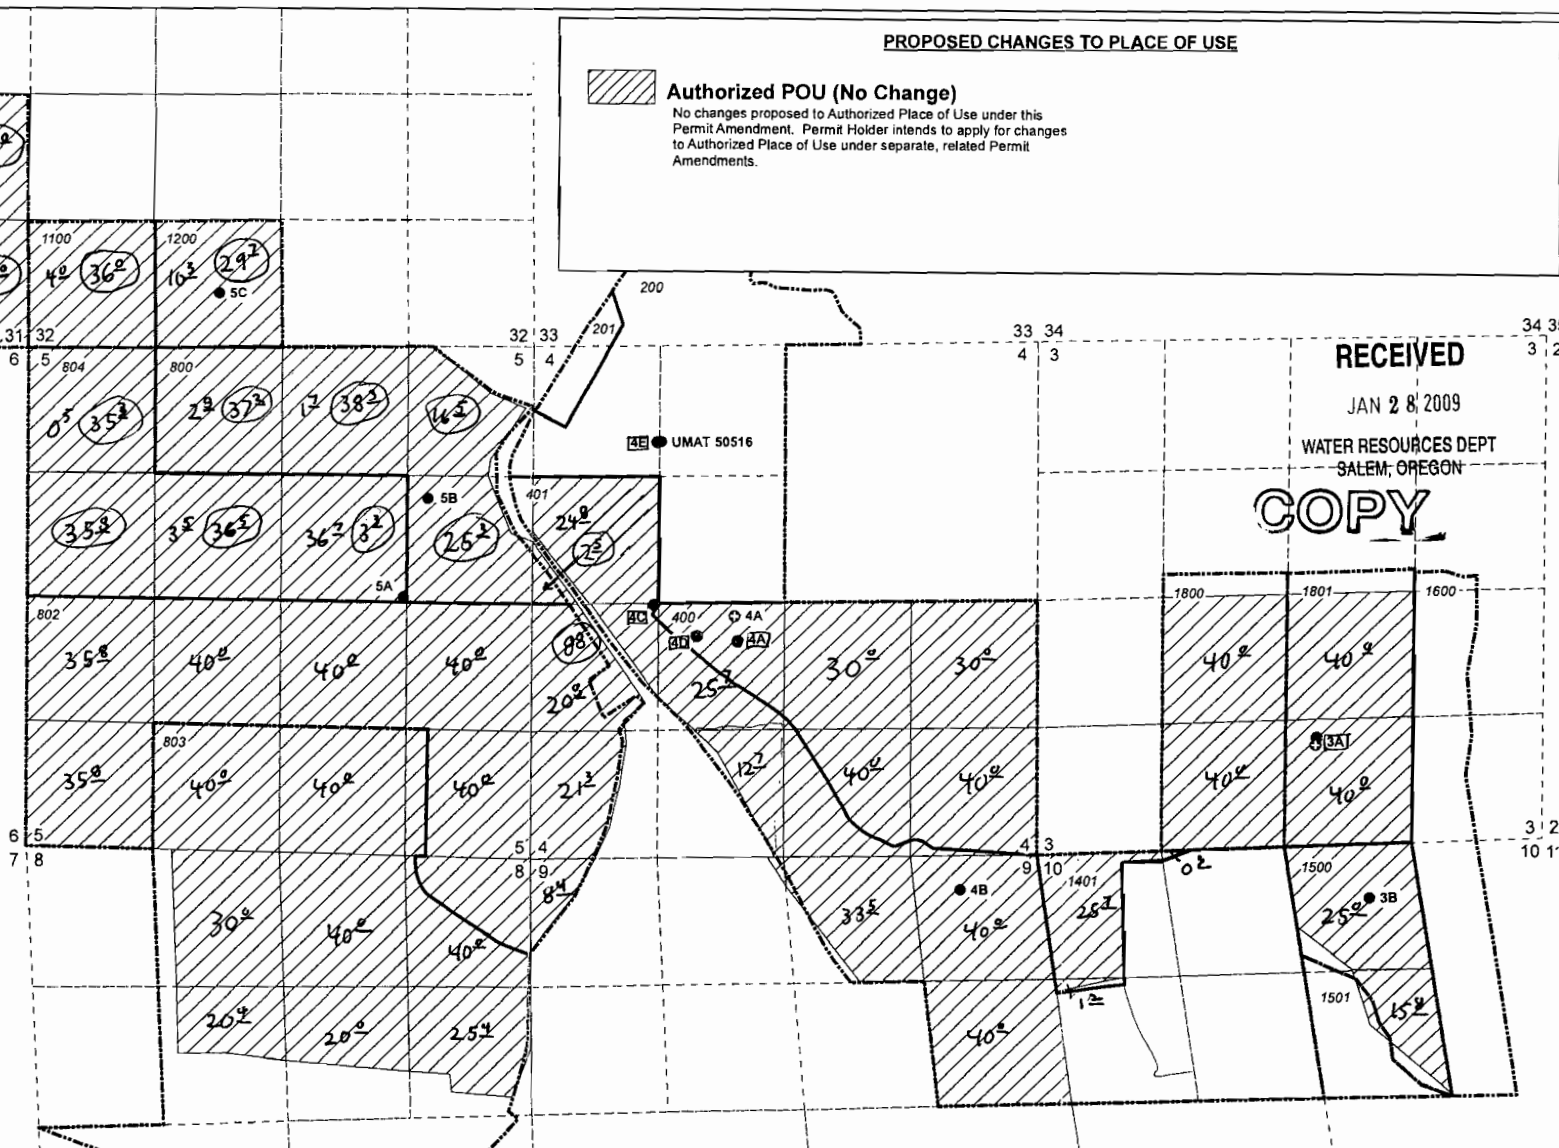

RECEIVED

JAN 28 2009

WATER RESOURCES DEPT
SALEM, OREGON

COPY

T 10777

The purpose of this map is to identify the location of a water right. It is not intended to provide information regarding the location of property ownership lines.

FOUNTAINHEAD
1204 Alvarado Terrace
Walla Walla, WA 99362
(509) 529-2646 phone

Certified Water Right Examiner
358
John S. Wariner
John S. Wariner
May 18, 1993
STATE OF OREGON

PERMIT AMENDMENT MAP
Application G-16322
Permit G-15883
SEVEN HILLS PROPERTIES
POA Location Amendment
Revised 23 JAN 2009