

APPLICATION FOR TRANSFER

CERTIFICATE 82929 & CERTIFICATE 80761

MAP 1 OF 2

SECTIONS 24 AND 25, T26S, R5W, W.M.

Douglas County Oregon

RECEIVED

RECEIVED


JAN 28 2009

WATER RESOURCES DEPT
SALEM, OREGON

RECEIVED

MAY 28 2009

WATER RESOURCES DEPT
SALEM, OREGON

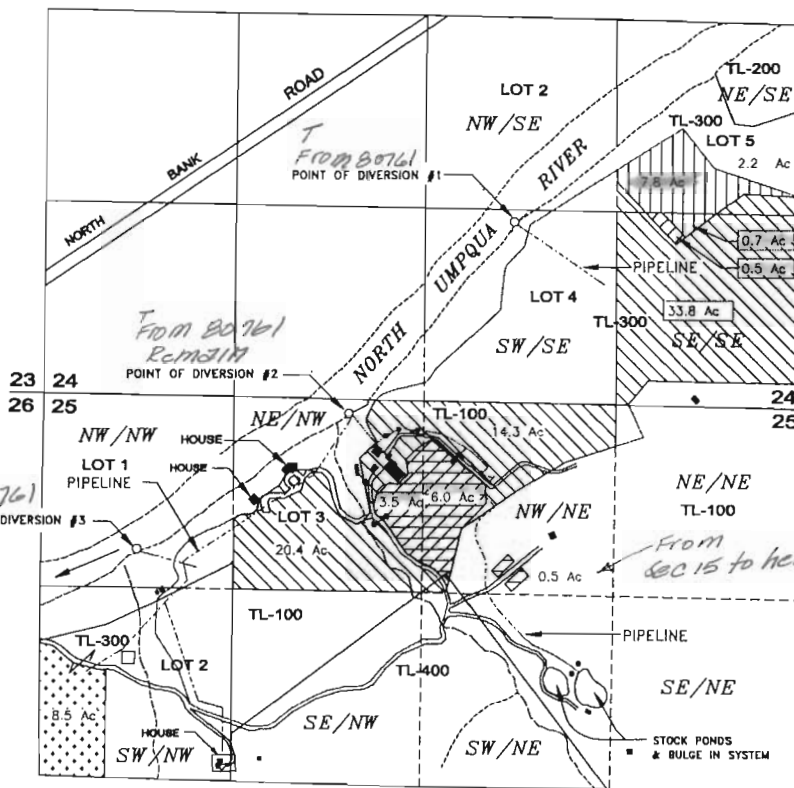

NORTH

Scale

1 inch = 1320 feet

- Point of Diversion #1 - Lot 4, (SW/SE) Section 24, T26S, R5W, W.M.
1240 feet North and 2020 feet West from SE corner section 24
- Point of Diversion #2 - Lot 3 (NE/NW) Section 25, T26S, R5W, W.M.
100 feet South and 3130 feet West from SE corner section 24
- Point of Diversion #3 - Lot 1 (NW/NW) Section 25, T26S, R5W, W.M.
1040 feet South and 4580 feet West from SE corner section 24

APPLICANT:


James W. & Jane P. Ratzlaff
391 Stillwater Road
Roseburg, OR 97470



CERT. 82929 - 10.0 Ac. Transfer "FROM" (See Map 2 of 2 for TO land & POD's)
Change in POD and Place of Use ("FROM" POD 1, 2 & 3)



CERT. 82929 - 8.5 Ac. Transfer "FROM" (TO 8.5 Ac. SW/SW Sec. 25, T26S, R5W, WM)
Change in Place of Use only

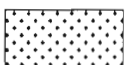

CERT. 82929 - 8.5 Ac. Transfer "TO"
Change in Place of Use only




CERT. 80761 - 10.0 Ac. Transfer "TO" (See Map 2 of 2 for FROM Land)
Change in Place of Use & Point of Diversion ("TO" POD 1, 2 & 3)



CERT. 82929 - Remaining Right in 1/4 1/4's involved in transfer

This map is not intended to provide legal dimensions
or locations of property ownership lines

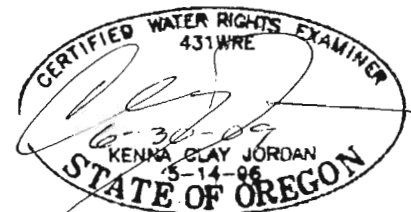

10/1/2008, n.e.d.
Rev.11/23/2008, n.e.d.

JORDAN ENGINEERING
460 JORDAN LANE
ROSEBURG, OR 97471
(541) 673-1931

APPLICATION FOR TRANSFER

CERTIFICATE 82929 & CERTIFICATE 80761

MAP 2 OF 2

TOWNSHIP 26 SOUTH, RANGE 4 WEST, W.M.

Douglas County Oregon

RECEIVED


JAN 20 2009

WATER RESOURCES DEPT
SALEM, OREGON

NORTH

Scale

1 inch = 1320 feet

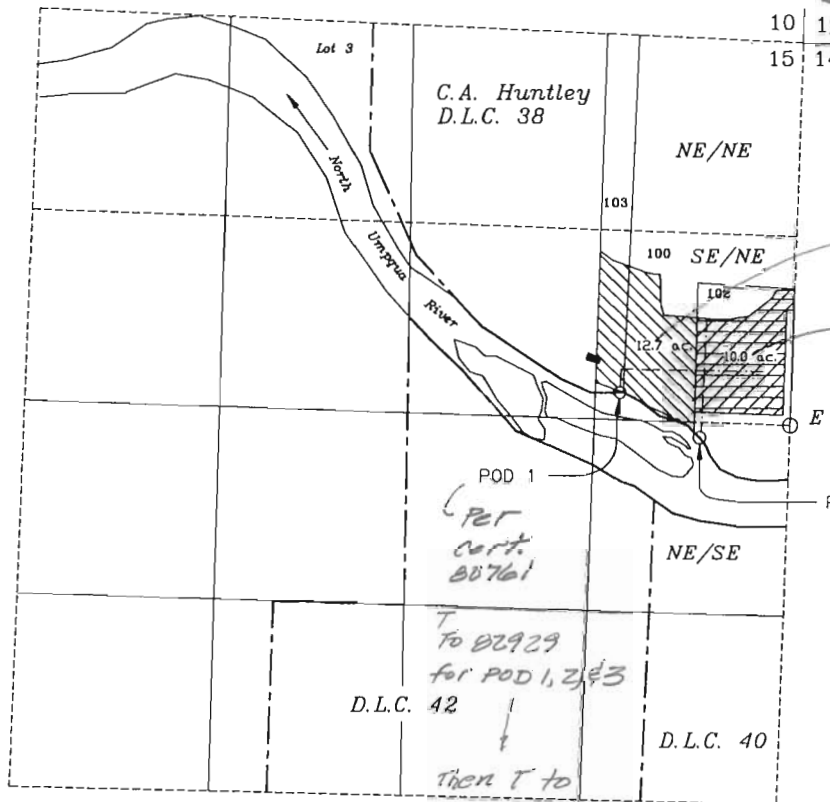

Remain

Transfer

E 1/4 Cor

POD 1

Per
Cert.
80761

POD 2 Per FPM
for 80761

D.L.C. 42

D.L.C. 40

POD 1 & 2
shown on Map 2-2

RECEIVED

MAY 28 2009

WATER RESOURCES DEPT
SALEM, OREGON

This map is not intended to provide legal dimensions
or locations of property ownership lines

POD 1 - SW 1/4, SE/NE, Section 15, 180 feet north & 1170 feet west from the E 1/4 corner section 15

POD 2 - NE/SE, Section 15, 105 feet south & 615 feet west from the E 1/4 corner section 15

Remain (80761) & To (82929)

FROM POD - POD - 1 (See map 1 of 2 for TO POD's, 1, 2 & 3)

TO POD - POD - 1 & 2 (See map 1 of 2 for FROM POD's, 1, 2 & 3)




CERT. 80761 - 10.0 Ac. Transfer "FROM" (See Map 1 of 2 for "TO" Land & POD's)
Change in Place of Use & Point of Diversion



CERT. 82929 - 10.0 Ac. Transfer "TO" (See Map 1 of 2 for "FROM" land & POD's)
T. 26S, R. 5 W., W.M.) Change in Place of Use & Point of Diversion



CERT. 80761 - 12.7 Ac. Remaining Right SE/NE, Section 15

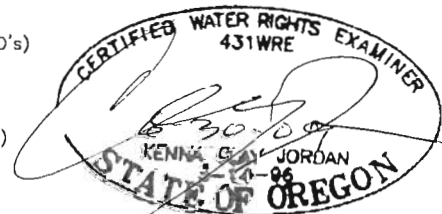

APPLICANT:

James W. & Jane P. Ratzlaff
391 Stillwater Road
Roseburg, OR 97470

10/1/2008, n.e.d.
Rev.11/23/2008, n.e.d.

JORDAN ENGINEERING
460 JORDAN LANE
ROSEBURG, OR 97471
(541) 673-1931

T 10772