


Application No. C-14160
 Permit No. G12814

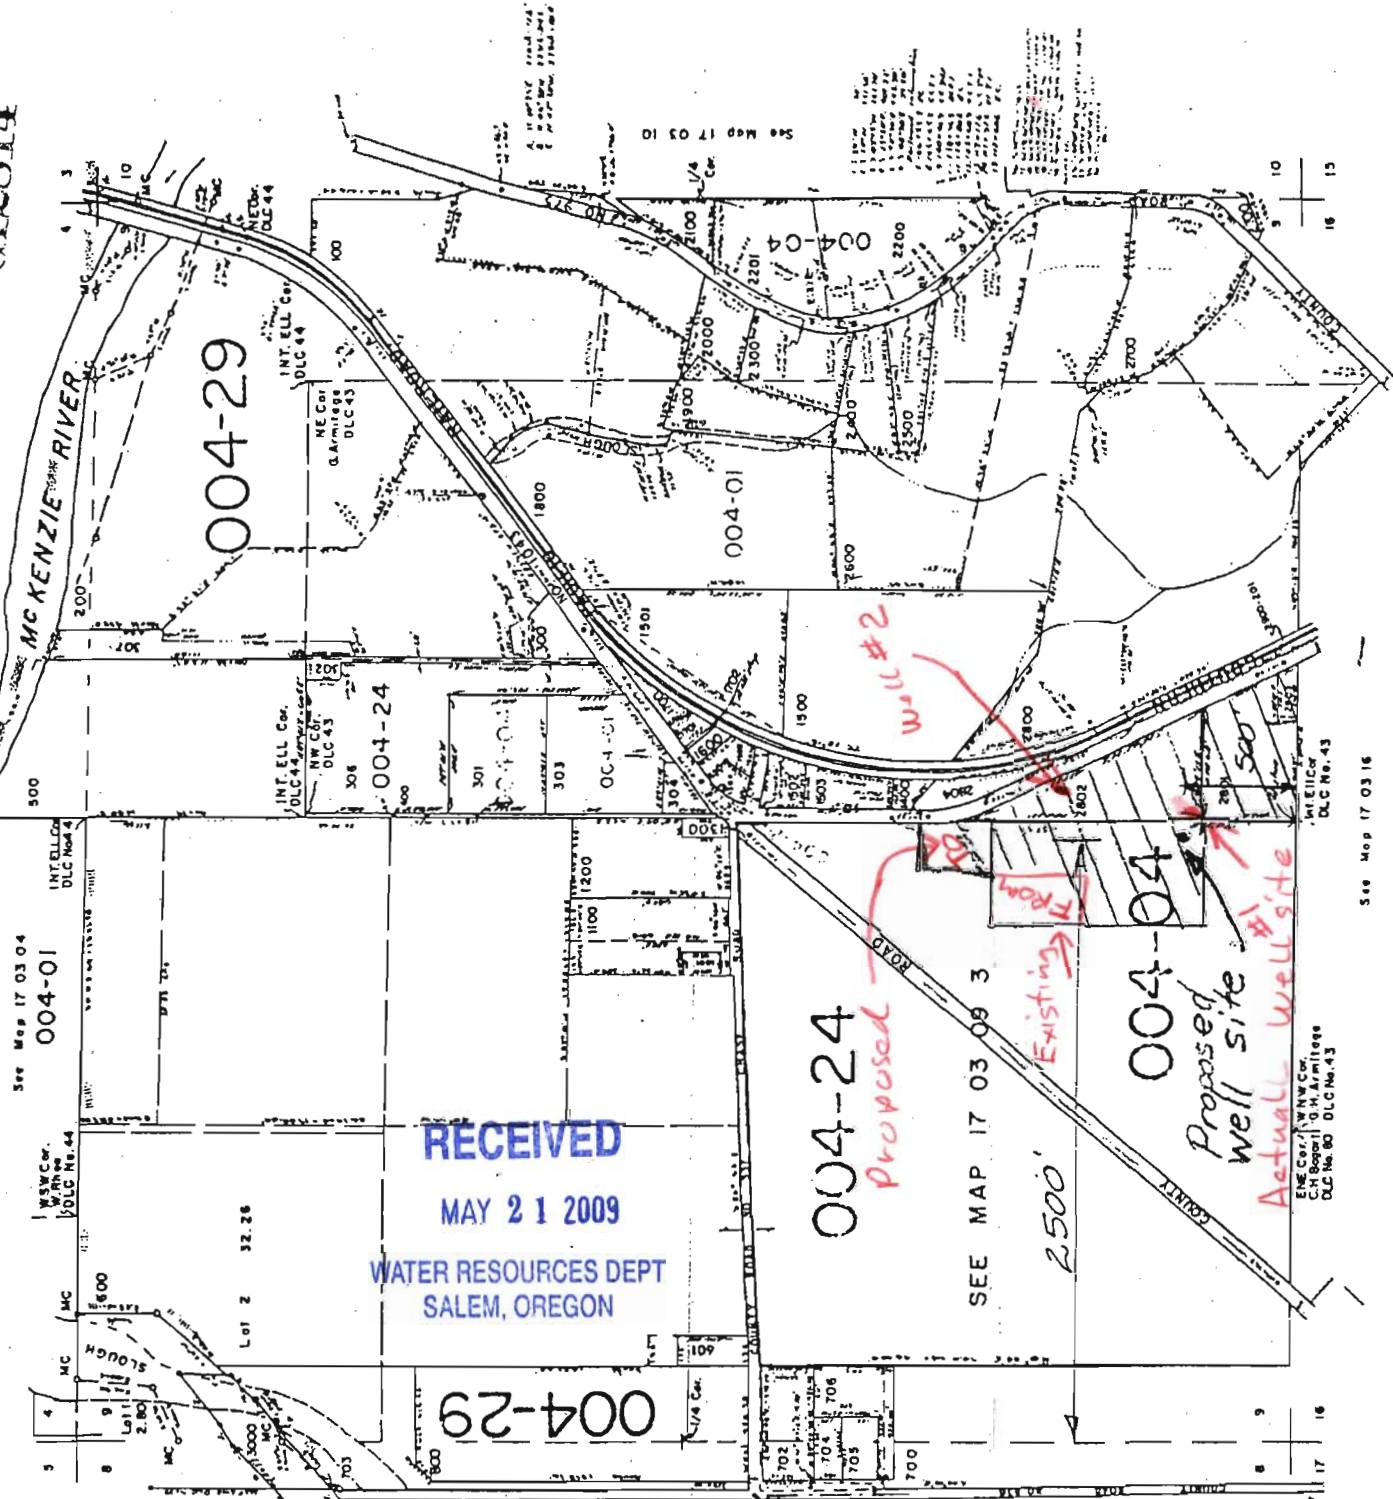


RECEIVED
 MAY 21 2009
 WATER RESOURCES DEPT
 SALEM, OREGON

004-29

004-24

004-01

RECEIVED
 AUG 1 1995
 WATER RESOURCES DEPT
 SALEM, OREGON

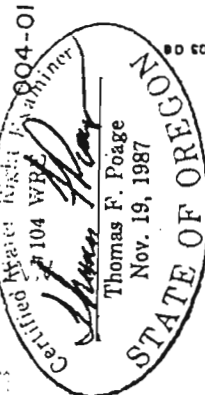

total land 004-29
 area = 22a
 13a in SW 1/4 of SE 1/4
 9a in SE 1/4 of SW 1/4
 of sec 9

Well is 2500'
 East and 500'
 North of the
 south west corner
 of section 9, T17S,
 R.3W of WM

See Map 17 03 16

SEE MAP 17 03 09 3

See Map 17 03 04

INT. ELL. Co.

DLC No. 44

004-01


























