


TOTAL 250 AF
 DAM IN EXCESS OF 10' HIGH: R-84324
 IS PERMIT AMENDMENT NEEDED TO BUILD RES. AND
 WE KNOW NEW PERMIT IS NEEDED FOR ENLARGED
 REMOVAL TIME EXTENSION
 MAY BE NEEDED
 SLIGHTLY NEW

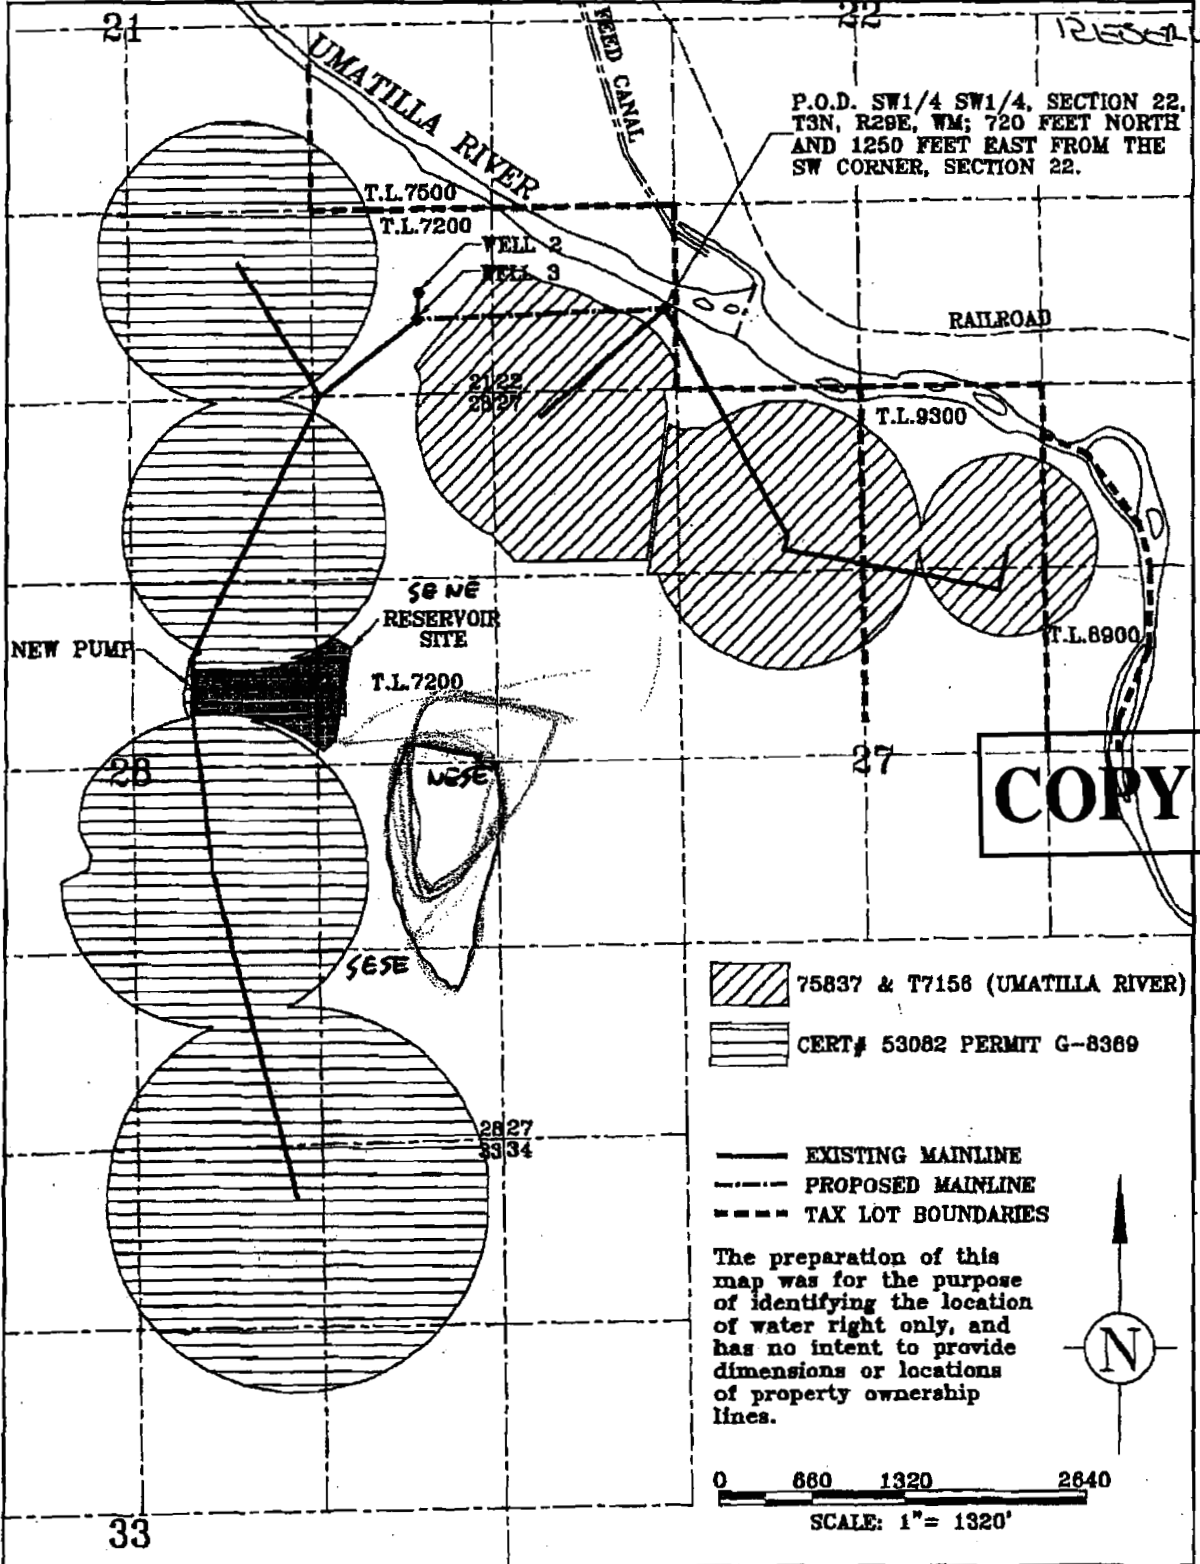

COPY

RECEIVED

RON HOLEMAN RESERVOIR APPLICATION
T.3N. R.29E. W.M.

DEC 27 1999

T 10945

WATER RESOURCES DEPT.
 SALEM, OREGON