





D. Henderson D.L.C. 46

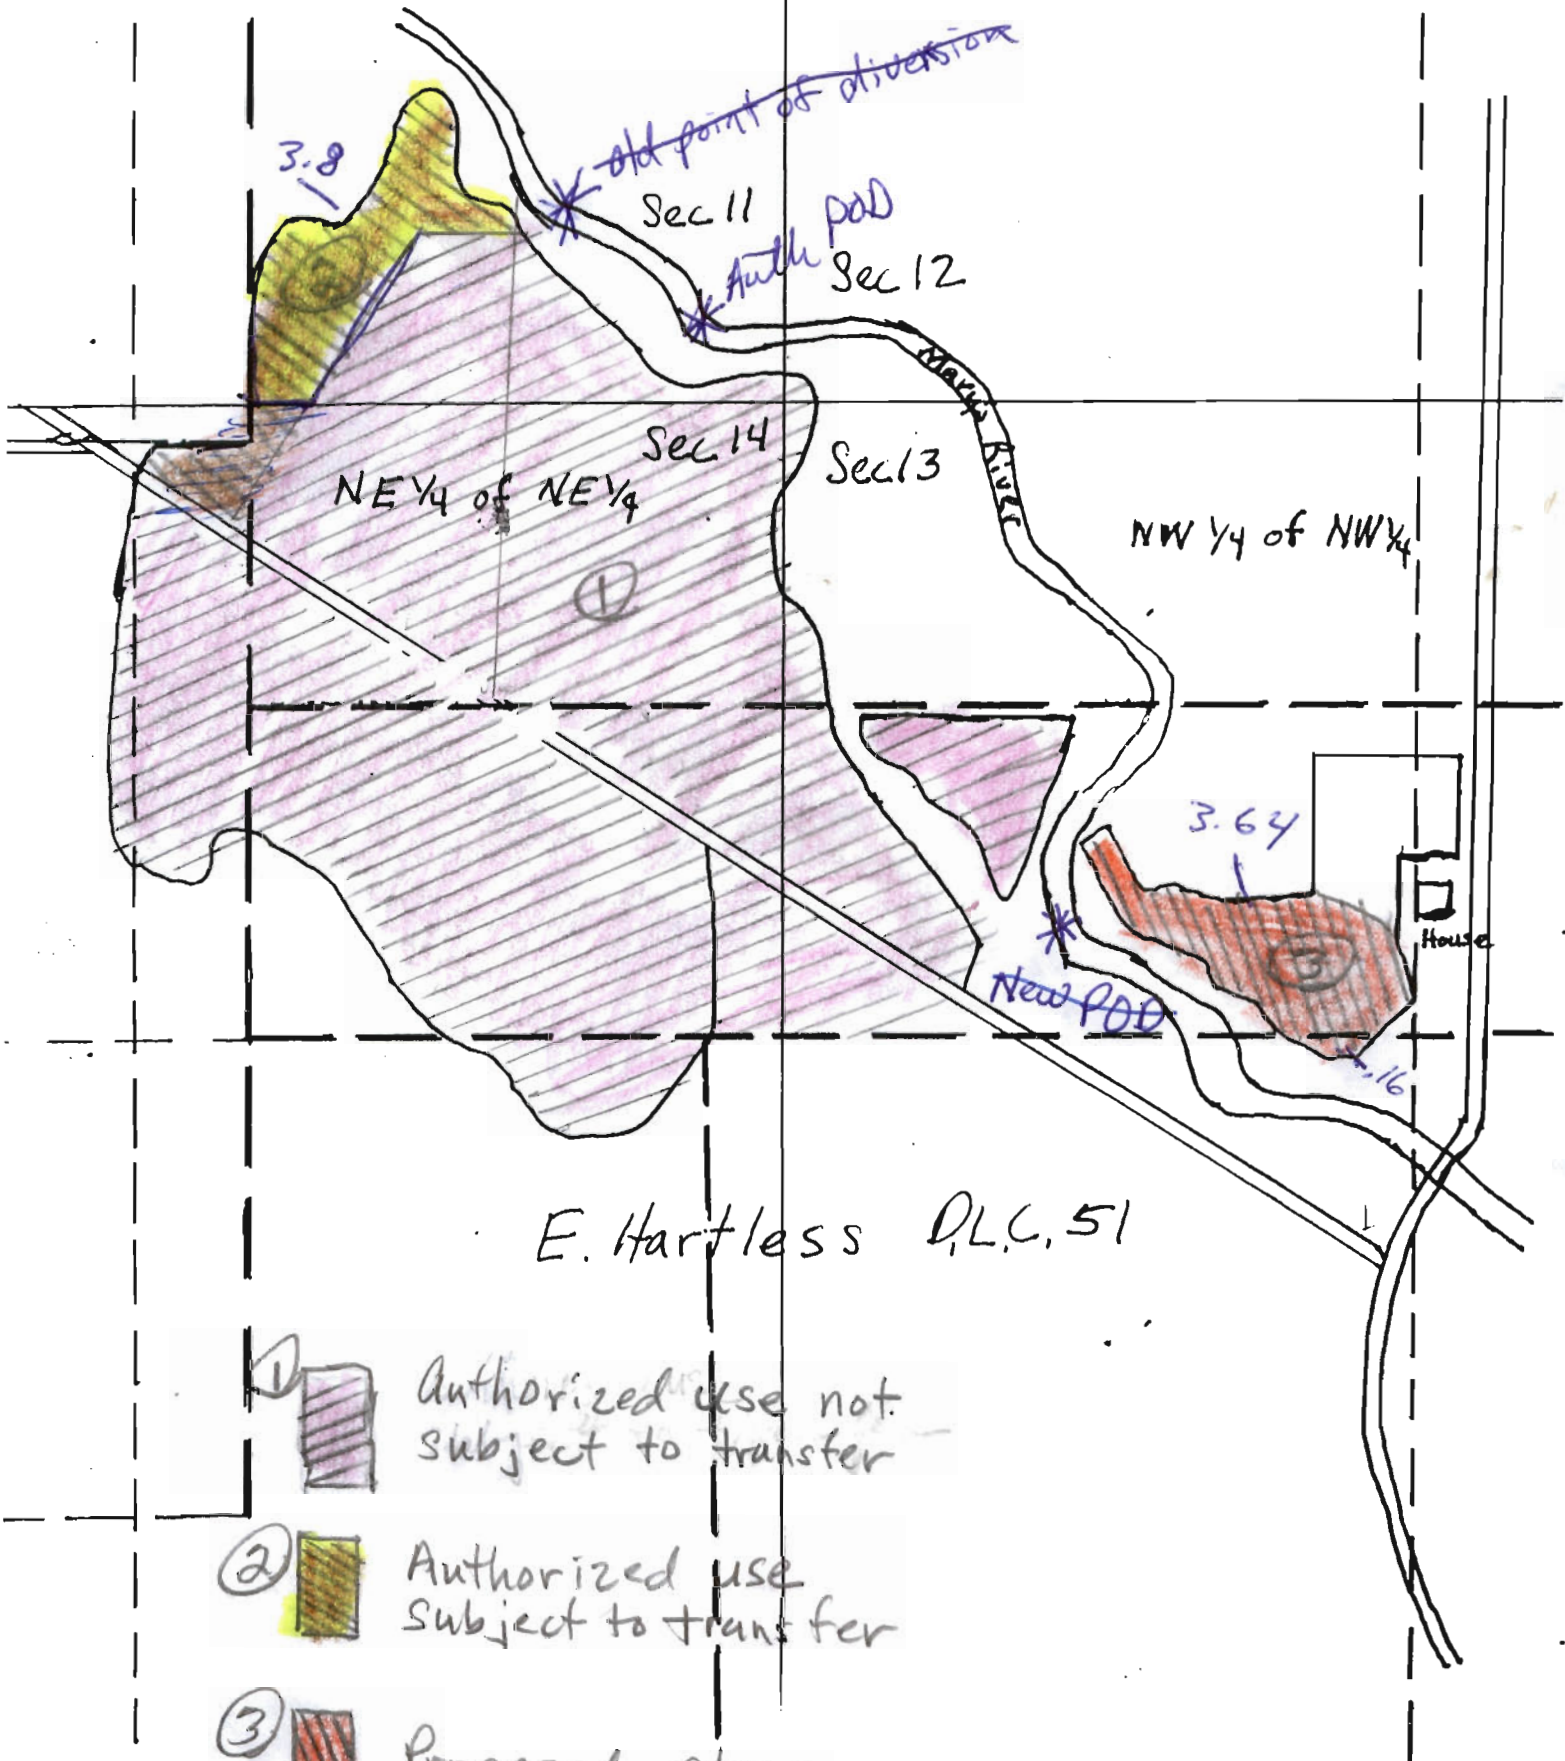

E. Hartless D.L.C. 51

- ①  Authorized use not subject to transfer
- ②  Authorized use subject to transfer
- ③  Proposed place of use

T125 R6W

T 11058

RECEIVED

APR 07 2010

WATER RESOURCES DEPT
SALEM, OREGON



1" =
400'