


Application Map for J.C. Smith Temporary Transfer in Place of Use and Point of Diversion

T. 13S R. 29E W.M.


 1 inch = 1320 feet

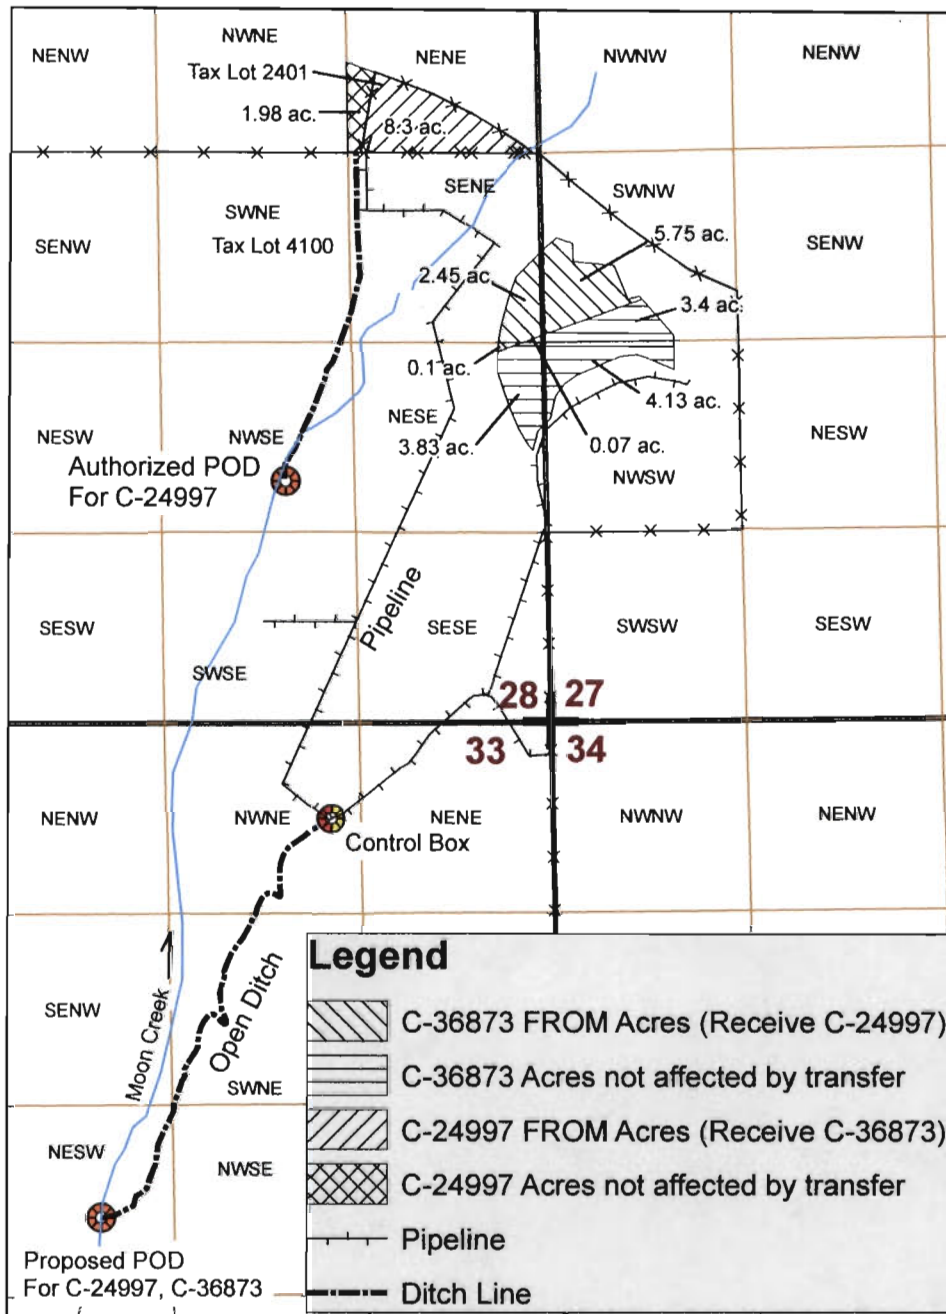

Authorized POD for C-24997 is located approximately :
 1660 feet N and 1780 W of the SE corner of section 28,
 T. 13S R. 29E W.M. being within the NWSE of Section 28, T. 13S R. 29E W.M.

Proposed POD for C-24997 and C-36873 is located approximately :
 3380 feet S and 3130 feet W of the SE corner of section 28, T. 13S R. 29E W.M.
 being within the NESW of Section 33,
 T. 13S R. 29E W.M.

T 11082

RECEIVED

MAY 27 2010


WATER RESOURCES DEPT
 SALEM, OREGON

THIS MAP WAS PREPARED FOR ASSESSMENT PURPOSE ONLY

I, J.S. K. 29E, W. 1/4, GRANT COUNTY SEE MAP 125 29E

1" = 2000'

13S29E

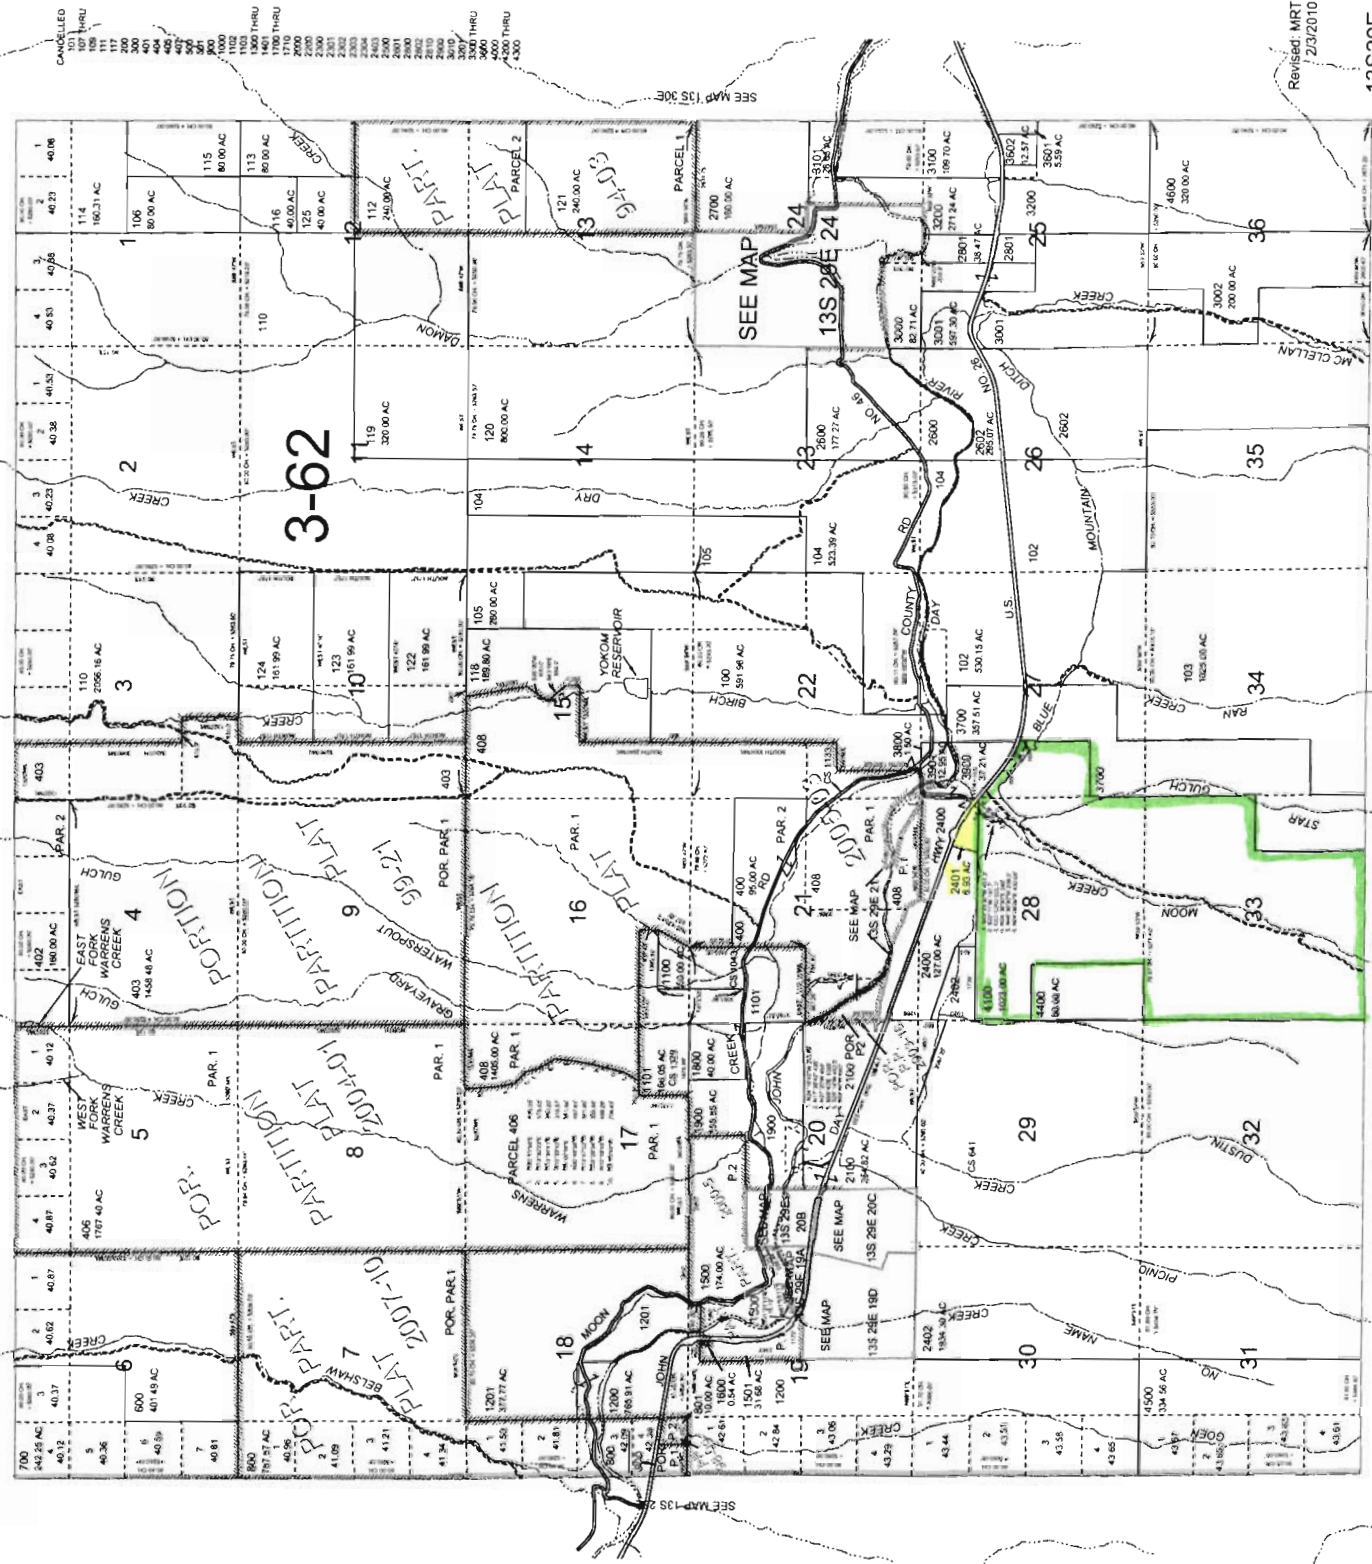

CANCELLED
 101 THRU 107
 108 THRU 114
 115
 116
Revised: MRT 2/3/2010

13S29E

SEE MAP 14S 29E

11082

RECEIVED
 MAY 27 2010
 WATER RESOURCES DEPT
 SALEM, OREGON

STATE OF OREGON
COUNTY OF GRANT
CERTIFICATE OF WATER RIGHT

This Is to Certify, That **UNA POPE**

of **Mt. Vernon**, State of **Oregon**, has made proof to the satisfaction of the STATE ENGINEER of Oregon, of a right to the use of the waters of **Moon Creek**

a tributary of **John Day River** for the purpose of irrigation of **51.5 acres**

under Permit No. **27375** of the State Engineer, and that said right to the use of said waters has been perfected in accordance with the laws of Oregon; that the priority of the right hereby confirmed dates from **May 5, 1961**

that the amount of water to which such right is entitled and hereby confirmed, for the purposes aforesaid, is limited to an amount actually beneficially used for said purposes, and shall not exceed **1.29 cubic feet per second**

or its equivalent in case of rotation, measured at the point of diversion from the stream. The point of diversion is located in the **NE $\frac{1}{4}$ SW $\frac{1}{4}$, Section 33, T. 13 S., R. 29 E., W. M.** Diversion point located: **5980 feet South and 3130 feet West from E $\frac{1}{4}$ Corner, Section 28.**

The amount of water used for irrigation, together with the amount secured under any other right existing for the same lands, shall be limited to **one-fortieth** of one cubic foot per second per acre, or its equivalent for each acre irrigated and shall be further limited to a diversion of not to exceed **4 acre feet per acre** for each acre irrigated during the irrigation season of each year,

and shall conform to a reasonable rotation system as may be ordered by the proper state officer.

A description of the place of use under the right hereby confirmed, and to which such right is appurtenant, is as follows:

**8.6 acres SW $\frac{1}{4}$ NW $\frac{1}{4}$
4.4 acres NW $\frac{1}{4}$ SW $\frac{1}{4}$
Section 27**

**2.8 acres SE $\frac{1}{4}$ NE $\frac{1}{4}$
11.4 acres NE $\frac{1}{4}$ SE $\frac{1}{4}$
0.9 acre NW $\frac{1}{4}$ SE $\frac{1}{4}$
6.6 acres SW $\frac{1}{4}$ SE $\frac{1}{4}$
9.8 acres SE $\frac{1}{4}$ SE $\frac{1}{4}$
Section 28**

**7.0 acres NW $\frac{1}{4}$ NE $\frac{1}{4}$
Section 33
T. 13 S., R. 29 E., W. M.**

RECEIVED

MAY 27 2010

**WATER RESOURCES DEPT
SALEM, OREGON**

The right to the use of the water for the purposes aforesaid is restricted to the lands or place of use herein described.

WITNESS the signature of the State Engineer, affixed

this date. August 3, 1970


CHRIS L. WHEELER

.....
State Engineer

T 11082

T.13S. R.29E. WM.

6
P 27375
36873

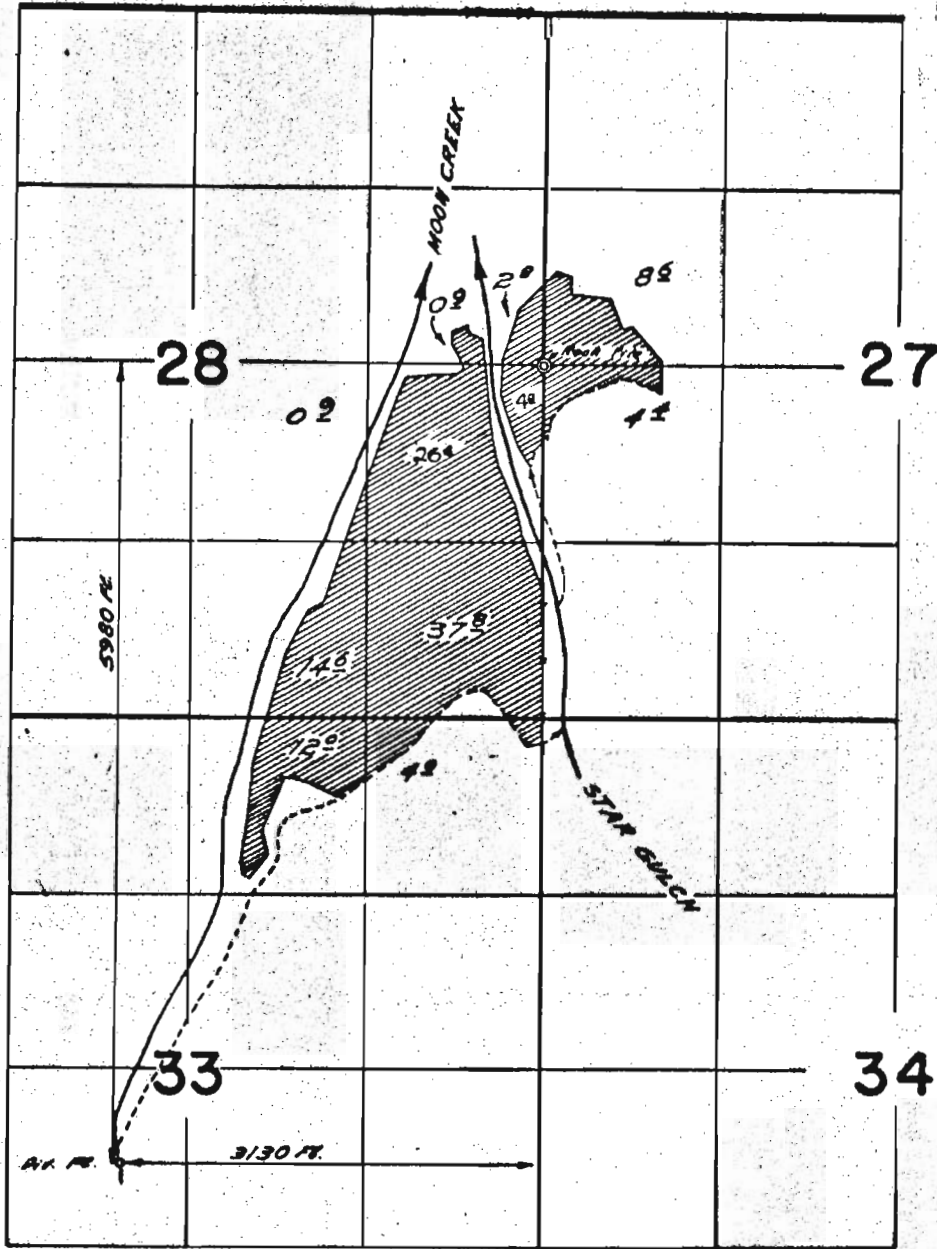

FINAL PROOF SURVEY
UNDER

Application No. 34880. Permit No. 27375
IN NAME OF

UNA POPE

Surveyed July 16 1968, by N. J. Reynolds

RECEIVED

MAY 27 2010

WATER RESOURCES DEPT
SALEM, OREGON

T 11082

1968-W

STATE OF OREGON

COUNTY OF GRANT

CERTIFICATE OF WATER RIGHT

This Is to Certify, That GEORGE CLARK

of Mt. Vernon, State of Oregon, has a right to the use of

the waters of Moon Creek

for the purpose of Irrigation, Domestic and Stock

and that said right has been confirmed by decree of the Circuit Court of the State of Oregon for Grant County, and the said decree entered of record at Salem, in the Order Record of the STATE ENGINEER, in Volume 15, at page 461; that the priority of the right thereby confirmed dates from

- 1872 - Irrigation, domestic and stock - Tract #1
- 1908 - Irrigation, domestic and stock - Tract #2
- 1900 - Irrigation - Tract #3

that the amount of water to which such right is entitled, for the purposes aforesaid, is limited to an amount actually beneficially used for said purposes, and shall not exceed 1/40 cubic foot per second per acre irrigated to June 1 and 1/80 cubic foot per second per acre thereafter; further limited to one acre-foot per calendar month to June 1 and four acre-feet per acre during season April 1 to Sept. 30, measured at point of diversion.

A description of the lands irrigated under such right, and to which the water is appurtenant (or, if for other purposes, the place where such water is put to beneficial use), is as follows:

Tract #1

20 acres in NW 1/4 NE 1/4, 20 acres in NE 1/4 NW 1/4, Section 28, T. 13 S., R. 29 E., W. M.

Tract #2

7.7 acres in NW 1/4 NE 1/4, 11.0 acres in NE 1/4 NW 1/4, 21.8 acres in NW 1/4 NW 1/4, 15.0 acres in NE 1/4 NE 1/4, Section 28, T. 13 S., R. 29 E., W. M.

Tract #3

14.2 acres in NE 1/4 NE 1/4, 2.0 acres in NW 1/4 NE 1/4, Section 28, T. 13 S., R. 29 E., W. M.

RECEIVED

MAY 27 2010

WATER RESOURCES DEPT SALEM, OREGON

And said right shall be subject to all other conditions and limitations contained in said decree. The right to the use of the water for the purposes aforesaid is restricted to the lands or place of use herein described.

WITNESS the signature of the State Engineer, affixed

T 11082

this 1st day of May, 19 59.

LEWIS A. STANLEY

State Engineer

24996

Claflin, Wm. P.,
Box 193,
Prairie City, Oregon.
(Proof No. 235)

1868

Irrigation

Tucker
ditch

John Day
River

19.5 acres in SW $\frac{1}{4}$ SE $\frac{1}{4}$
Section 8
24.8 acres in NW $\frac{1}{4}$ NE $\frac{1}{4}$
13.7 acres in NE $\frac{1}{4}$ NW $\frac{1}{4}$
Section 17,
T. 13 S. R. 34 E. W. M.

1885

4.3 Irrigation

Tucker
ditch

John Day
River

1.2 acres in NW $\frac{1}{4}$ SE $\frac{1}{4}$
3.1 acres in SW $\frac{1}{4}$ SE $\frac{1}{4}$
Section 8,
T. 13 S. R. 34 E. W. M.

24997

Clark, George,
Mt. Vernon, Oregon.
(Proof No. 236)

1872

40 Irrigation
domestic and
stock

Moon Creek
ditch

Moon Creek

20 acres in NW $\frac{1}{4}$ NE $\frac{1}{4}$
20 acres in NE $\frac{1}{4}$ NW $\frac{1}{4}$

1908

55.5 Irrigation
domestic and
stock

Moon Creek
ditch

Moon Creek

7.7 acres in NW $\frac{1}{4}$ NE $\frac{1}{4}$
11 acres in NE $\frac{1}{4}$ NW $\frac{1}{4}$
21.8 acres in NW $\frac{1}{4}$ NW $\frac{1}{4}$
15 acres in NE $\frac{1}{4}$ NE $\frac{1}{4}$
Section 8,
T. 13 S. R. 29 E. W. M.

(See findings paragraph 11, page 25.)

1900

16.2 Irrigation

Lower Moon
Creek
ditch

Moon Creek

14.2 acres in NE $\frac{1}{4}$ ND $\frac{1}{4}$
2 acres in NW $\frac{1}{4}$ NE $\frac{1}{4}$
Section 28,
T. 13 S. R. 29 E. W. M.

(Rights acquired under Permit No. 2887, Certificate 2854.)

Cleaver, Clifton,
Prairie City, Oregon.
(Proof No. 241)

Clifford, H. H.,
975 Mason Street.


RECEIVED

MAY 27 2010

WATER RESOURCES DEPT
SALEM, OREGON

T135 R.29 E W.M.
Adjudicated
Map

W^oT.Mo

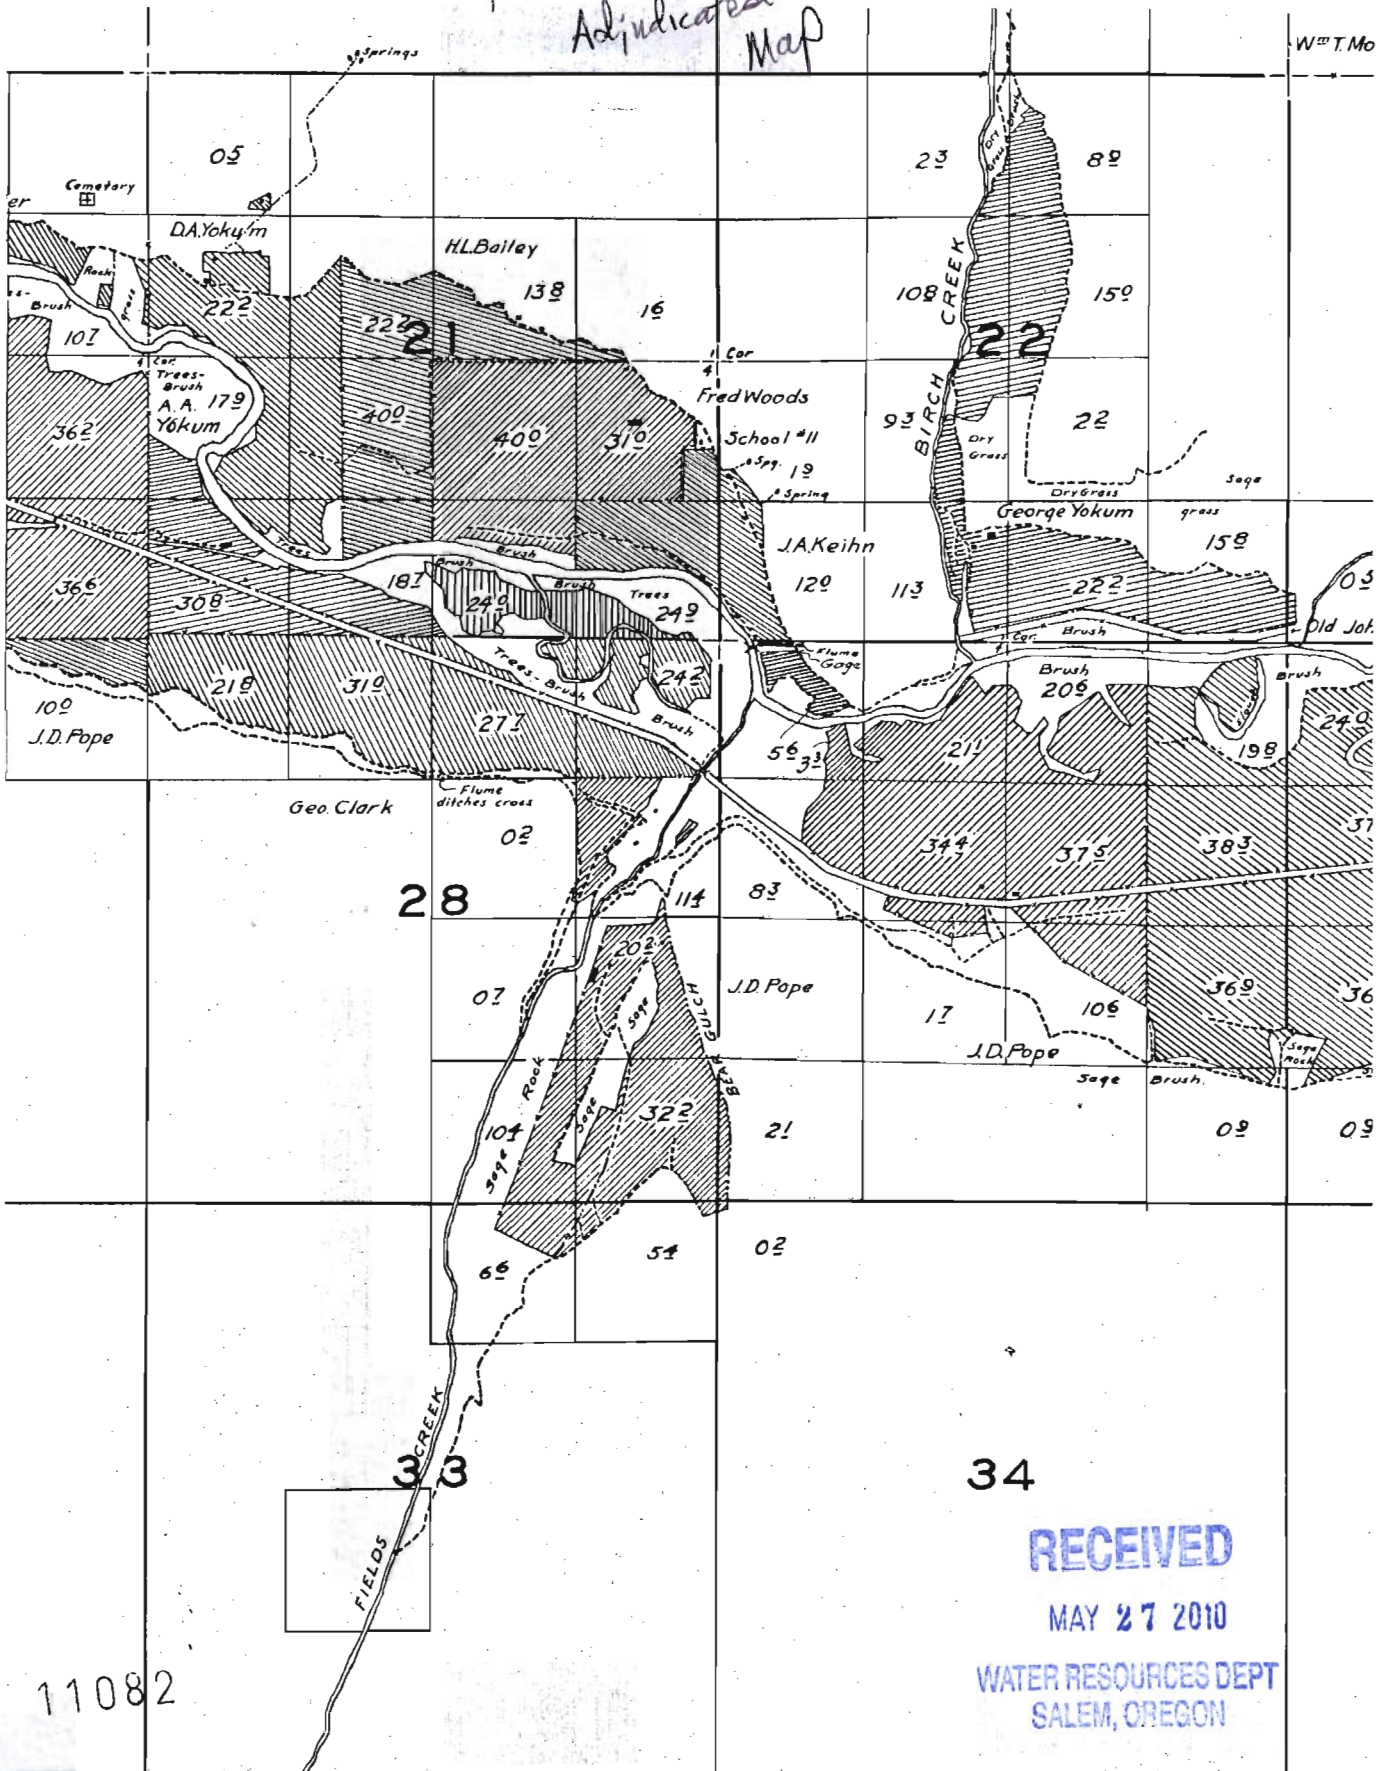

34

RECEIVED

MAY 27 2010

WATER RESOURCES DEPT
SALEM, OREGON

T 11082