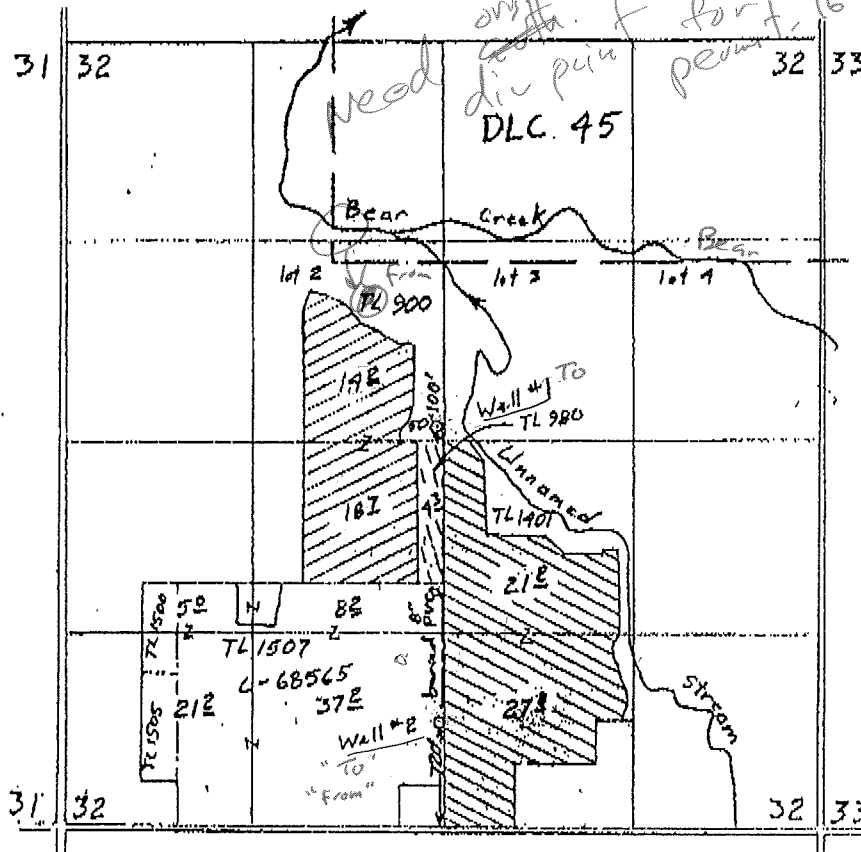


T-8333

TOWNSHIP 4 SOUTH, RANGE 1 EAST, W.M. RECEIVED

SEP 16 1999


AUG 20 1999

WATER RESOURCES DEPT.
SALEM, OREGONWATER RESOURCES DEPT.
SALEM, OREGON

Scale 1" = 1320'

- ⊗ C-68565 ΔPOA from well #2 to well #1
- ⊗ T-6867 (C-20401) ΔPOA from well #1 to well #2
- ⊗ C-68565 ΔPOA supplemental from well #2 to well #1

Transfer Application Map
for
A. JOEL NEUSCHWANDER

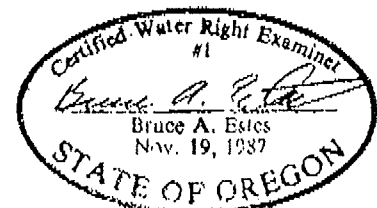

This map is for the purpose of
locating a water right only
and has no intent to provide

ESTES SURVEYS

6293 Sunnyview Pl. NE: 60382 Arnold Rd.