
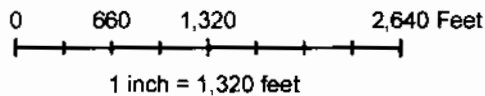


# Historic Point of Diversion Transfer - Peila

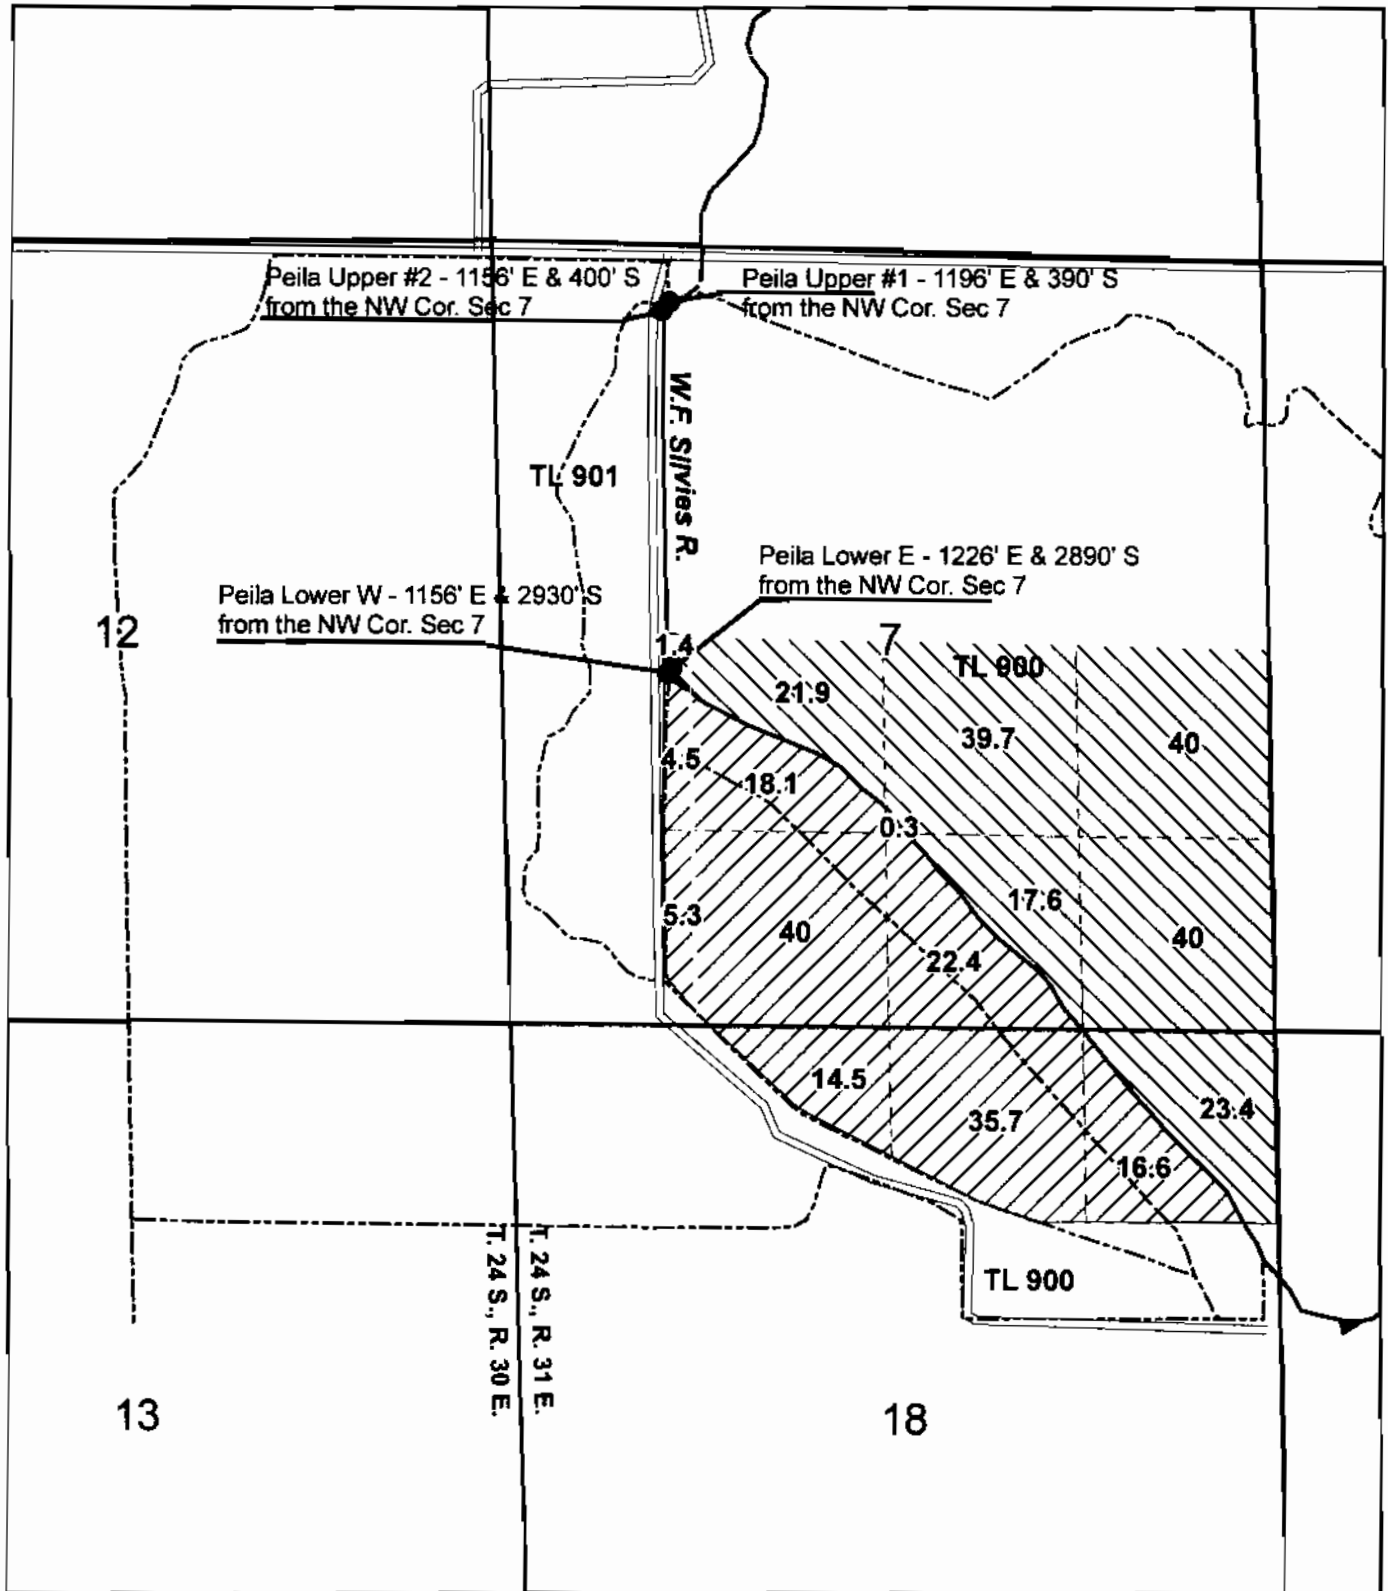



**RECEIVED**

JUN 16 2010

WATER RESOURCES DEPT  
SALEM, OREGON

T 11095

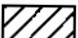-  Peila Upper #2 and adding historic diversion Peila Lower W
-  Peila Upper #1 and adding historic diversion Peila Lower E