


SECTION 36, T.1 S., R.3 W. W.M.
WASHINGTON COUTNY, OREGON

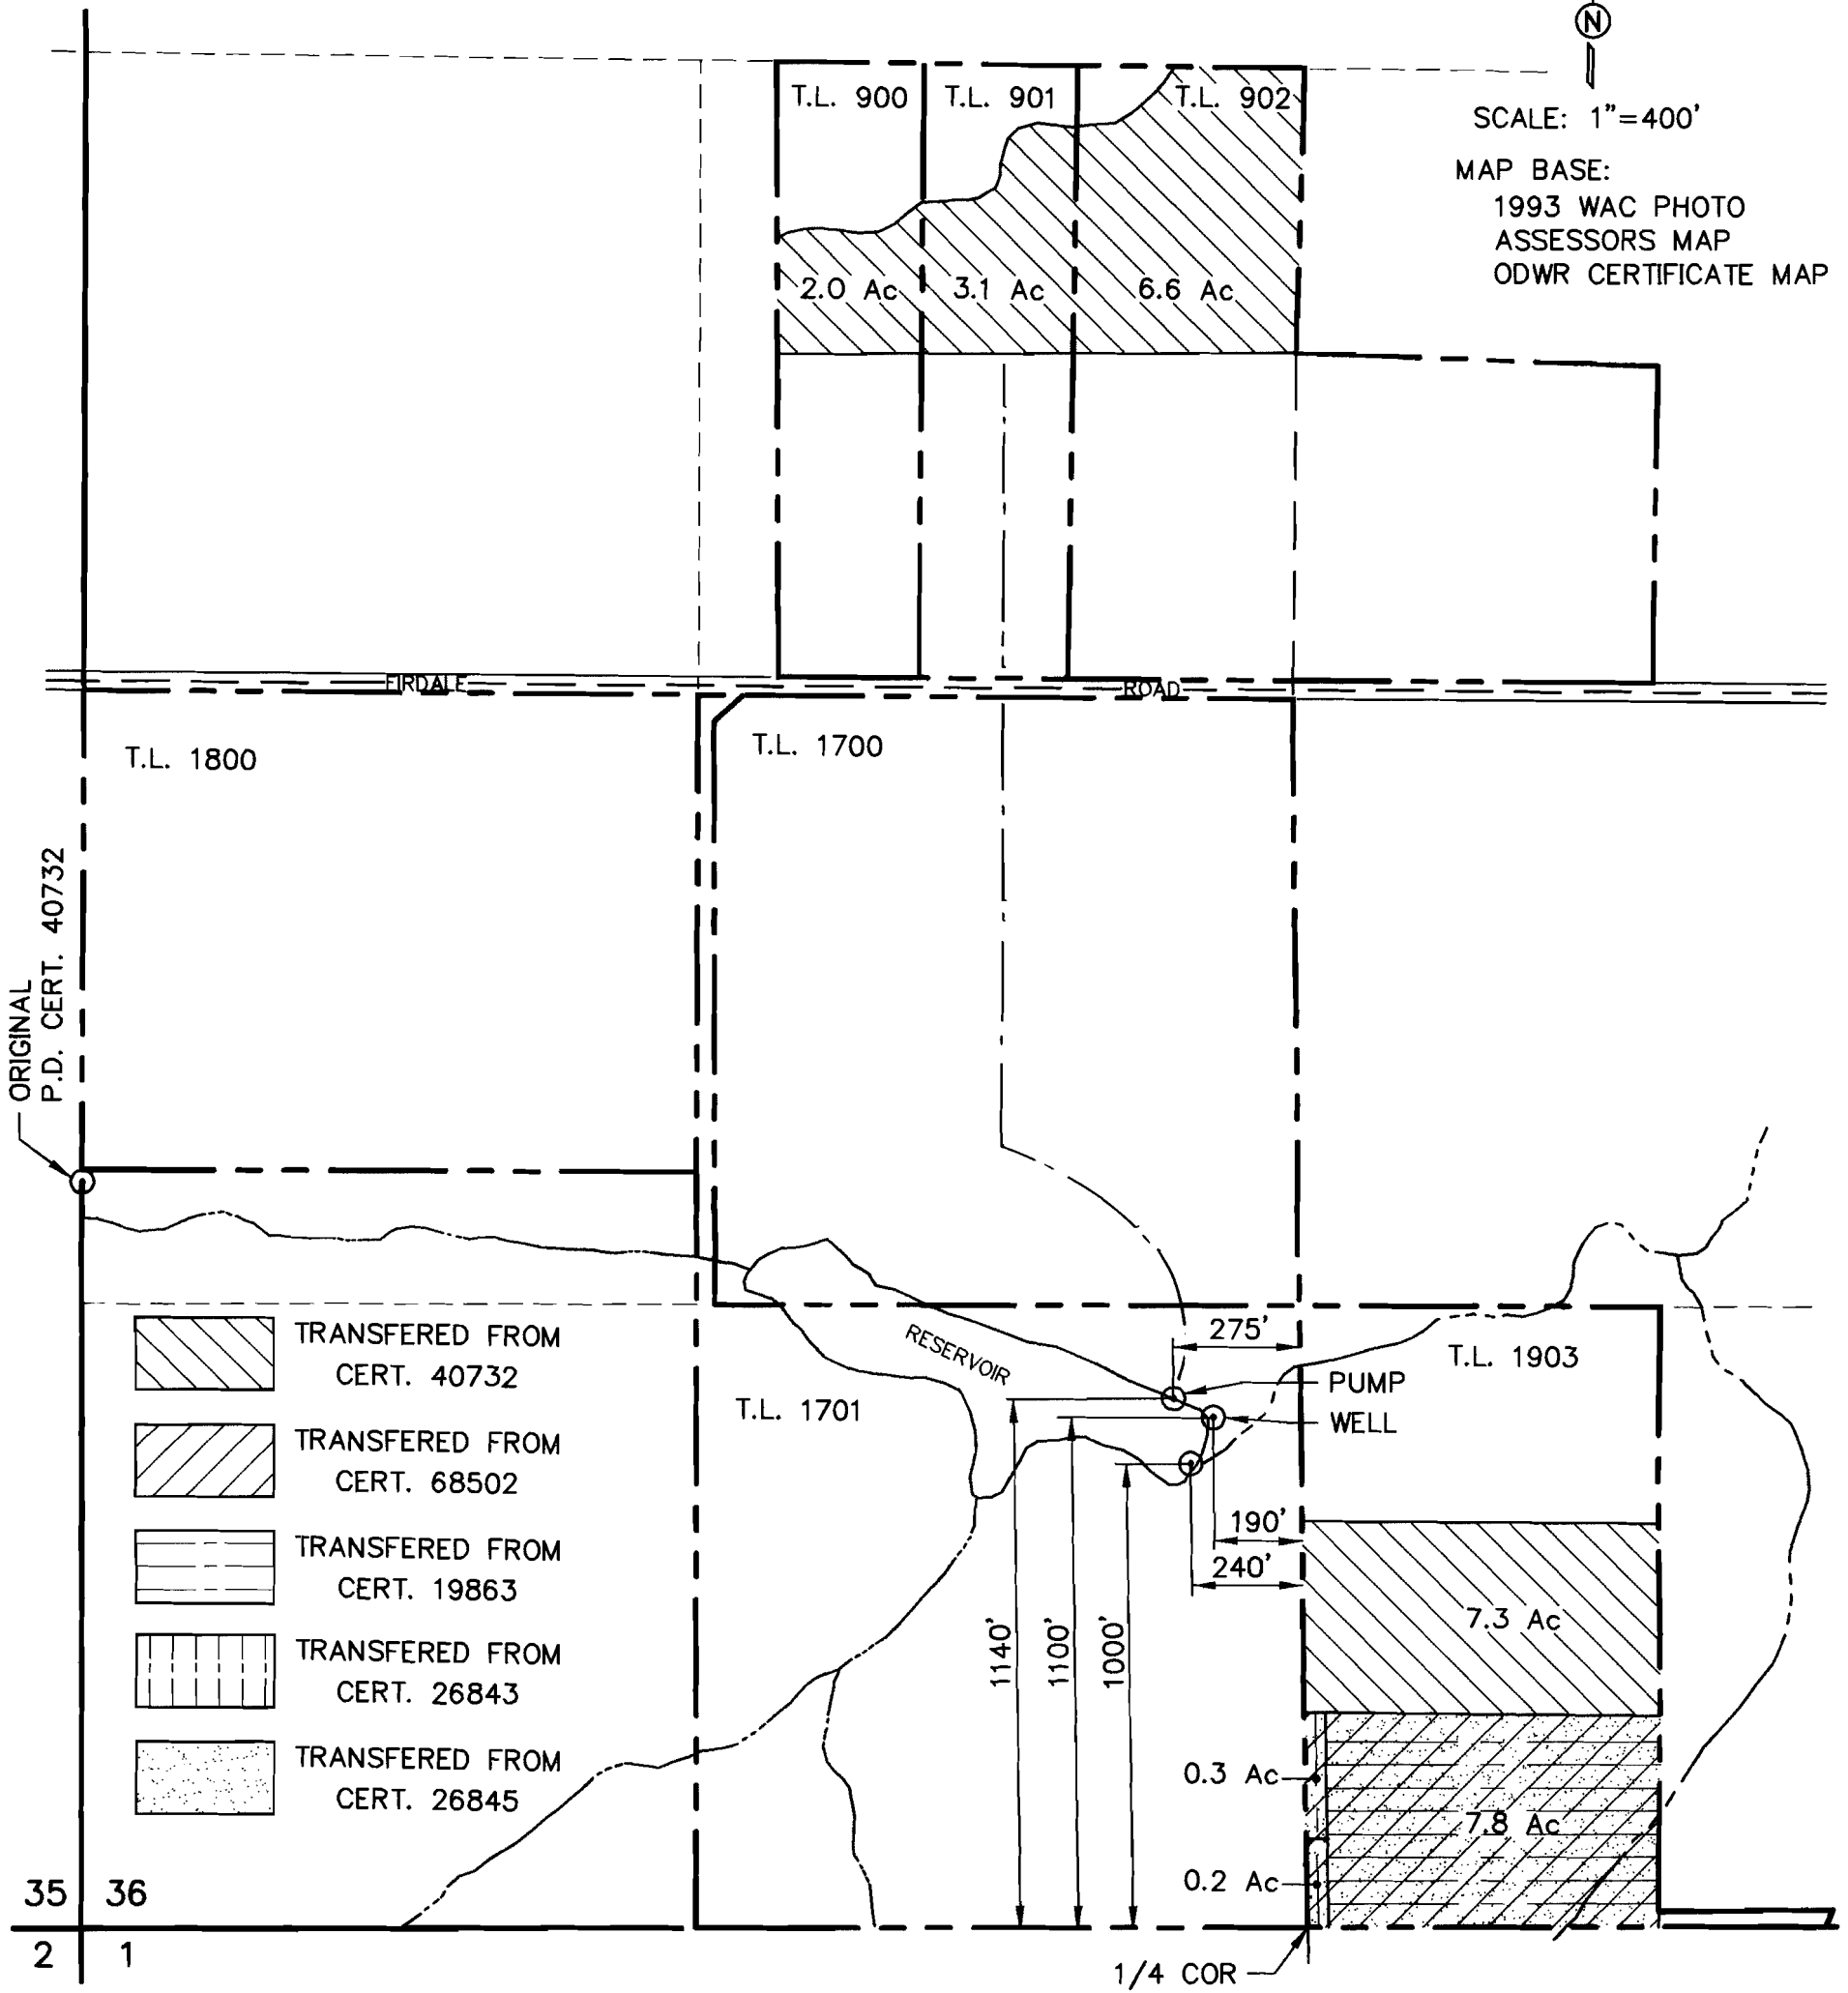


SCALE: 1"=400'

MAP BASE:
1993 WAC PHOTO
ASSESSORS MAP
ODWR CERTIFICATE MAP



FINAL PROOF SURVEY
UNDER
TRANSFER T-7207
SURVEYED JUNE 7, 2000

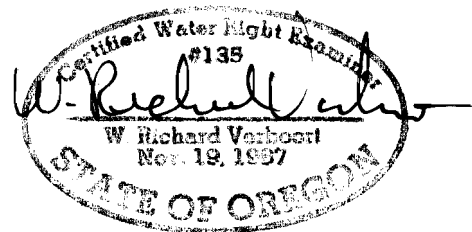

PREPERATION OF THIS MAP IS FOR THE
PURPOSE OF IDENTIFYING THE LOCATION OF
THE WATER RIGHT ONLY. THERE IS NO INTENT
TO PROVIDE DIMENSIONS OR LOCATION OF
PROPERTY OWNERSHIP LINES.

VERBOORT ENGINEERING
AGRICULTURE · CIVIL · WATER REBOURCES
HILLSBORO, OREGON

	by	date
designed	WRV	06/09/00
drawn	JER	06/09/00
checked	WRV	06/09/00
drawing no.	00-B-06	
sheet no.	1 / 1	

RICHARD L. and SANDRA M. TWIGG
dba TWIGG FARM
31500 S.W. FIRDALE ROAD
CORNELIUS, OR 97113






SECTION 36, T.15., R.3W., W.M.
WASHINGTON COUNTY, OREGON




RECEIVED
MAY 16 1995
WATER RESOURCES DEPT.
SALEM, OREGON






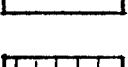

MAP BASE:
1993 WAC PHOTO
COUNTY TAX MAP
ODWR CERTIFICATE MAPS

SCALE: 1"=400'

-  CERT. 40732
-  CERT. 26843
-  PERMIT G-10621 - Suppl
(SURVEYED 6/87 ODWR)
-  CERT. 19863
-  CERT. 26845 - Suppl

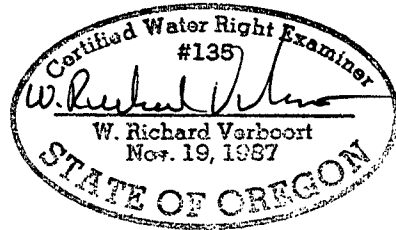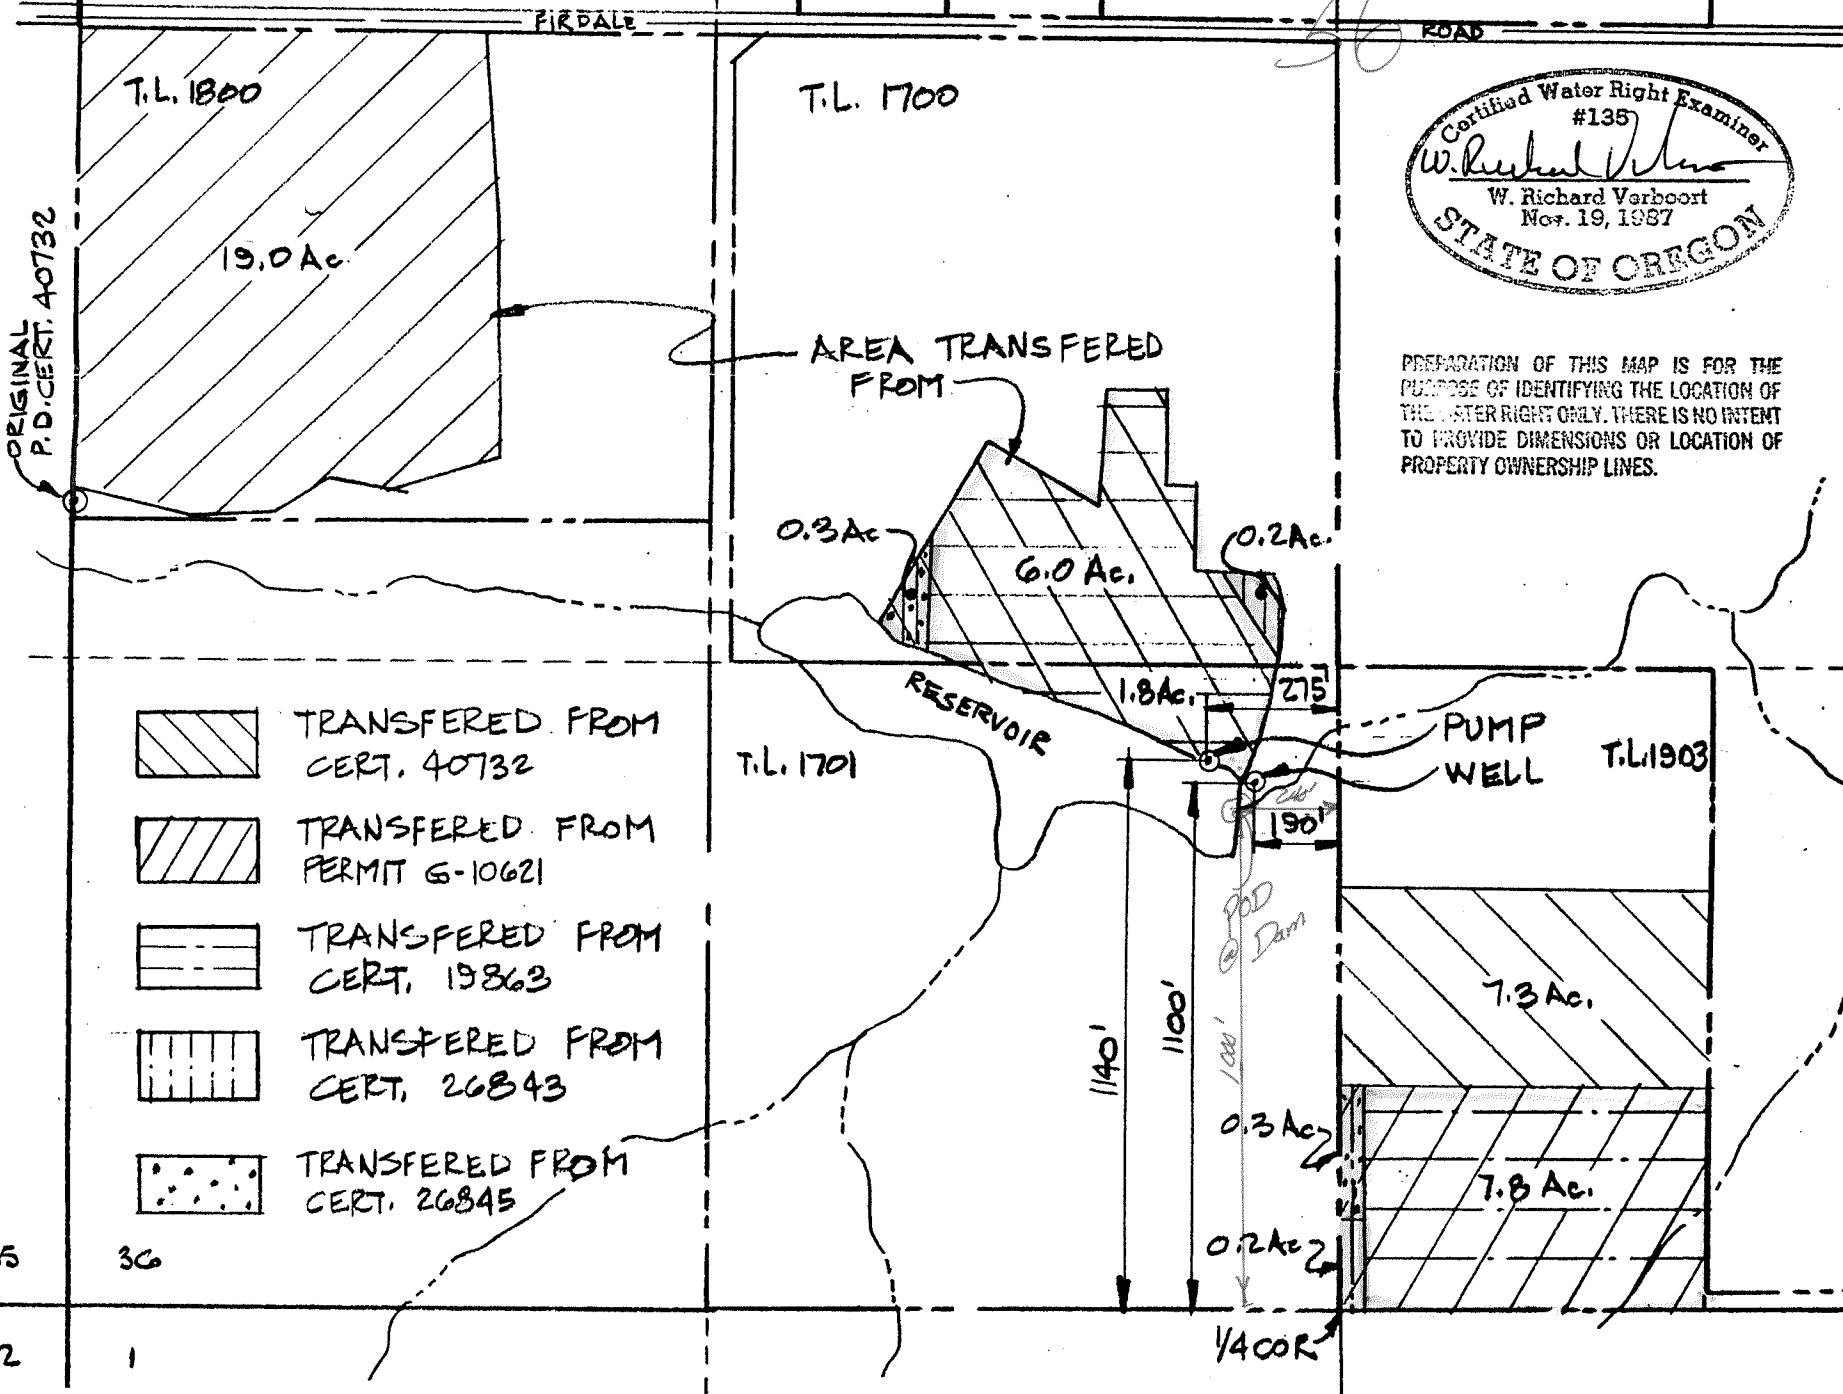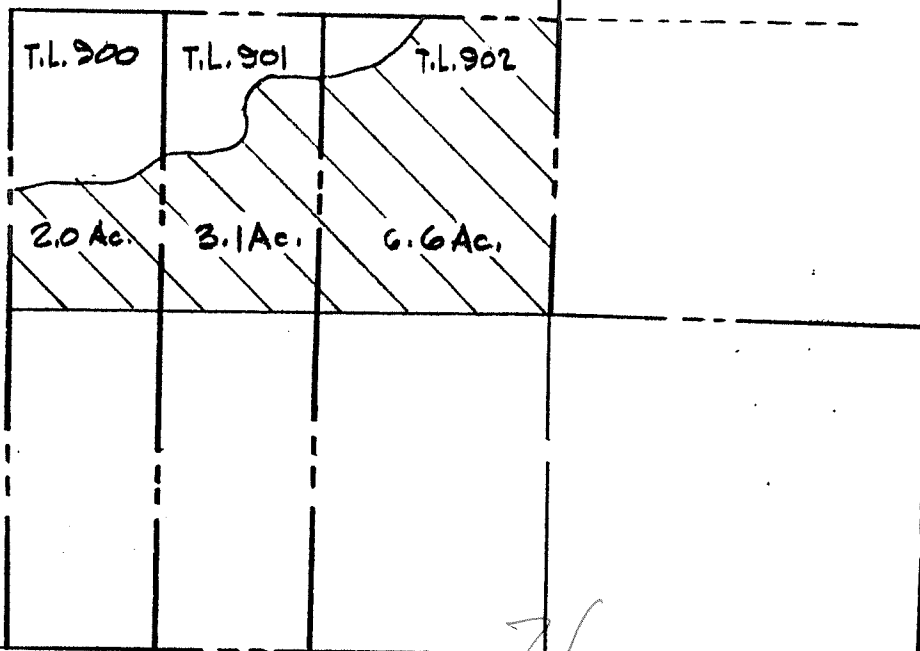

PREPARATION OF THIS MAP IS FOR THE
PURPOSE OF IDENTIFYING THE LOCATION OF
THE WATER RIGHT ONLY. THERE IS NO INTENT
TO PROVIDE DIMENSIONS OR LOCATION OF
PROPERTY OWNERSHIP LINES.

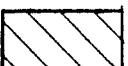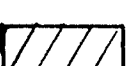-  TRANSFERED FROM
CERT. 40732
-  TRANSFERED FROM
PERMIT G-10621
-  TRANSFERED FROM
CERT. 19863
-  TRANSFERED FROM
CERT. 26843
-  TRANSFERED FROM
CERT. 26845

TRANSFER APPLICATION

REV. 5-5-95

VERBOORT ENGINEERING
AGRICULTURE • CIVIL • WATER RESOURCES
HILLSBORO, OREGON

	by date
designed	WRV 6.29.94
drawn	JER 6.29.94
checked	WRV 6.29.94
drawing no.	94-B-14
sheet no.	1/1

RICHARD L. & SANDRA M. TWIGG
dba TWIGG FARM
31500 S.W. FIRDALE ROAD
CORNELIUS, OR 97113