

22 23


23

NW 1/4 SW 1/4

NE 1/4 SW 1/4

POINT OF DIVERSION IS SOUTH 53°14' EAST 1161 FEET FROM THE W 1/4 CORNER OF SEC. 23.

NOTE: AREA IRRIGATED (LESS THAN 0.5 AC PER HOUSEHOLD)

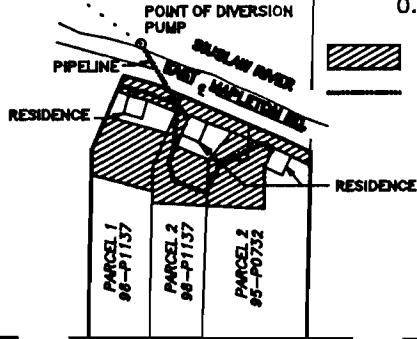

INDICATES AREA IRRIGATED.  
INDICATES PIPELINE.

SW 1/4 SW 1/4

SE 1/4 SW 1/4

THIS MAP IS FOR THE PURPOSE OF IDENTIFYING THE LOCATION OF THE WATER RIGHT ONLY. THERE IS NO INTENT TO PROVIDE DIMENSIONS OR LOCATION OF PROPERTY OWNERSHIP LINES.

22 23  
27 26

# FINAL PROOF WATER RIGHTS MAP

# 84576

UNDER PERMIT 52221 APPLICATION NO. 73770

17-10-23-3, 504 SW 1/4, SEC 23, T17S, R10W, W.M. LANE COUNTY, OREGON

FOR: LARRY W. AND DOROTHEA NULL 12022 E. MAPLETON RD. MAPLETON, OREGON 97439

PREPARED BY: WOBBE & ASSOCIATES, INC. 510 KINGWOOD ST. / P.O. BOX 3093 FLORENCE, OR 97439 DATE: SEPTEMBER 14, 1999

RECEIVED

MAR 09 2011

WATER RESOURCES DEPT SALEM, OREGON



SCALE 1"=400'

T 11205

