

APPLICATION MAP CHANGE IN POINT OF DIVERSION


SEC. 24, T. 9 S., R. 16 E., W.M., JEFFERSON COUNTY, OREGON


FOR: LAURA FEIGNER




SCALE 1" = 1320'

 EXISTING RIGHTS
PERMIT 40187

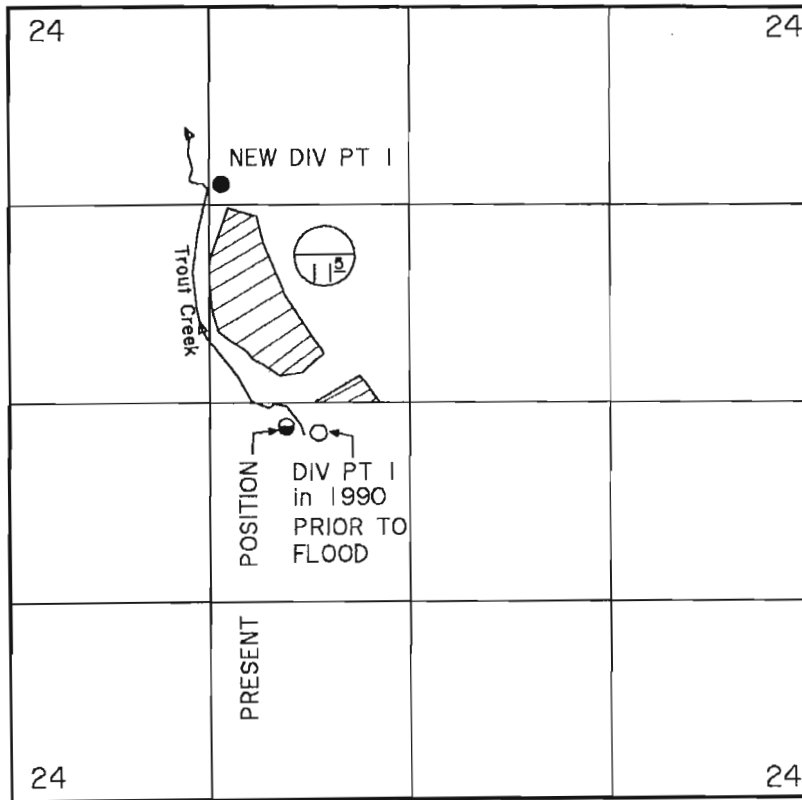


 DIV PT I
200' S & 600' W FROM C SEC. 24
PERMIT NO. 40187

 NEW PT I
1458' N & 1240' W FROM C SEC. 24
PERMIT NO. 40187

RECEIVED

SEP 06 2011

WATER RESOURCES DEPT
SALEM, OREGON

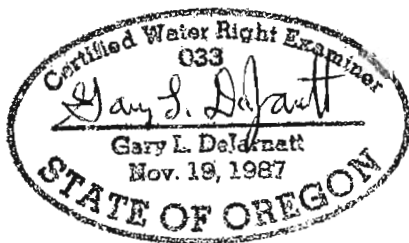

PREPARED BY:
DEJARNATT LAND SURVEYS, INC.

63885 NORTH HWY 97
BEND, OREGON 97701
PHONE: 541-382-4192


DATE: JULY 11, 2011
SHEET 1 OF 1
JOB # 10012K

T 11292

RENEWS: 12/31/2011

T.9S., R.16E., W. M.

T. 11292

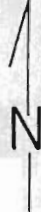

SCALE: 1" = 1320'

RECEIVED

SEP 06 2011

WATER RESOURCES DEPT

SALEM OREGON



EXISTING RIGHT PERMIT 40187



DIV. PT 1
200'S & 600'W From C Of Sec 24

DIV. PT 2
350'S & 80'E From N1/4 Cor Of Sec 25

DIV. PT 3
1000'N & 300'E From C Of Sec 36

TRANSFER 3348

FINAL PROOF SURVEY

UNDER

TRANSFERS 3348 *C72480*
3509 *C72481*


Application No. 53846 Permit No. 40187
IN NAME OF *C72479*

DARRELL & LUELLE FRIEND

Surveyed Jan. 22, 1990 By B W BISHOP

- = cert. 72481 (1891)
- = cert. 72481 (MAR 1898)
- = cert. 72479 (1976)
- = cert. 72480 (1925)

(SEE Trout Cr. FILE FOR ADDITIONAL INFO)

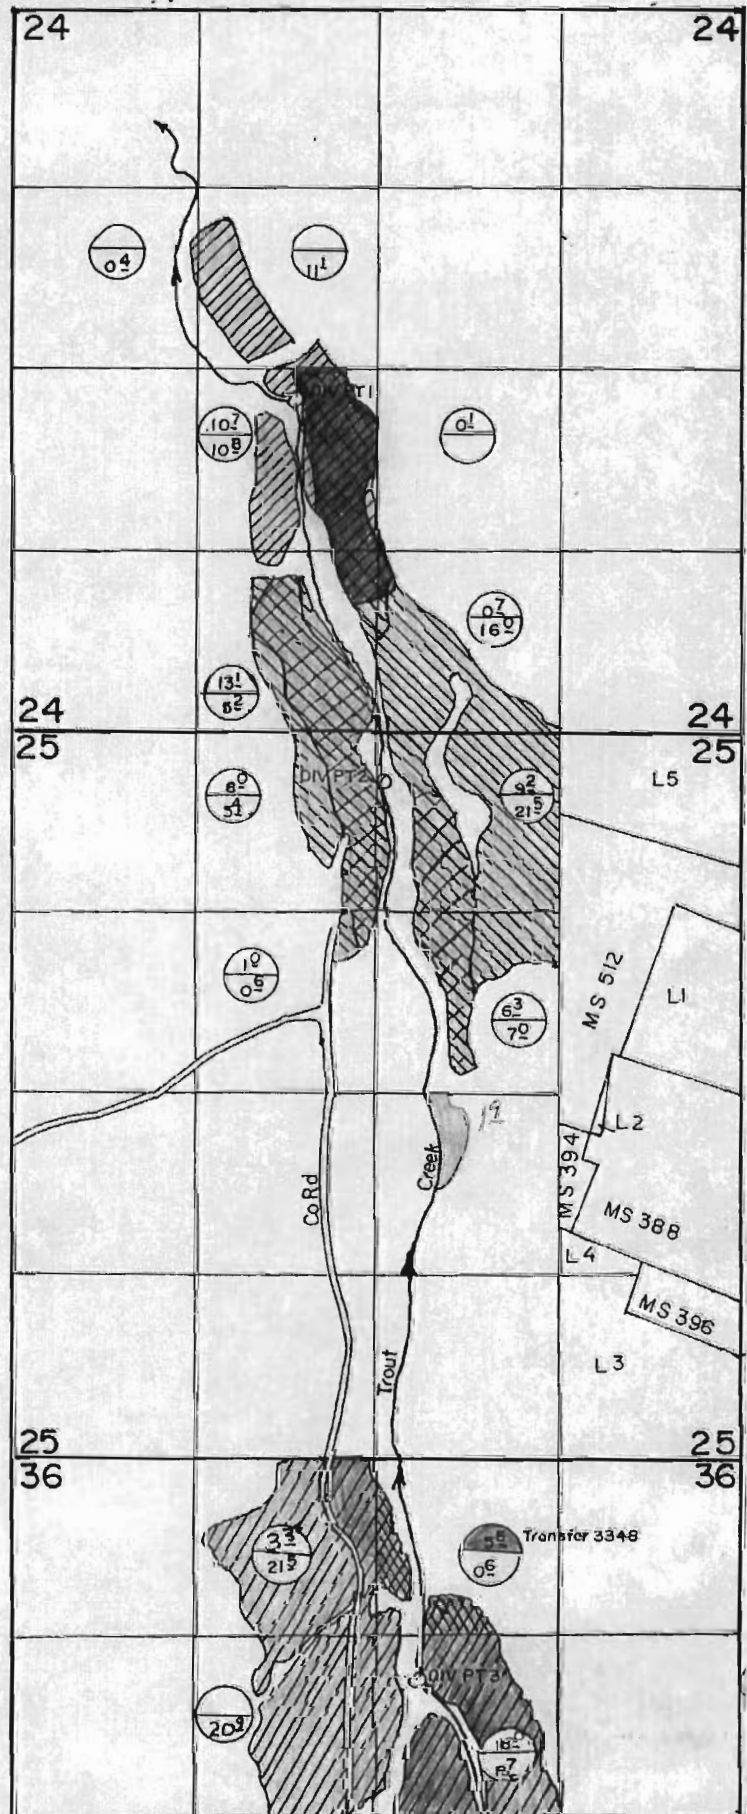

C-72479

T-3509
T-3348
40187

REVISED 6/19/96
SEX