



T 11325



SCALE:  
1" = 1320'

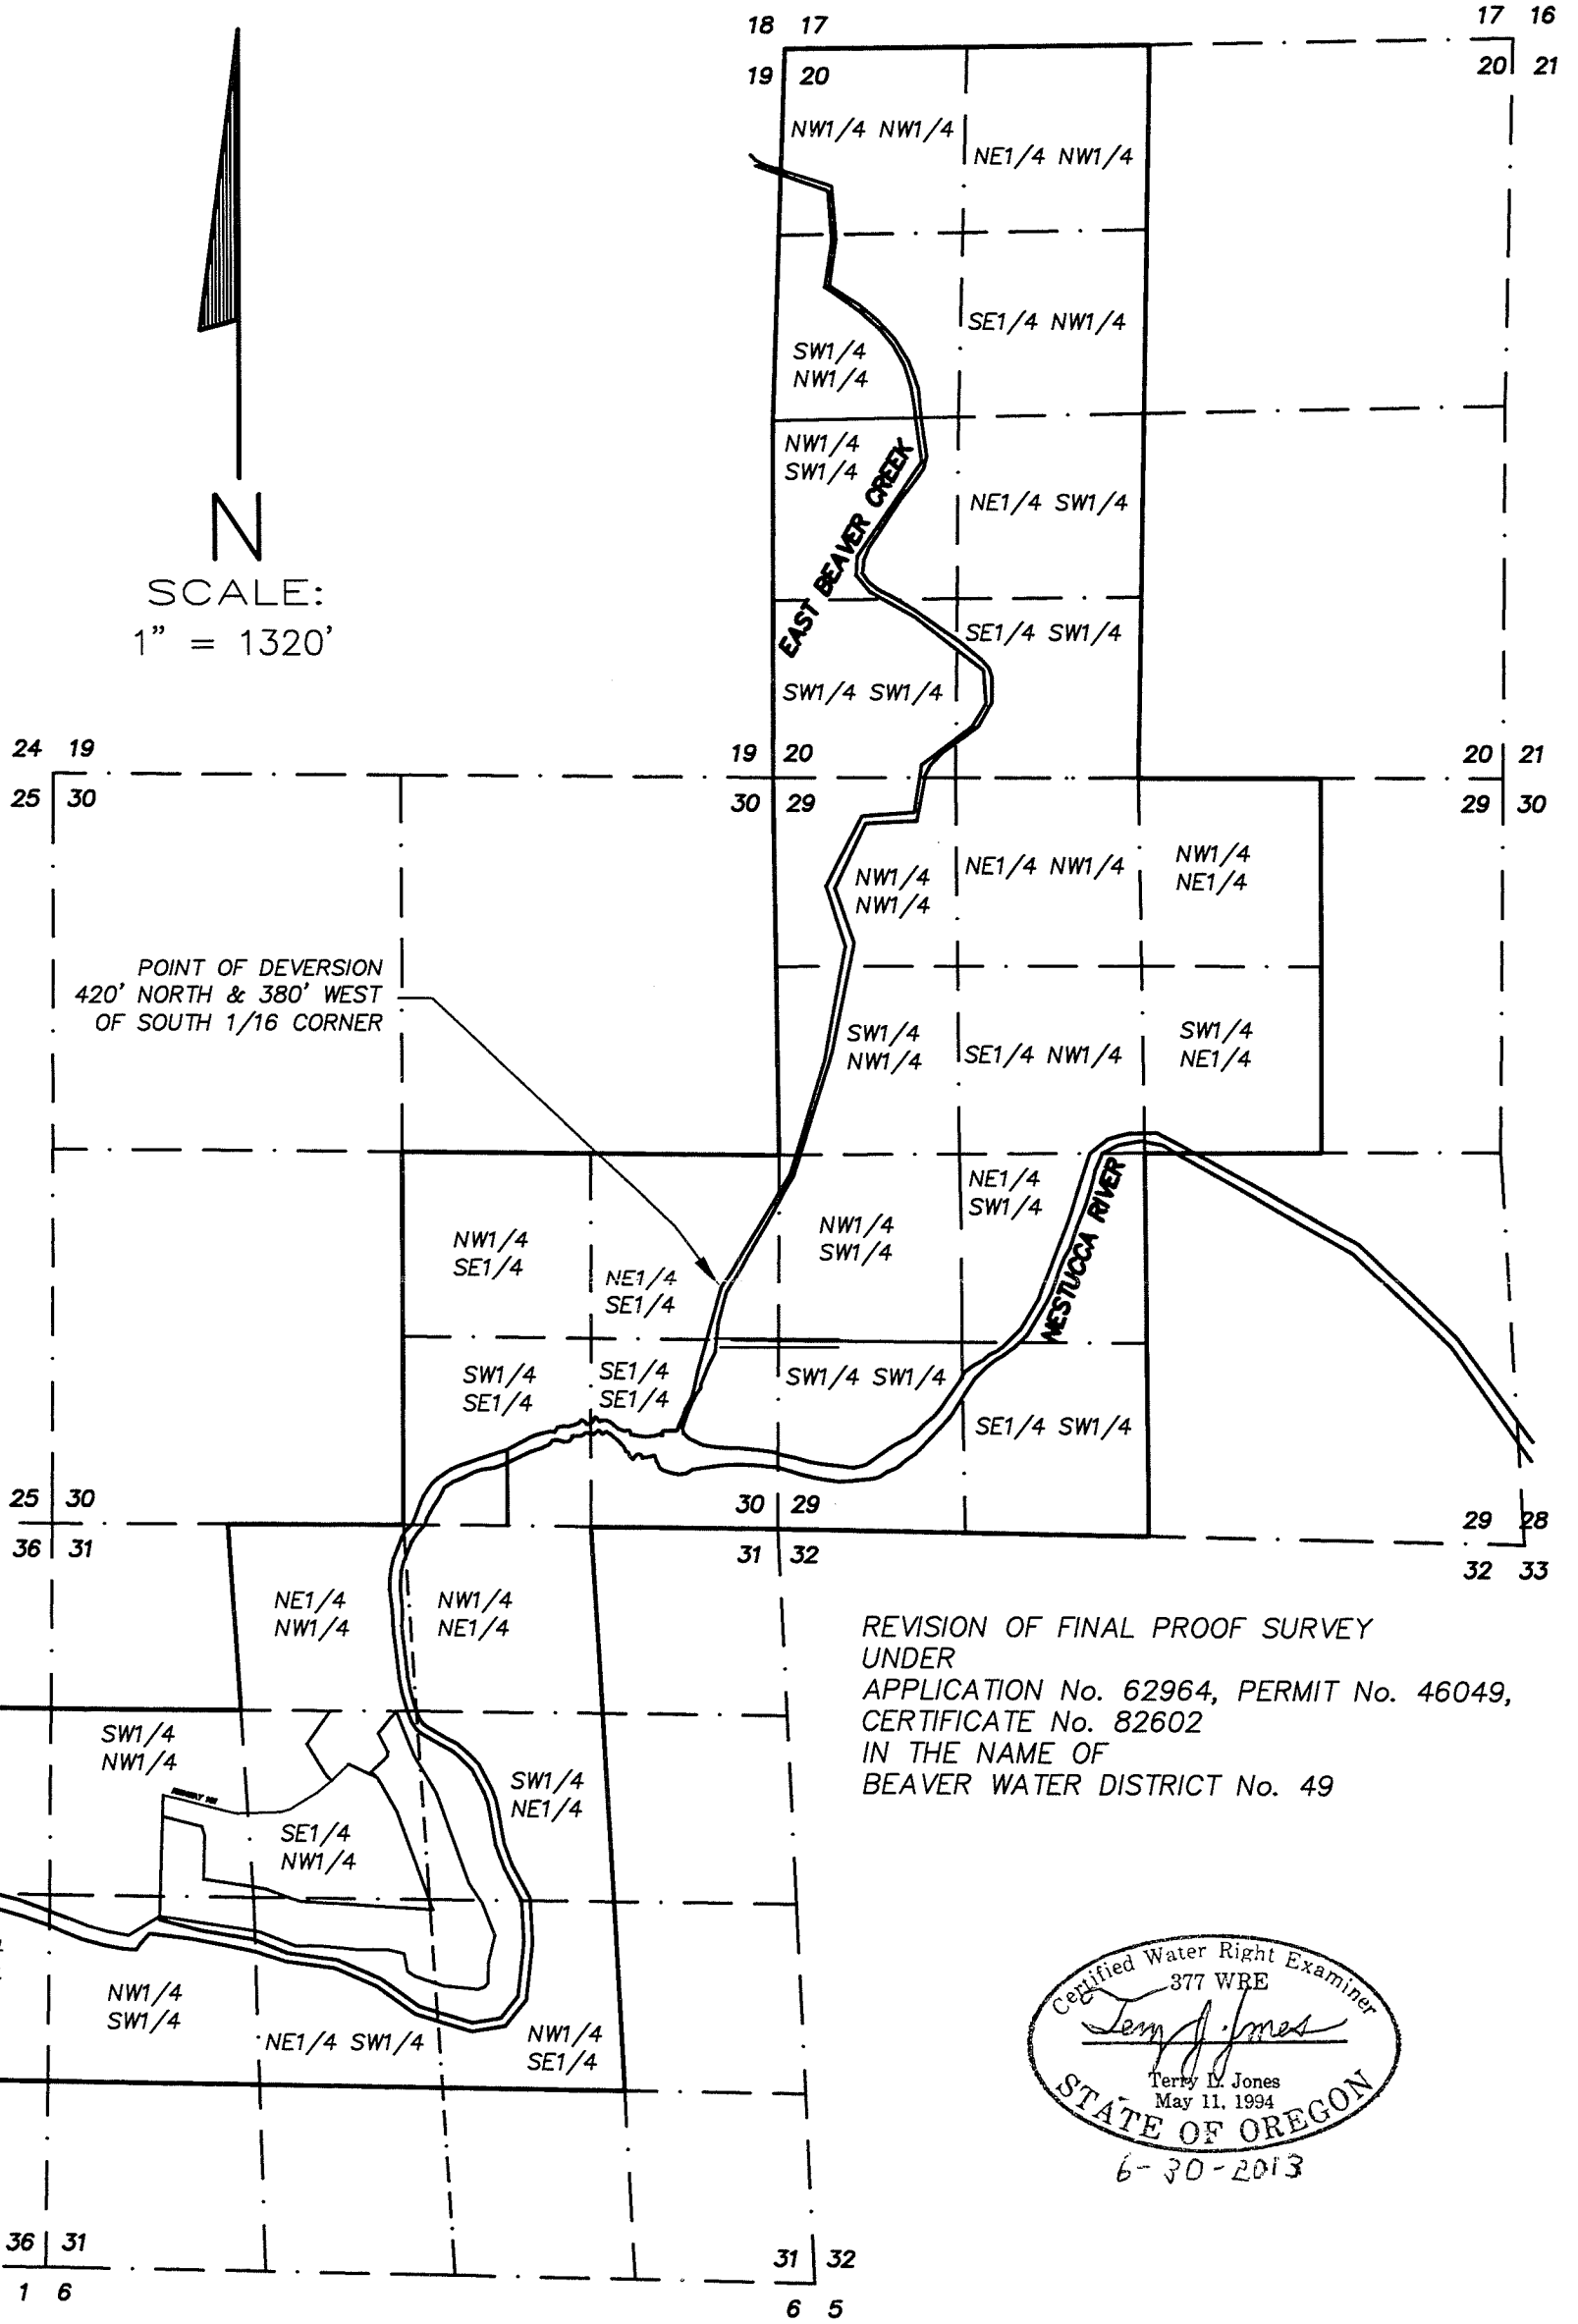

REVISION OF FINAL PROOF SURVEY  
 UNDER  
 APPLICATION No. 62964, PERMIT No. 46049,  
 CERTIFICATE No. 82602  
 IN THE NAME OF  
 BEAVER WATER DISTRICT No. 49

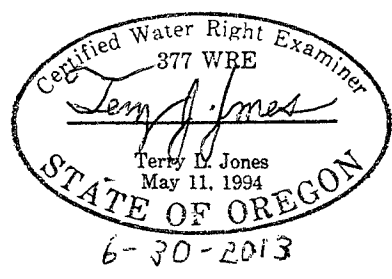

SITE\BWD\_WR2.DWG

SURVEY BY:  
**BAYSIDE SURVEYING**  
 11765 HWY 101 SOUTH  
 TILLAMOOK, OR. 97141  
 (503) 842-5551

WATER RIGHTS MAP FOR:  
**BEAVER WATER DISTRICT**  
 NEW SERVICE AREA FOR THE  
 BEAVER WATER DISTRICT  
 LYING IN PORTIONS OF SECTION 36, T3S, R10W  
 AND IN SECTIONS 20, 29, 30 & 31, T3S, R9W, W.M.  
 TILLAMOOK COUNTY, OREGON

**RECEIVED**  
 DEC 05 2011  
 WATER RESOURCES DEPT  
 SALEM, OREGON

DATE	EQUIPMENT	FIELD	DRAWN	CHECKED	JOB NO.
NOV. 3, 2011	TOPCON GPT-3003W TDS NOMAD		GAC	TLJ	