

EXHIBIT 'A'

T-7823

RECEIVED


JUL 25 1997

WATER RESOURCES DEPT.  
SALEM, OREGON

TAX LOT 35 1W 34-1800

Proposed  
IRRIGATION  
LINE

SCALE: 1" = 100'

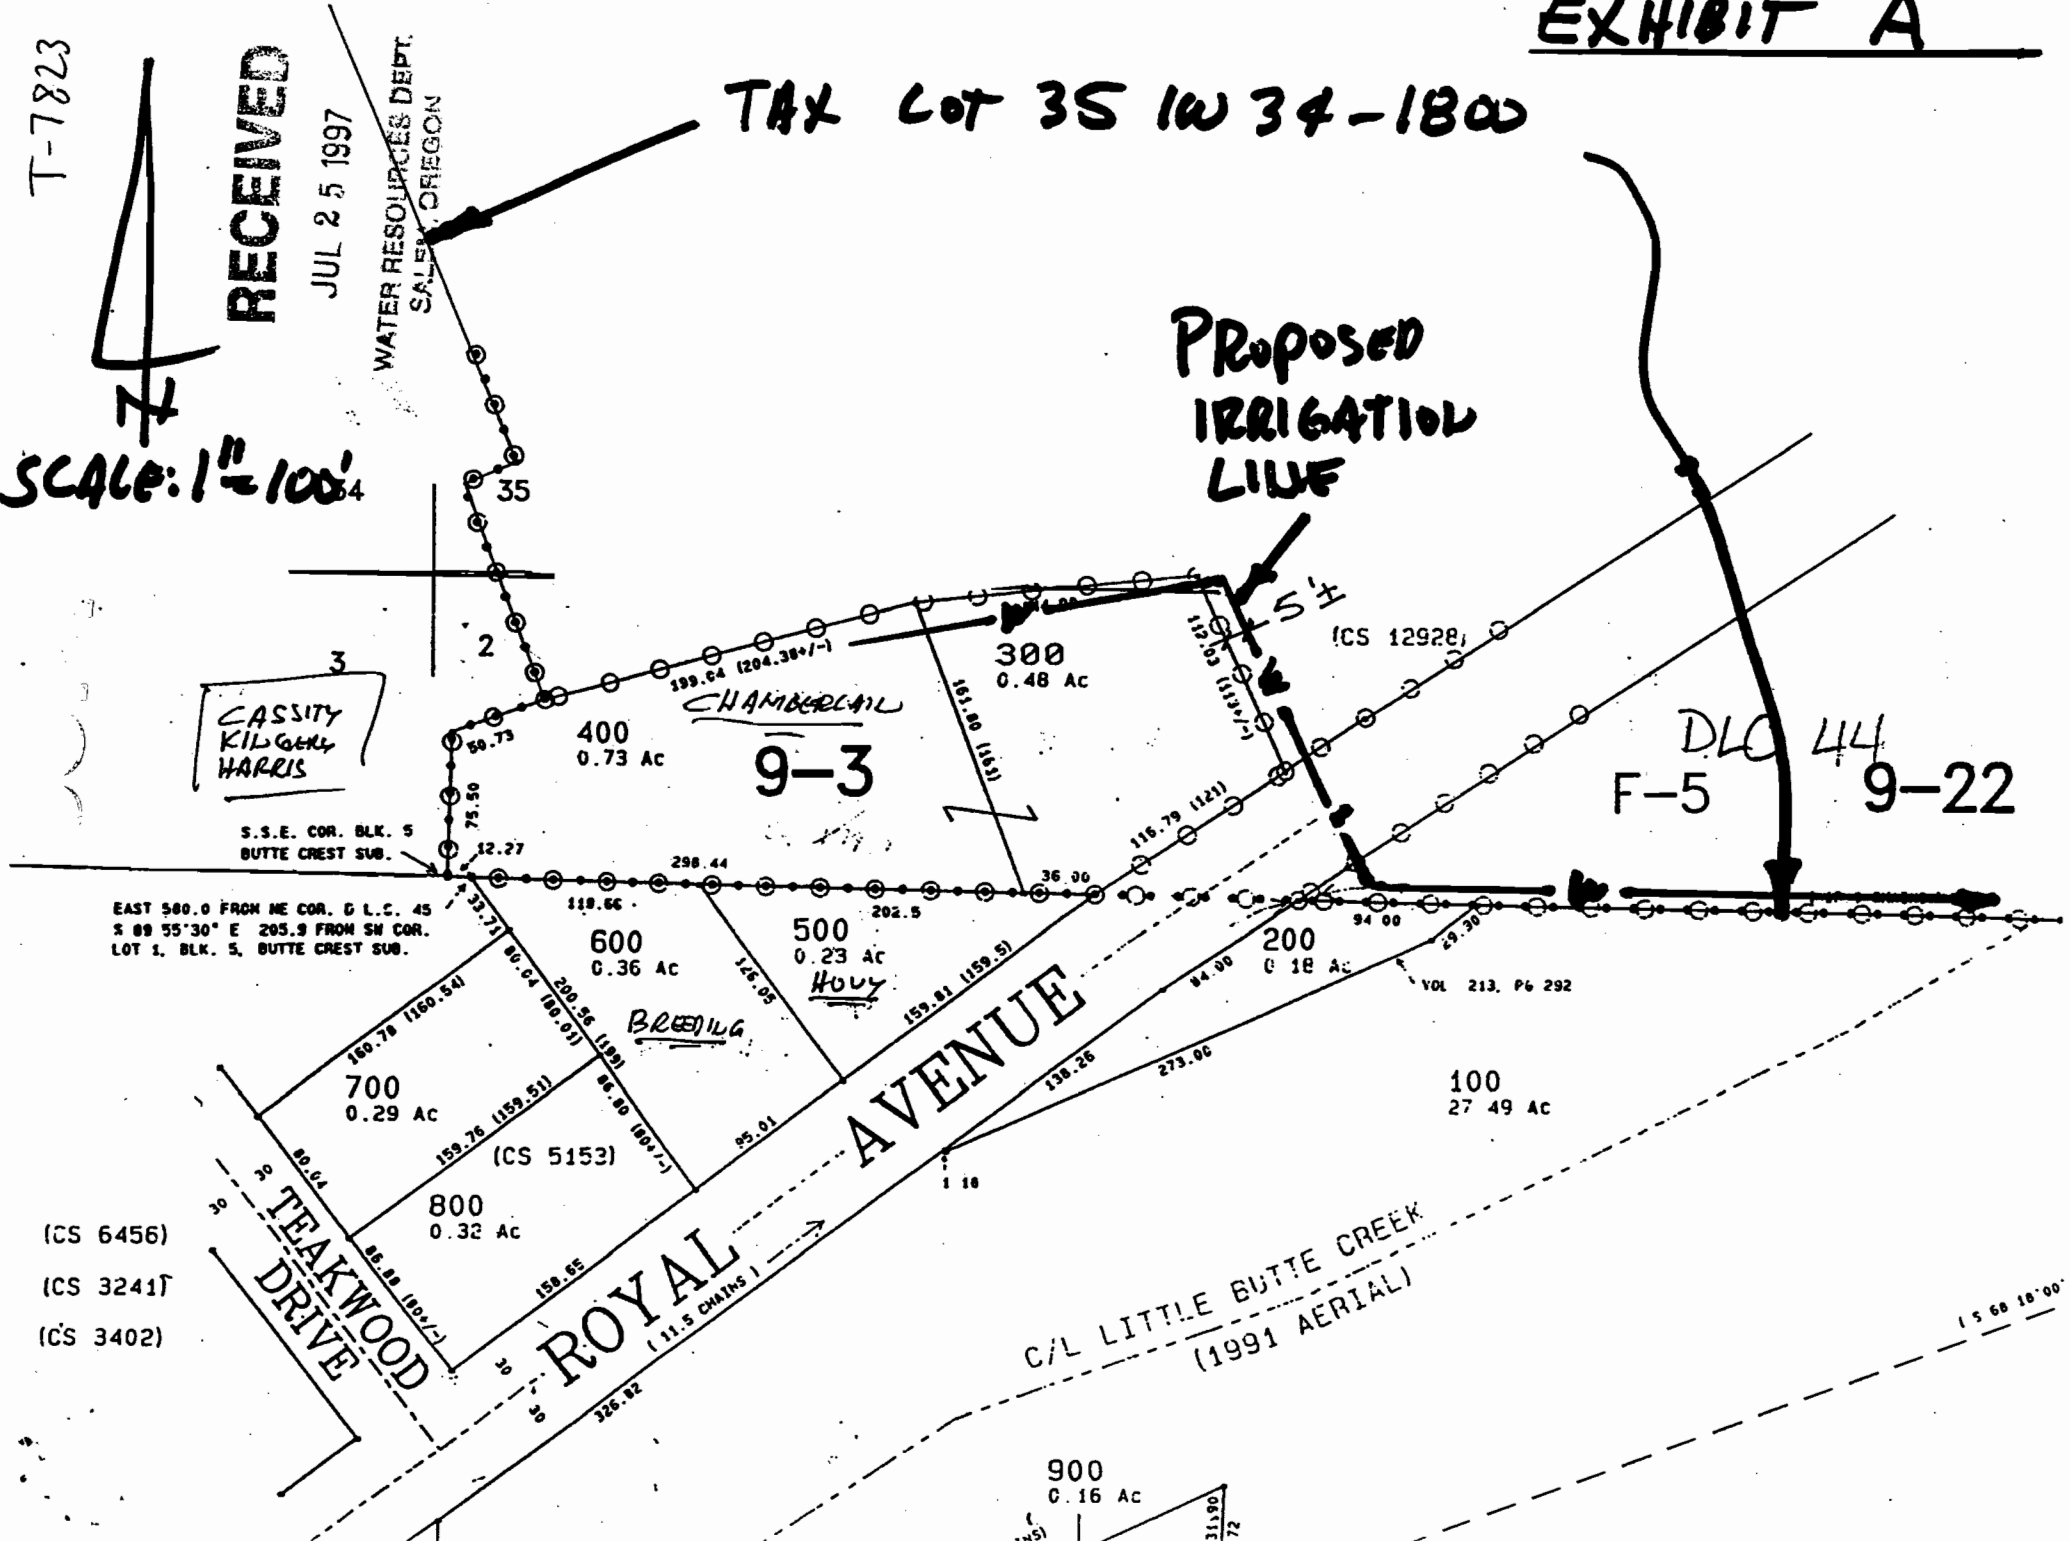

CASSITY  
KILGORE  
HARRIS

9-3

DLC 44  
F-5  
9-22

EAST 500.0 FROM NE COR. G.L.C. 45  
S 89 55'30" E 205.9 FROM SW COR.  
LOT 1, BLK. 5, BUTTE CREST SUB.

- (CS 6456)
- (CS 3241)
- (CS 3402)

900  
0.16 Ac  
113.90  
72

T.35 & 36 S., R. 1W, W.M. ED

T-7823

JACKSON COUNTY, OR JUL 1 1998

RECEIVED

AUTHORIZED PLACE OF USE  
LITTLE BUTTE IRRIGATION CO.  
CERT. No. 68691 (2.4 AC.)

WATER RESOURCES DEPT. JUL 25 1997

SALEM, OREGON WATER RESOURCES DEPT.  
SALEM, OREGON

BEING TRANSFERRED TO ④ ⑤ ⑥  
(OR NO CHANGE)  
0.5

SE 1/4 SE 1/4 SEC. 34

SW 1/4 SW 1/4 SEC. 35

NOTE: MAP PREPARED FOR  
WATER RIGHT PURPOSES ONLY,  
NOT FOR PROPERTY BOUNDARY  
LOCATIONS

0.04 AC. SE 1/4 SE 1/4 SEC. 34  
0.01 AC. SW 1/4 SW 1/4 SEC. 35  
④ 0.09 AC. NE 1/4 NE 1/4 SEC. 3  
⑥ 0.06 AC. NW 1/4 NW 1/4 SEC. 2

RECEIVED

NOV 18 1998

WATER RESOURCES DEPT.  
SALEM, OREGON  
DLC # 40

W 1/4 SE 1/4  
SEC. 34

T35S.  
T36S.

DLC # 44

NE COR  
DLC # 45

DLC # 45

COPY

NE 1/4 NE 1/4 SEC. 3

NW 1/4 NW 1/4 SEC. 2  
(GOVT LOT 1, SEC. 2)

MAP TO ACCOMPANY  
APPLICATIONS FOR A CHANGE IN  
POINT OF DIVERSION AND A CHANGE  
IN PLACE OF USE  
FOR:

- POINT OF DIVERSION ONLY.
- 1) HARRIETT CHAMBERLAIN
- 2) JASON HOLY
- 3) LLOYD BREEDING

POINT OF DIVERSION AND  
PLACE OF USE:

- ④ HAROLD CASSITY
- ⑤ HAROLD KINGERY
- ⑥ SCOTT HARRIS

C/O HAROLD KINGERY  
P.O. Box 153  
EAGLE POINT, OR 97524

PREPARED BY:  
KAISER SURVEYING  
19440 Hwy 62  
EAGLE POINT, OR 97524

DECEMBER 27, 1996  
REVISED 3-30-98 GPK



AUTHORIZED PLACE OF USE  
LITTLE BUTTE IRR.  
CO. CERT. No. 68691 2.4 AC.



NEW PLACE OF USE LITTLE  
BUTTE IRR. CO. CERT. No.  
68691 0.5 AC. ④ ⑤ ⑥



AUTHORIZED PLACE OF USE  
FRYER DITCH ASSOCIATION  
CERT. No. 46674 0.2 AC. ⑦

