

**RECEIVED**

MAY 0 0 10 06  
WATER RESOURCES DEPT.  
SALEM, OREGON


WATER RIGHT MAP

T-4S / R-1E / SEC-18 & 19



O. LELAND PELLATZ  
27167 S. BARLOW RD.  
AURORA, OREGON 97002

SCALE: 1" = 660'

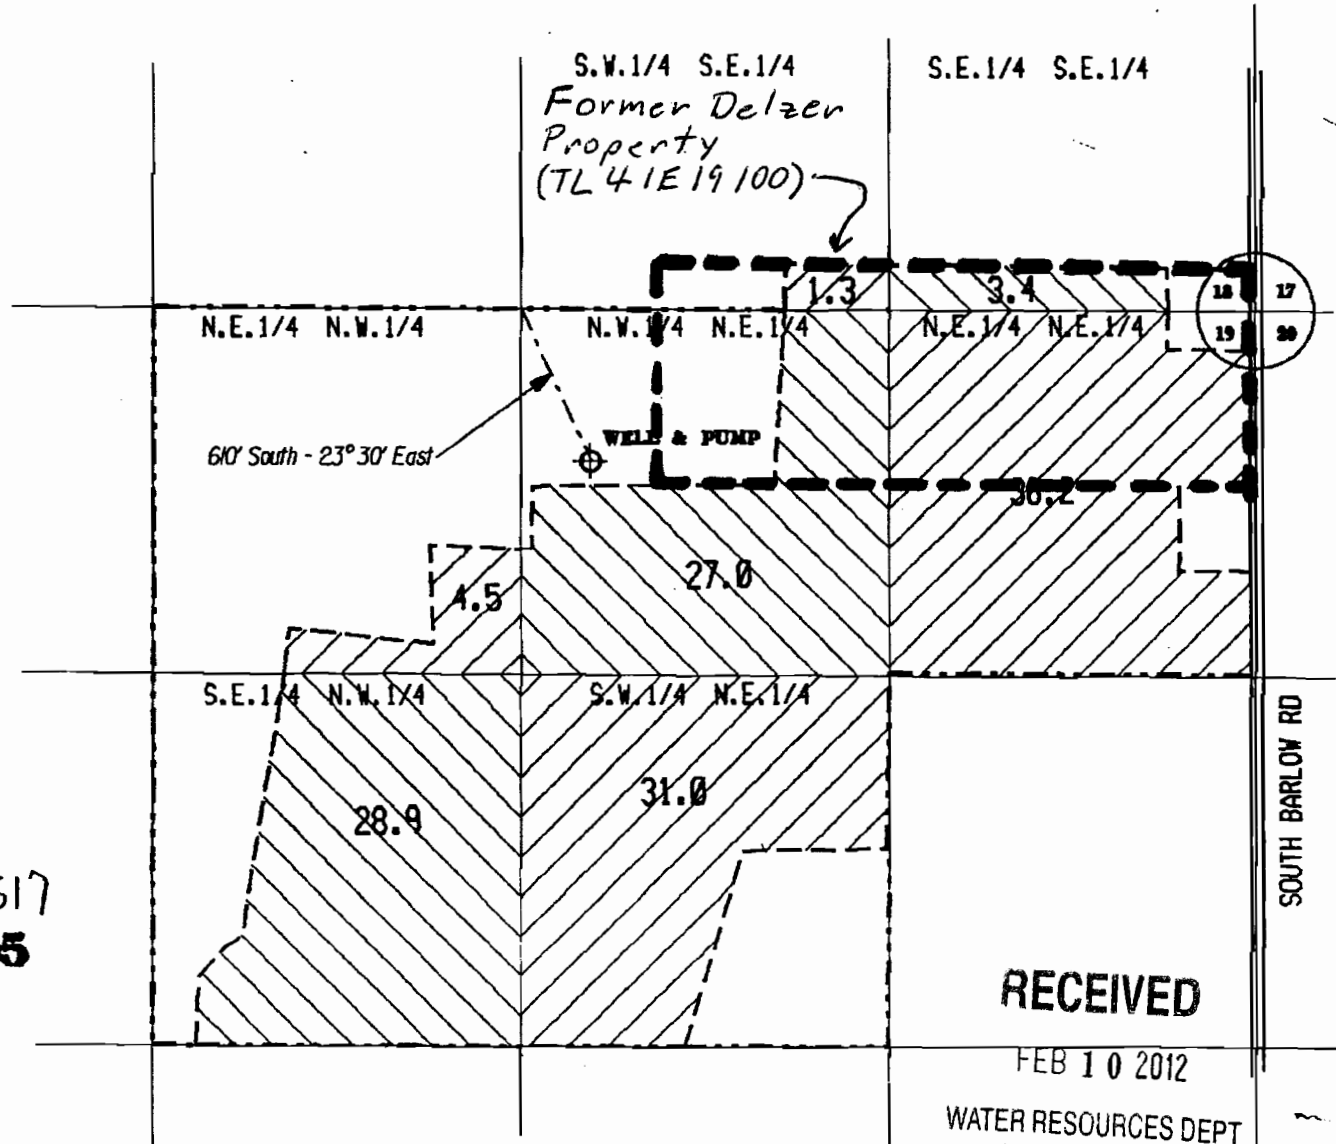

F 11352

Application No. 9-11517  
Permit No. G10605

**RECEIVED**


FEB 10 2012  
WATER RESOURCES DEPT.  
SALEM, OREGON

# T. 4 S., R. 1 E., W.M.

RECEIVED

FEB 10 2012

WATER RESOURCES DEPT  
SALEM, OREGON

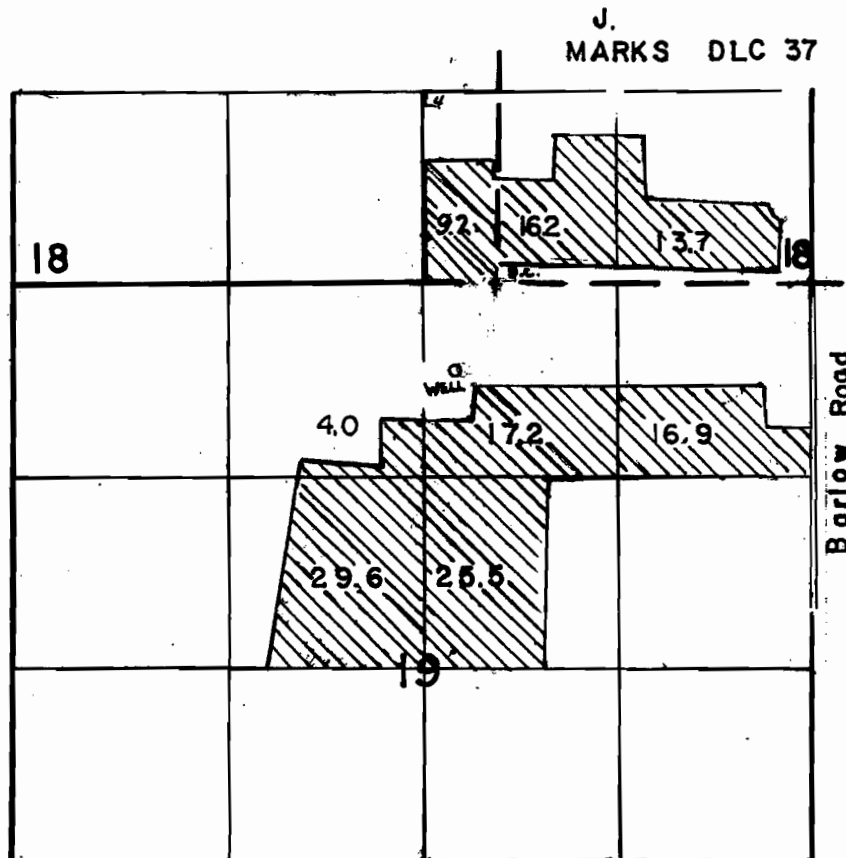

WELL IS LOCATED 610'S & 260' W FROM SW  
CORNER OF DLC 37.

## FINAL PROOF SURVEY

UNDER

Application No. G-11517 Permit No. G-10605  
IN NAME OF

J. FRANK SCHMIDT & SON CO.

Surveyed MARCH 29, 1991, by R.W.KLASSEN



T 11352

KC Feb 1993

# T.4S. R.1E. Sec. 18 & 19, W.M. RECEIVED

FEB 10 2012

WATER RESOURCES DEPT  
SALEM, OREGON

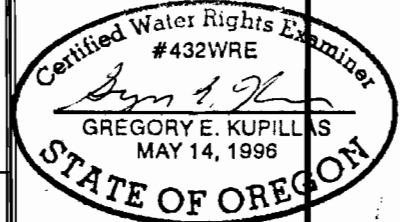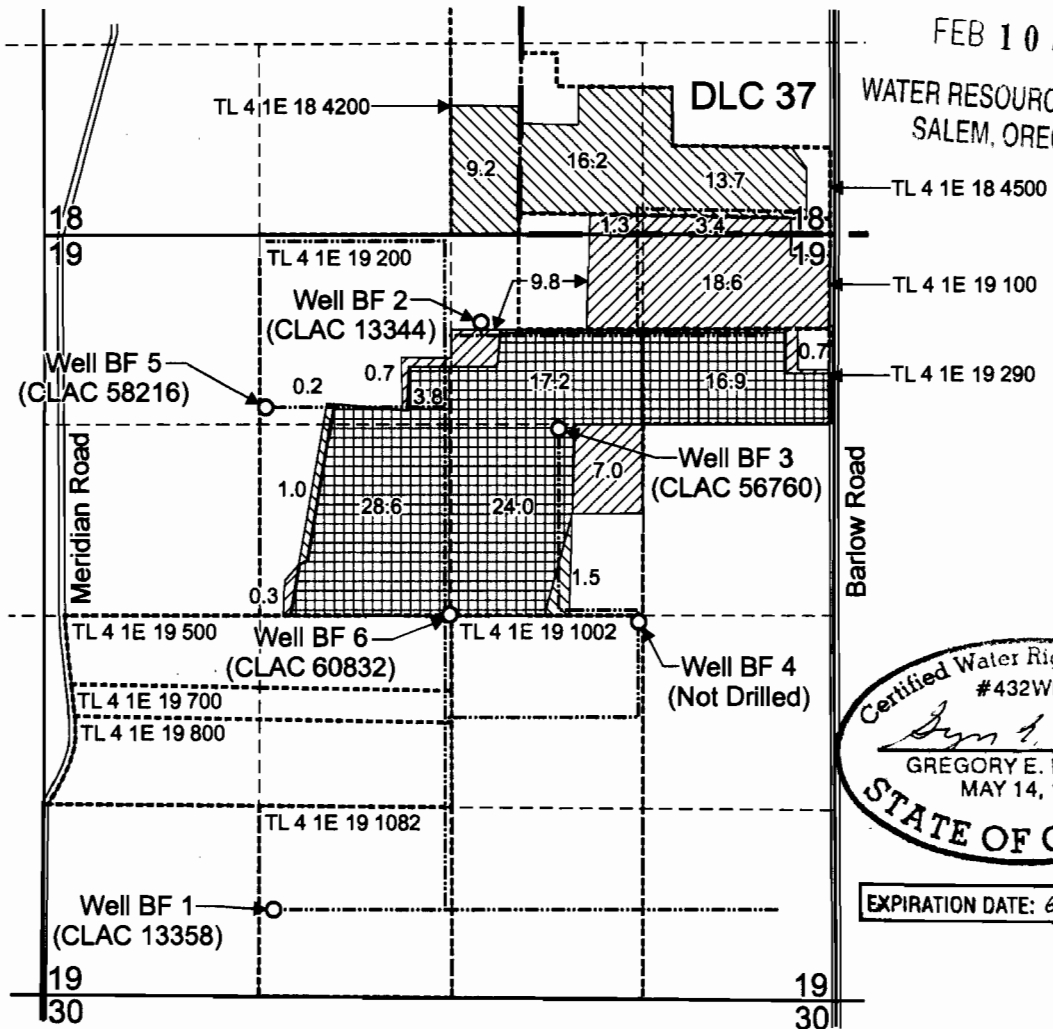

EXPIRATION DATE: 6/30/2013

Proposed Well BF 1 (CLAC 13358) is located 590 feet north and 1,580 feet east from the SW corner, Sec. 19.  
 Authorized Well BF 2 (CLAC 13344) is located 610 feet south and 260 feet west from the SW corner, DLC 37.  
 Proposed Well BF 3 (CLAC 56760) is located 1,350 feet south and 1,900 feet west from the NE corner, Sec. 19.  
 Proposed Well BF 4 (not drilled) is located 2,680 feet south and 1,350 feet west from the NE corner, Sec. 19.  
 Proposed Well BF 5 (CLAC 58216) is located 1,200 feet south and 3,920 feet west from the NE corner, Sec. 19.  
 Proposed Well BF 6 (CLAC 60832) is located 2,630 feet south and 2,650 feet west from the NE corner, Sec. 19.

"From" area (41.8 Acres) under Application G-11517, Permit G-10605 affected by this permit amendment.


"To" area (41.8 Acres) under Application G-11517, Permit G-10605 affected by this permit amendment.

Remaining area (90.5 Acres) under Application G-11517, Permit G-10605 not affected by this permit amendment.

----- Tax lot boundary

----- Irrigation mainline

Scale: 1" = 1,320'

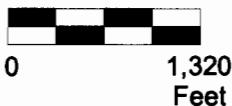

This map was prepared for the purpose of identifying the location of a water right only and is not intended to provide legal dimensions or location of property ownership lines.

Permit Amendment Application Map  
Application G-11517, Permit G-10605

J. Frank Schmidt & Son Company  
T.4S. R.1E. Sec. 18 & 19, W.M.

Pacific Hydro-Geology Inc.

10/2010

J. Frank Schmidt\_Permit\_Amendment\_App\_Map.cdr

T 11352