GR well located: 230'W + 70'N of SE corner of SW¼ of Section 35, T.6N R35E, W.M.

Proposed well is to be located approximately 1296'W + 300'N of S¼ SE corner of section 35, T6N, R35E W.M.

8 acres to be irrigated in SE¼, SW¼ Section 35

UMATILLA COUNTY, OR

SCALE: 1" = ~~200'~~ 400'

06/30/03

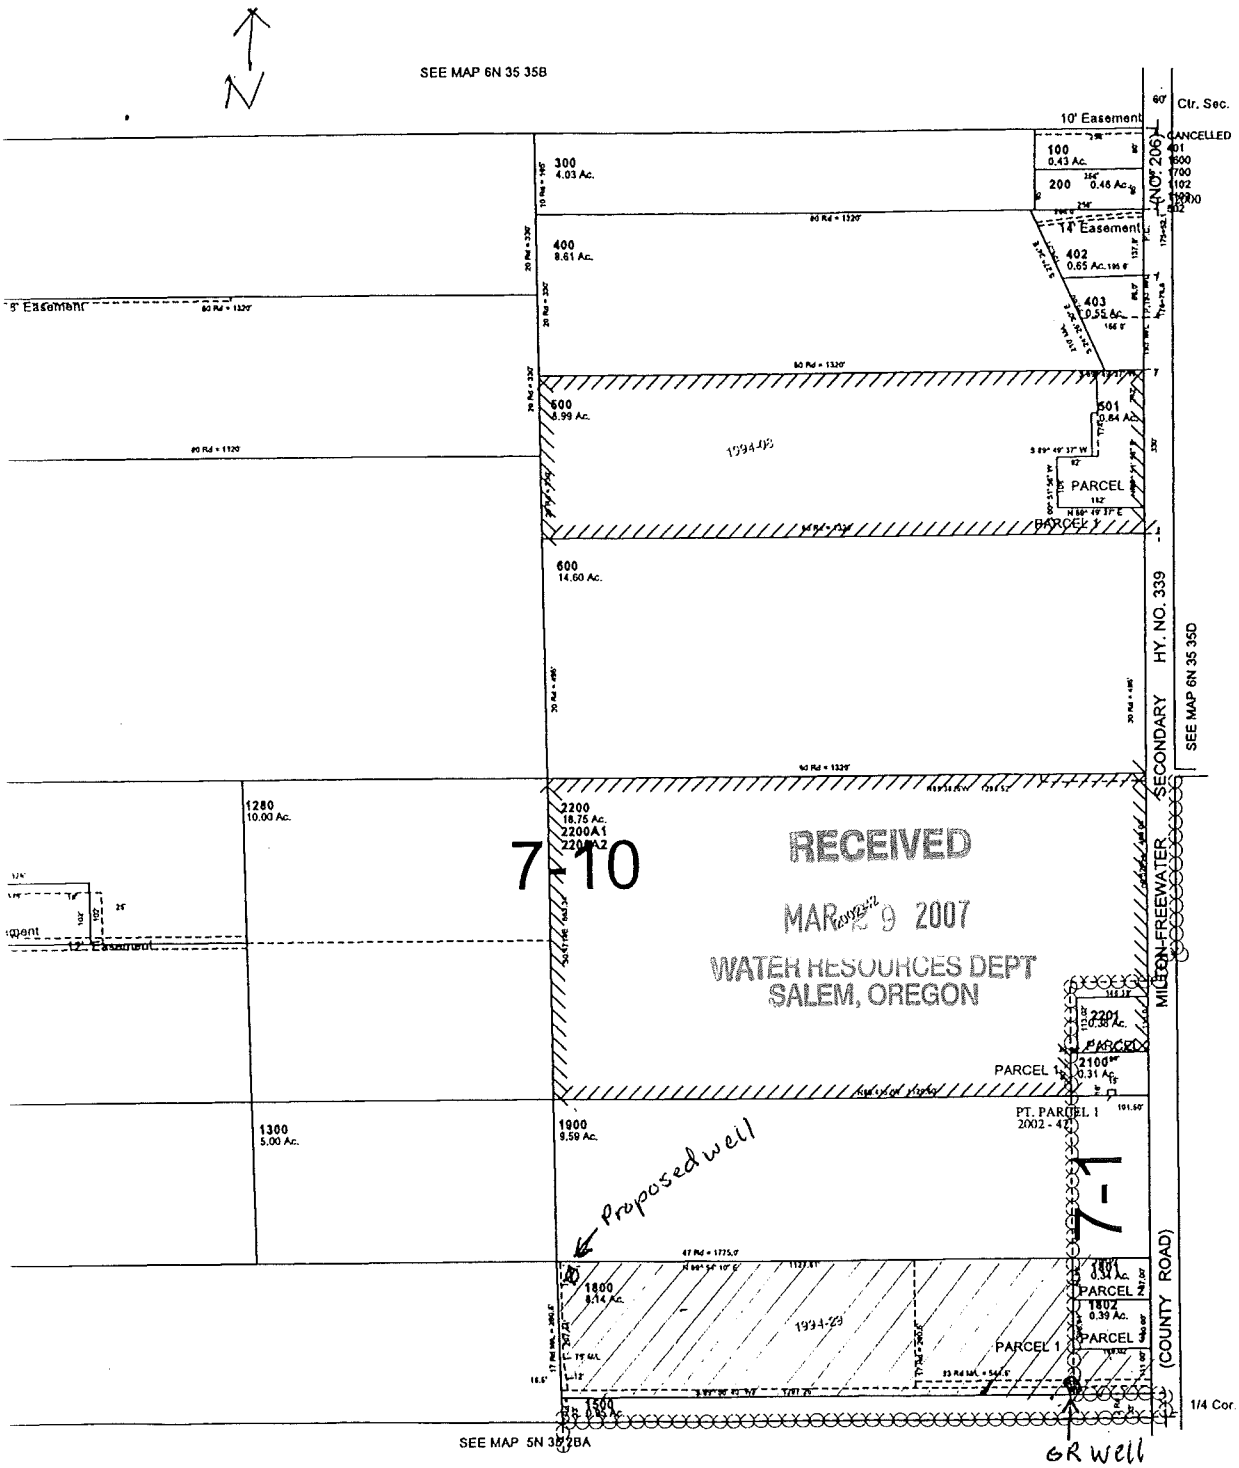

6N3535C