


L. VERNON COOK AMENDED TRANSFER APPLICATION MAP FOR
 T-11086 CHANGING THE PLACE OF USE AND ADDING
 ADDITIONAL P.O.A. FOR 4.4 ACRES OF CERT NO 80850 AND
 PERMIT S-54561
 T3N, R29E, W.M.
 AMENDED MAY 2012

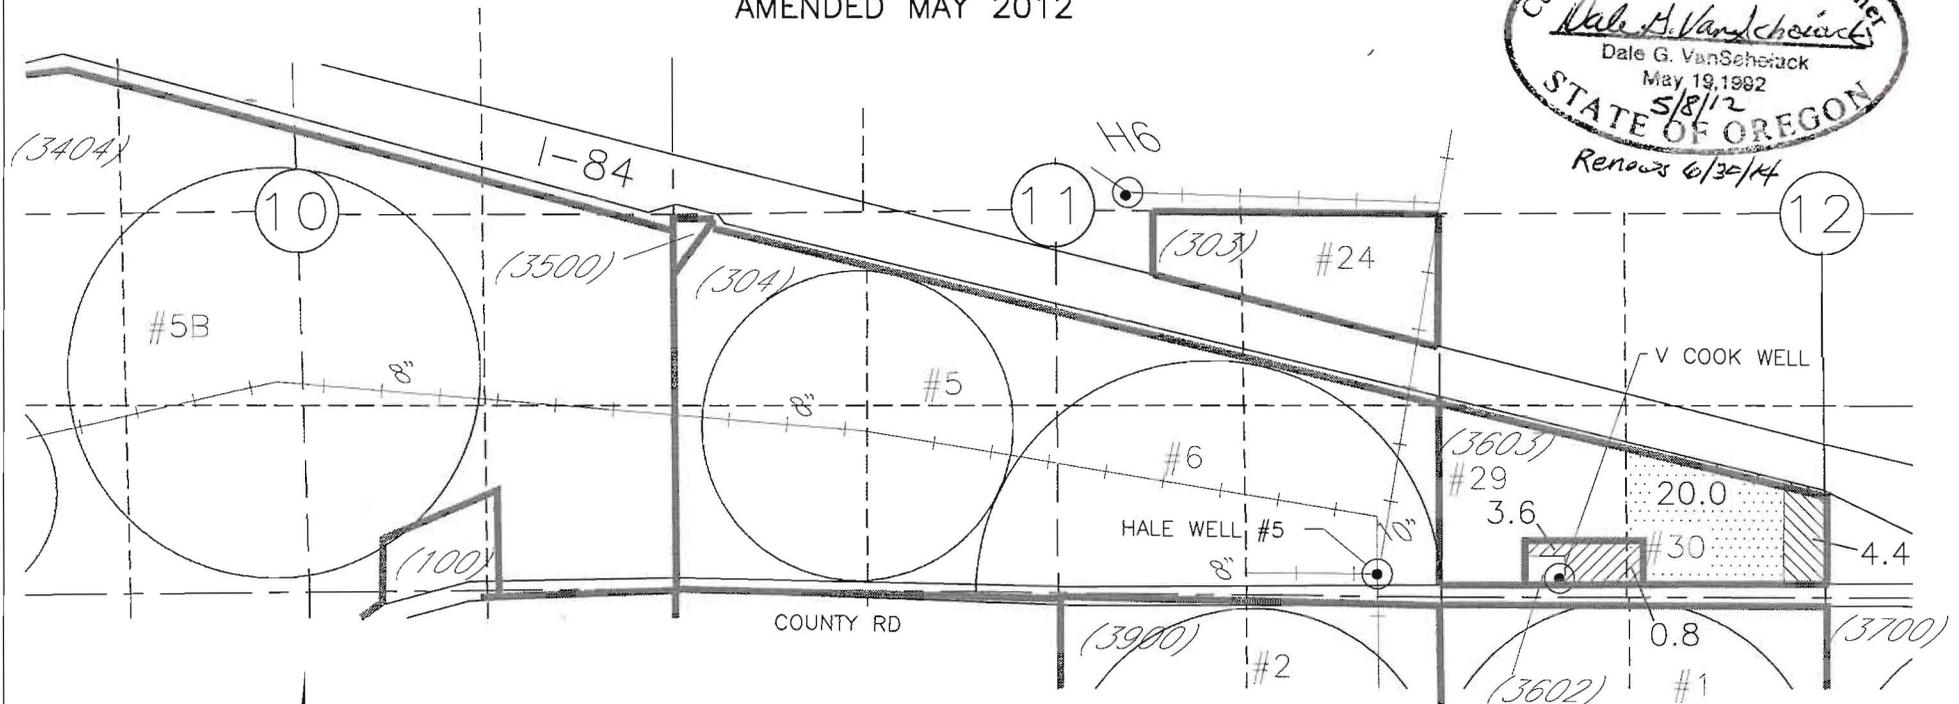

WELL LOCATIONS

AUTHORIZED P.O.A. HALE WELL #5 LOCATED 60' N
 & 590' W FROM SE COR SEC 11, T3N, R29E,
 W.M.
 PROPOSED ADDITIONAL P.O.A. V COOK WELL
 LOCATED 75' N AND 800' E FROM THE SW COR
 SEC 12, T3N, R30E, W.M.

LEGEND

-  FROM ACREAGE
-  TO ACREAGE
-  PORTION OF WATER RIGHT TO REMAIN UNCHANGED.

NOTE:
 THE PURPOSE OF THIS MAP IS TO IDENTIFY THE APPROXIMATE LOCATION
 OF THE WATER RIGHT. IT IS NOT INTENDED TO PROVIDE INFORMATION
 RELATIVE TO THE LOCATION OF PROPERTY OWNERSHIP BOUNDARY LINES.

