


PERMIT AMENDMENT APPLICATION MAP


In the name of: DAVID SETNIKER

T 8 S R 4 W, W.M.

Scale 4" = 1 mile

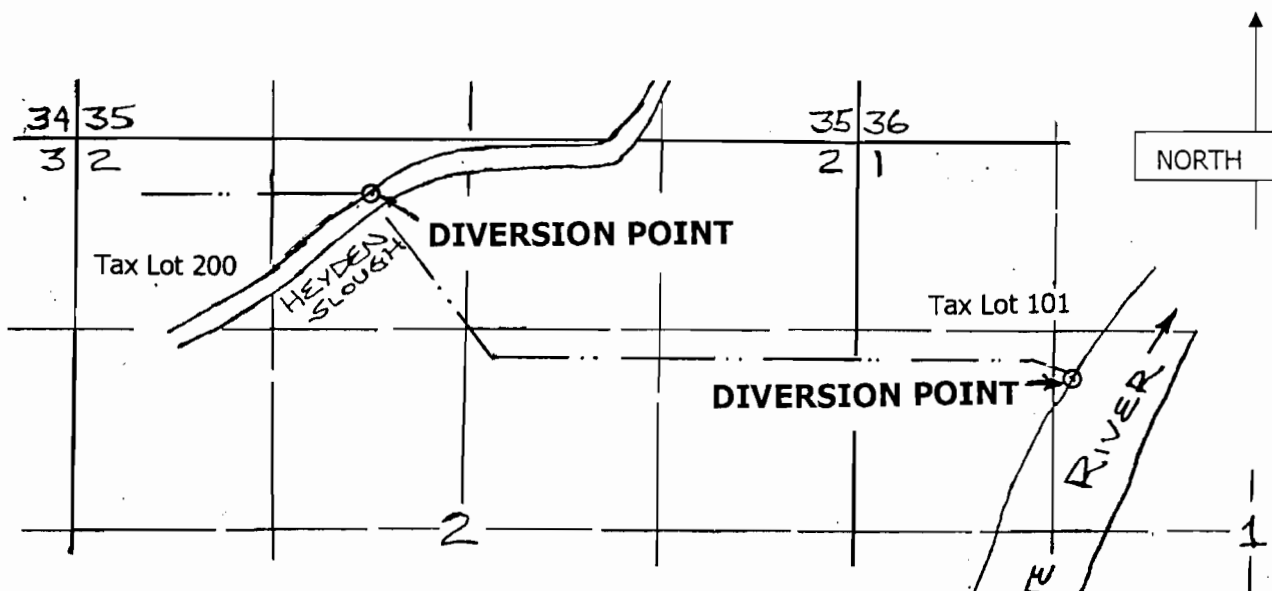

Willamette River Div Pt.: 1620' S & 1460' E from the NW cor. sec. 1
 Hayden Slough Div Pt.: 375' S & 2000' E from the NW cor. sec. 1
 Both within T 8 S R 4 W, WM

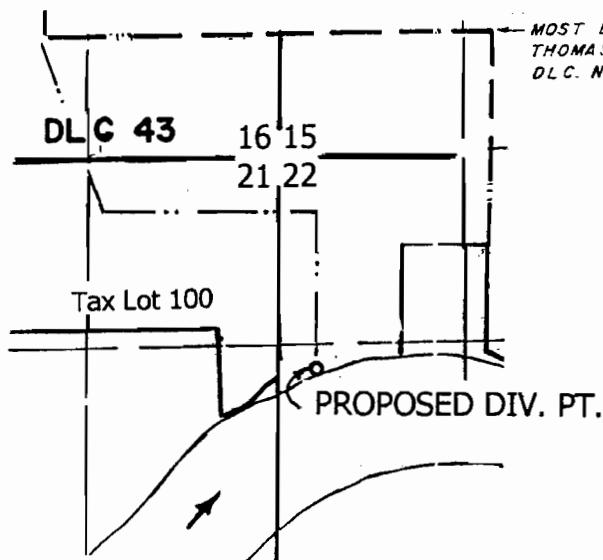

MOST E'ly. || N.E. COR.
 THOMAS L. || BURBANK Jr.
 D.L.C. NO. 43


RECEIVED
 MAY 08 2012

WATER RESOURCES DEPT
 SALEM, OREGON

Pipeline ———
 Section line ———
 DLC line - - - - -
 1/4 1/4 line ———
 tax lot line ———

PROPOSED WILLAMETTE RIVER DIV PT.: 2300' S & 1150' W
 from the E'ly NE cor. DLC 43 T 8 S, R 4 W, WM

This map is not intended to provide legal
 dimensions or locations of property ownership lines.

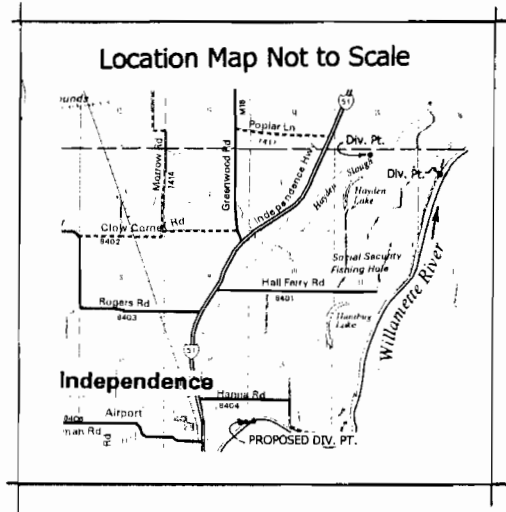

T.7S. & 8S., R.4W., W.M.

Scale: 1" = 1320'

NOTE: MAP IS FOR
PURPOSE OF IDENT-
IFYING LOCATION OF
WATER RIGHT AND HAS
NO INTENT TO DIMEN-
SION OR LOCATE PROPERTY
OWNERSHIP LINES.

GREENWOOD RD

POPLAR LANE

Supply to Muller

Cert 34714

Well #1

Well #2

Div. Pt.

HEYDEN SLOUGH

Div. Pt.

WILLAMETTE RIVER

Corrections by
Certified Water Right Examiner
#229
Larry W. Jebousek
LARRY W. JEBOUSEK
Dec. 7, 1989
STATE OF OREGON
Oct. 14 & 15, 1993

1960' N 1370' E S
Well #1 located 1050' S & 1100' E from NW corner Section 1
Well #2 located 200' N & 2000' E from SW corner Section 35.
Heyden Slough: 320' S & 2000' E from NW corner Section 2
Willamette R.: 1660' S & 1400' E from NW corner Section 1

RECEIVED

MAY 08 2012

WATER RESOURCES DEPT
SALEM, OREGON

David Setniker

Application Map

Application #: G-12688
S-70919

Permit #:

52004

Certified Water Right Examiner
#058
James Grimm
James Grimm
Nov. 19, 1987
STATE OF OREGON

Area Irrigated
Wells #1 & #2

RECEIVED

OCT 9 1991

WATER RESOURCES DEPT
SALEM, OREGON

RECEIVED

MAY 4 1994

WATER RESOURCES DEPT
SALEM, OREGON