
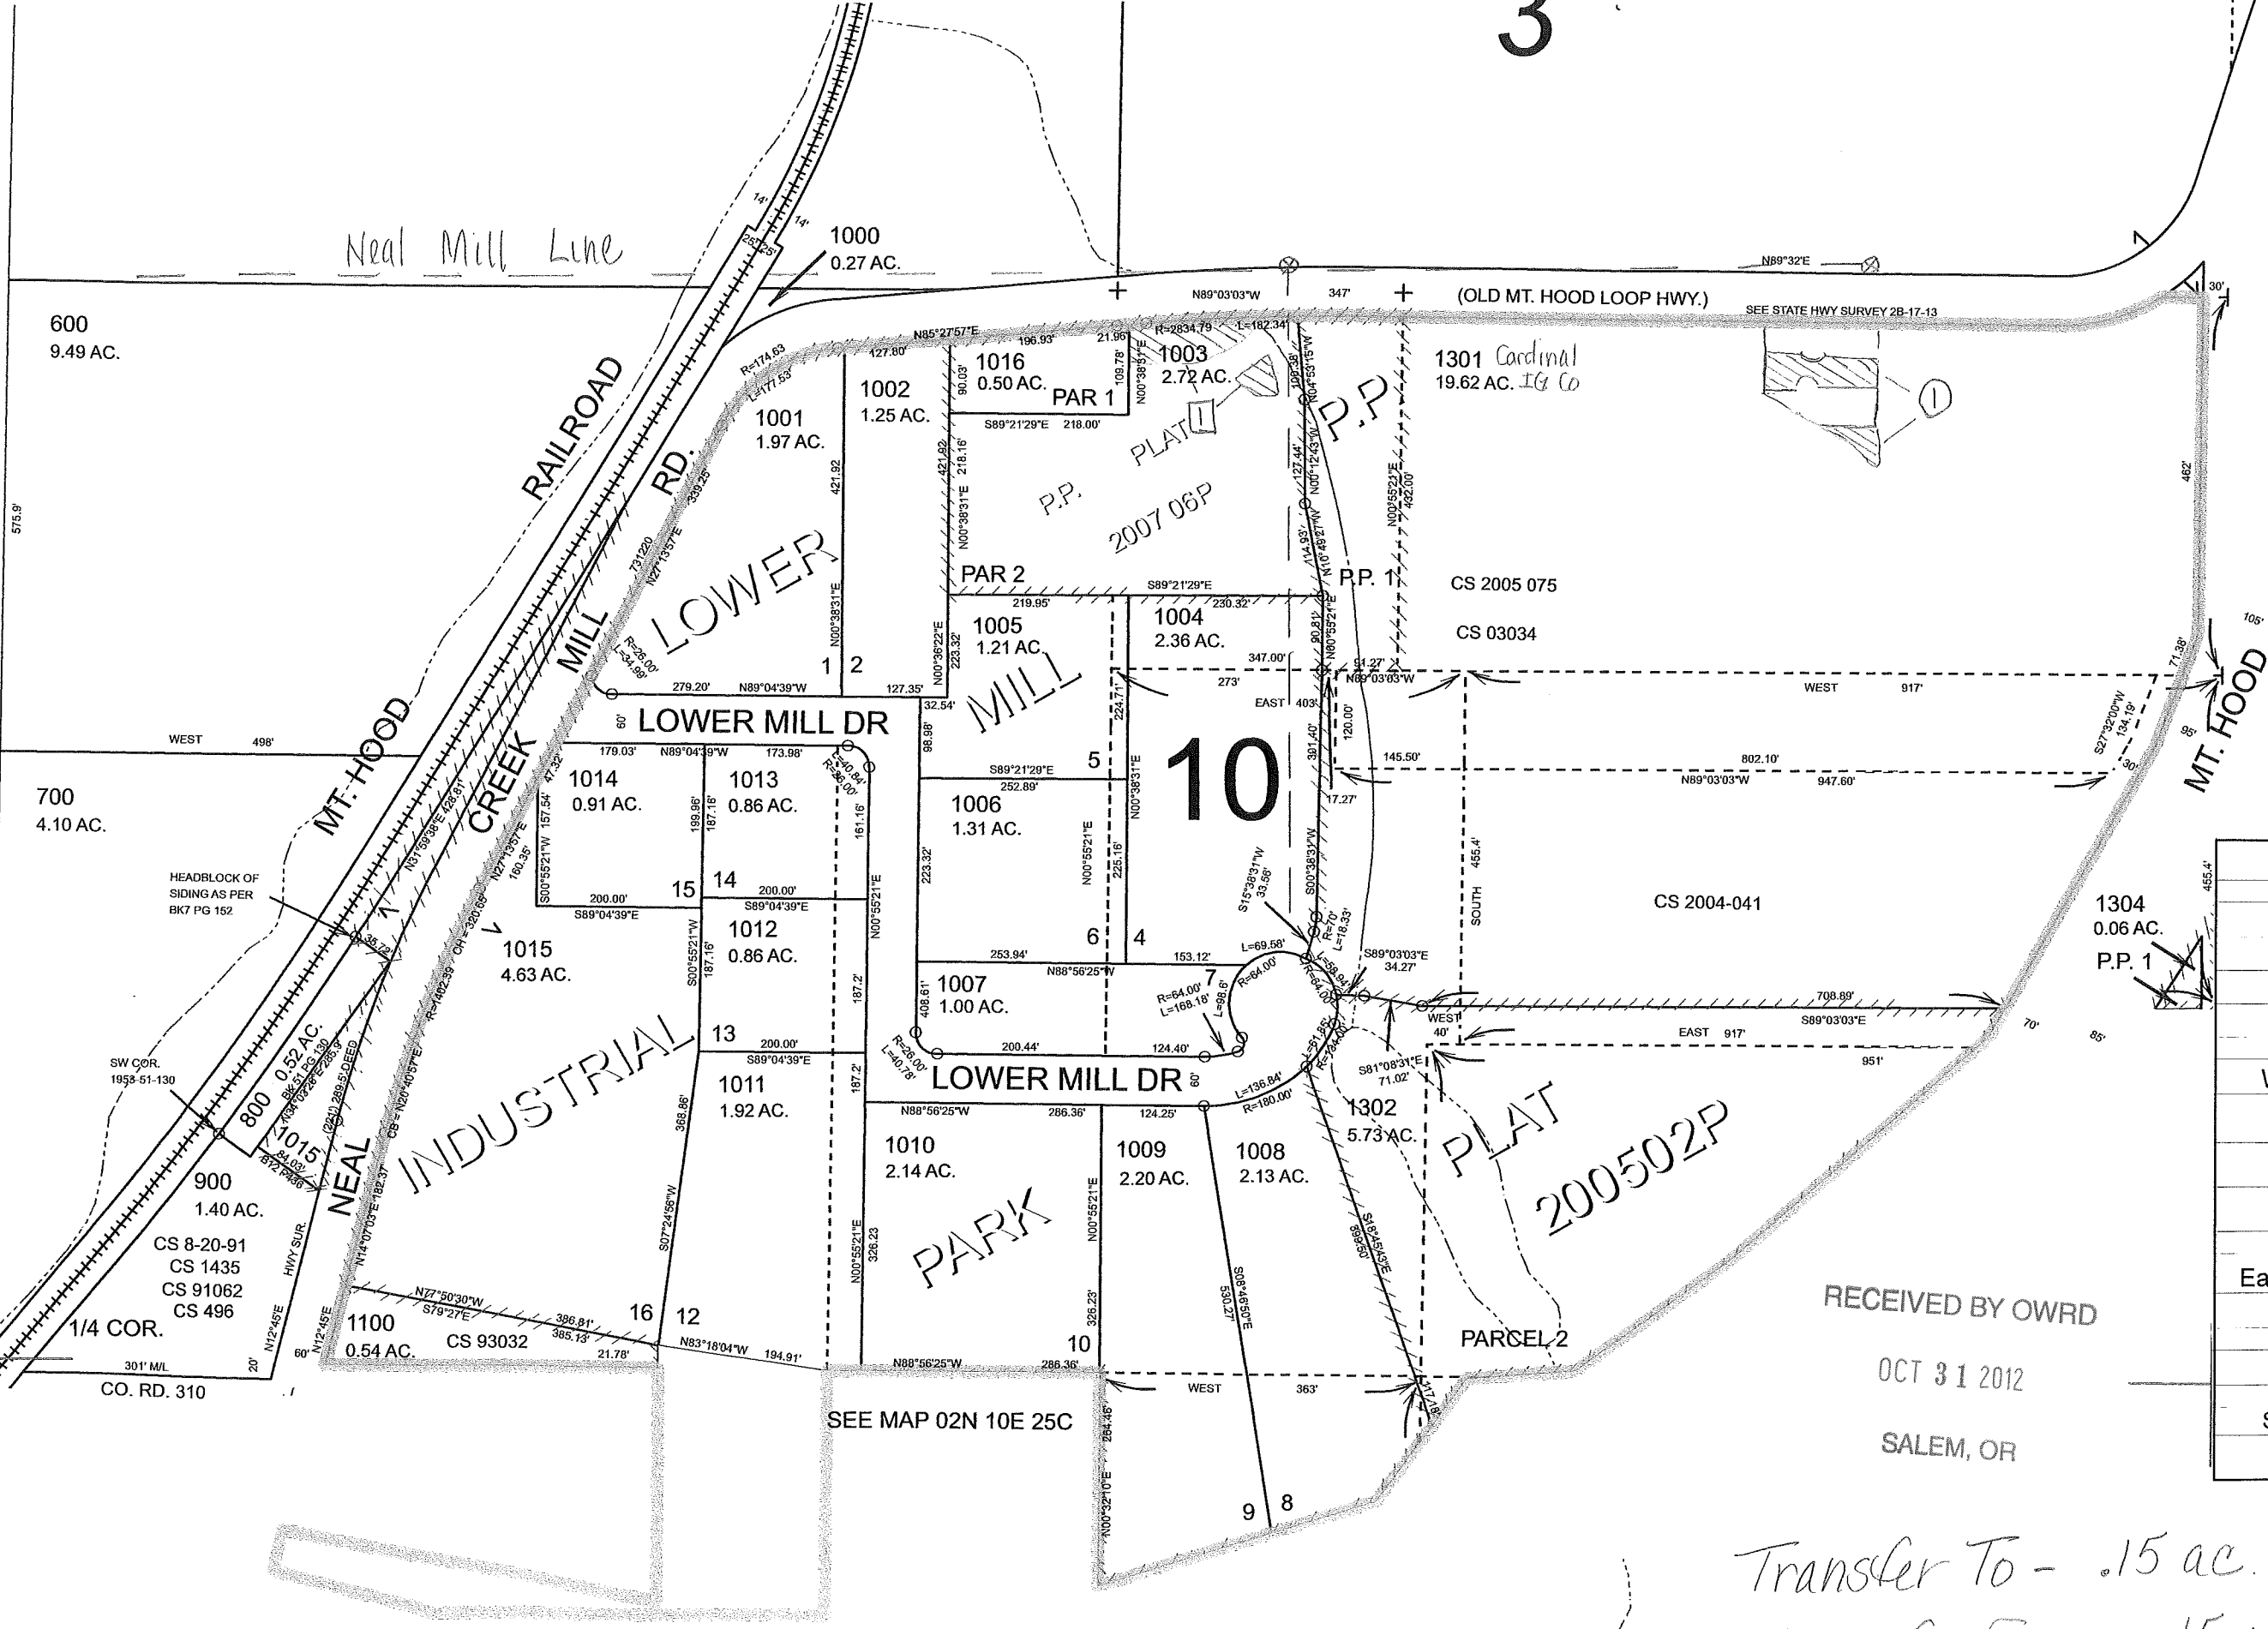


SEE MAP 02N 10E 26

SEE MAP 02N 10E 101

3

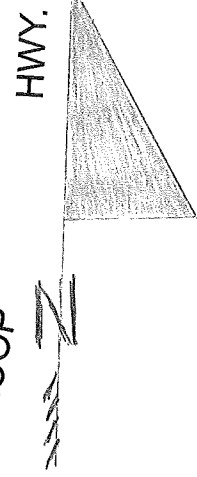


Map Legend	
Map Symbols	
	Valve
	Pipeline
	Property Line
Water Right Certificate	
	C-84803
	Transfer To
	Transfer From
East Fork Irrigation District Hood River, Oregon	
Section 2N-10E-25B	
Scale 1" = 200' cms	

RECEIVED BY OWRD
OCT 31 2012
SALEM, OR

Transfer To - .15 ac.
Transfer From - .15 ac.

02N

FOR ONLY

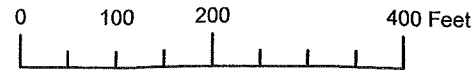


NW 1/4 SECTION 25 T02N R10E WM HOOD RIVER COUNTY

1" = 200'

02N 10E 25 B

- CANCELLED NOS.
- 1200
 - 1300
 - 1303
 - 1400
 - 1500

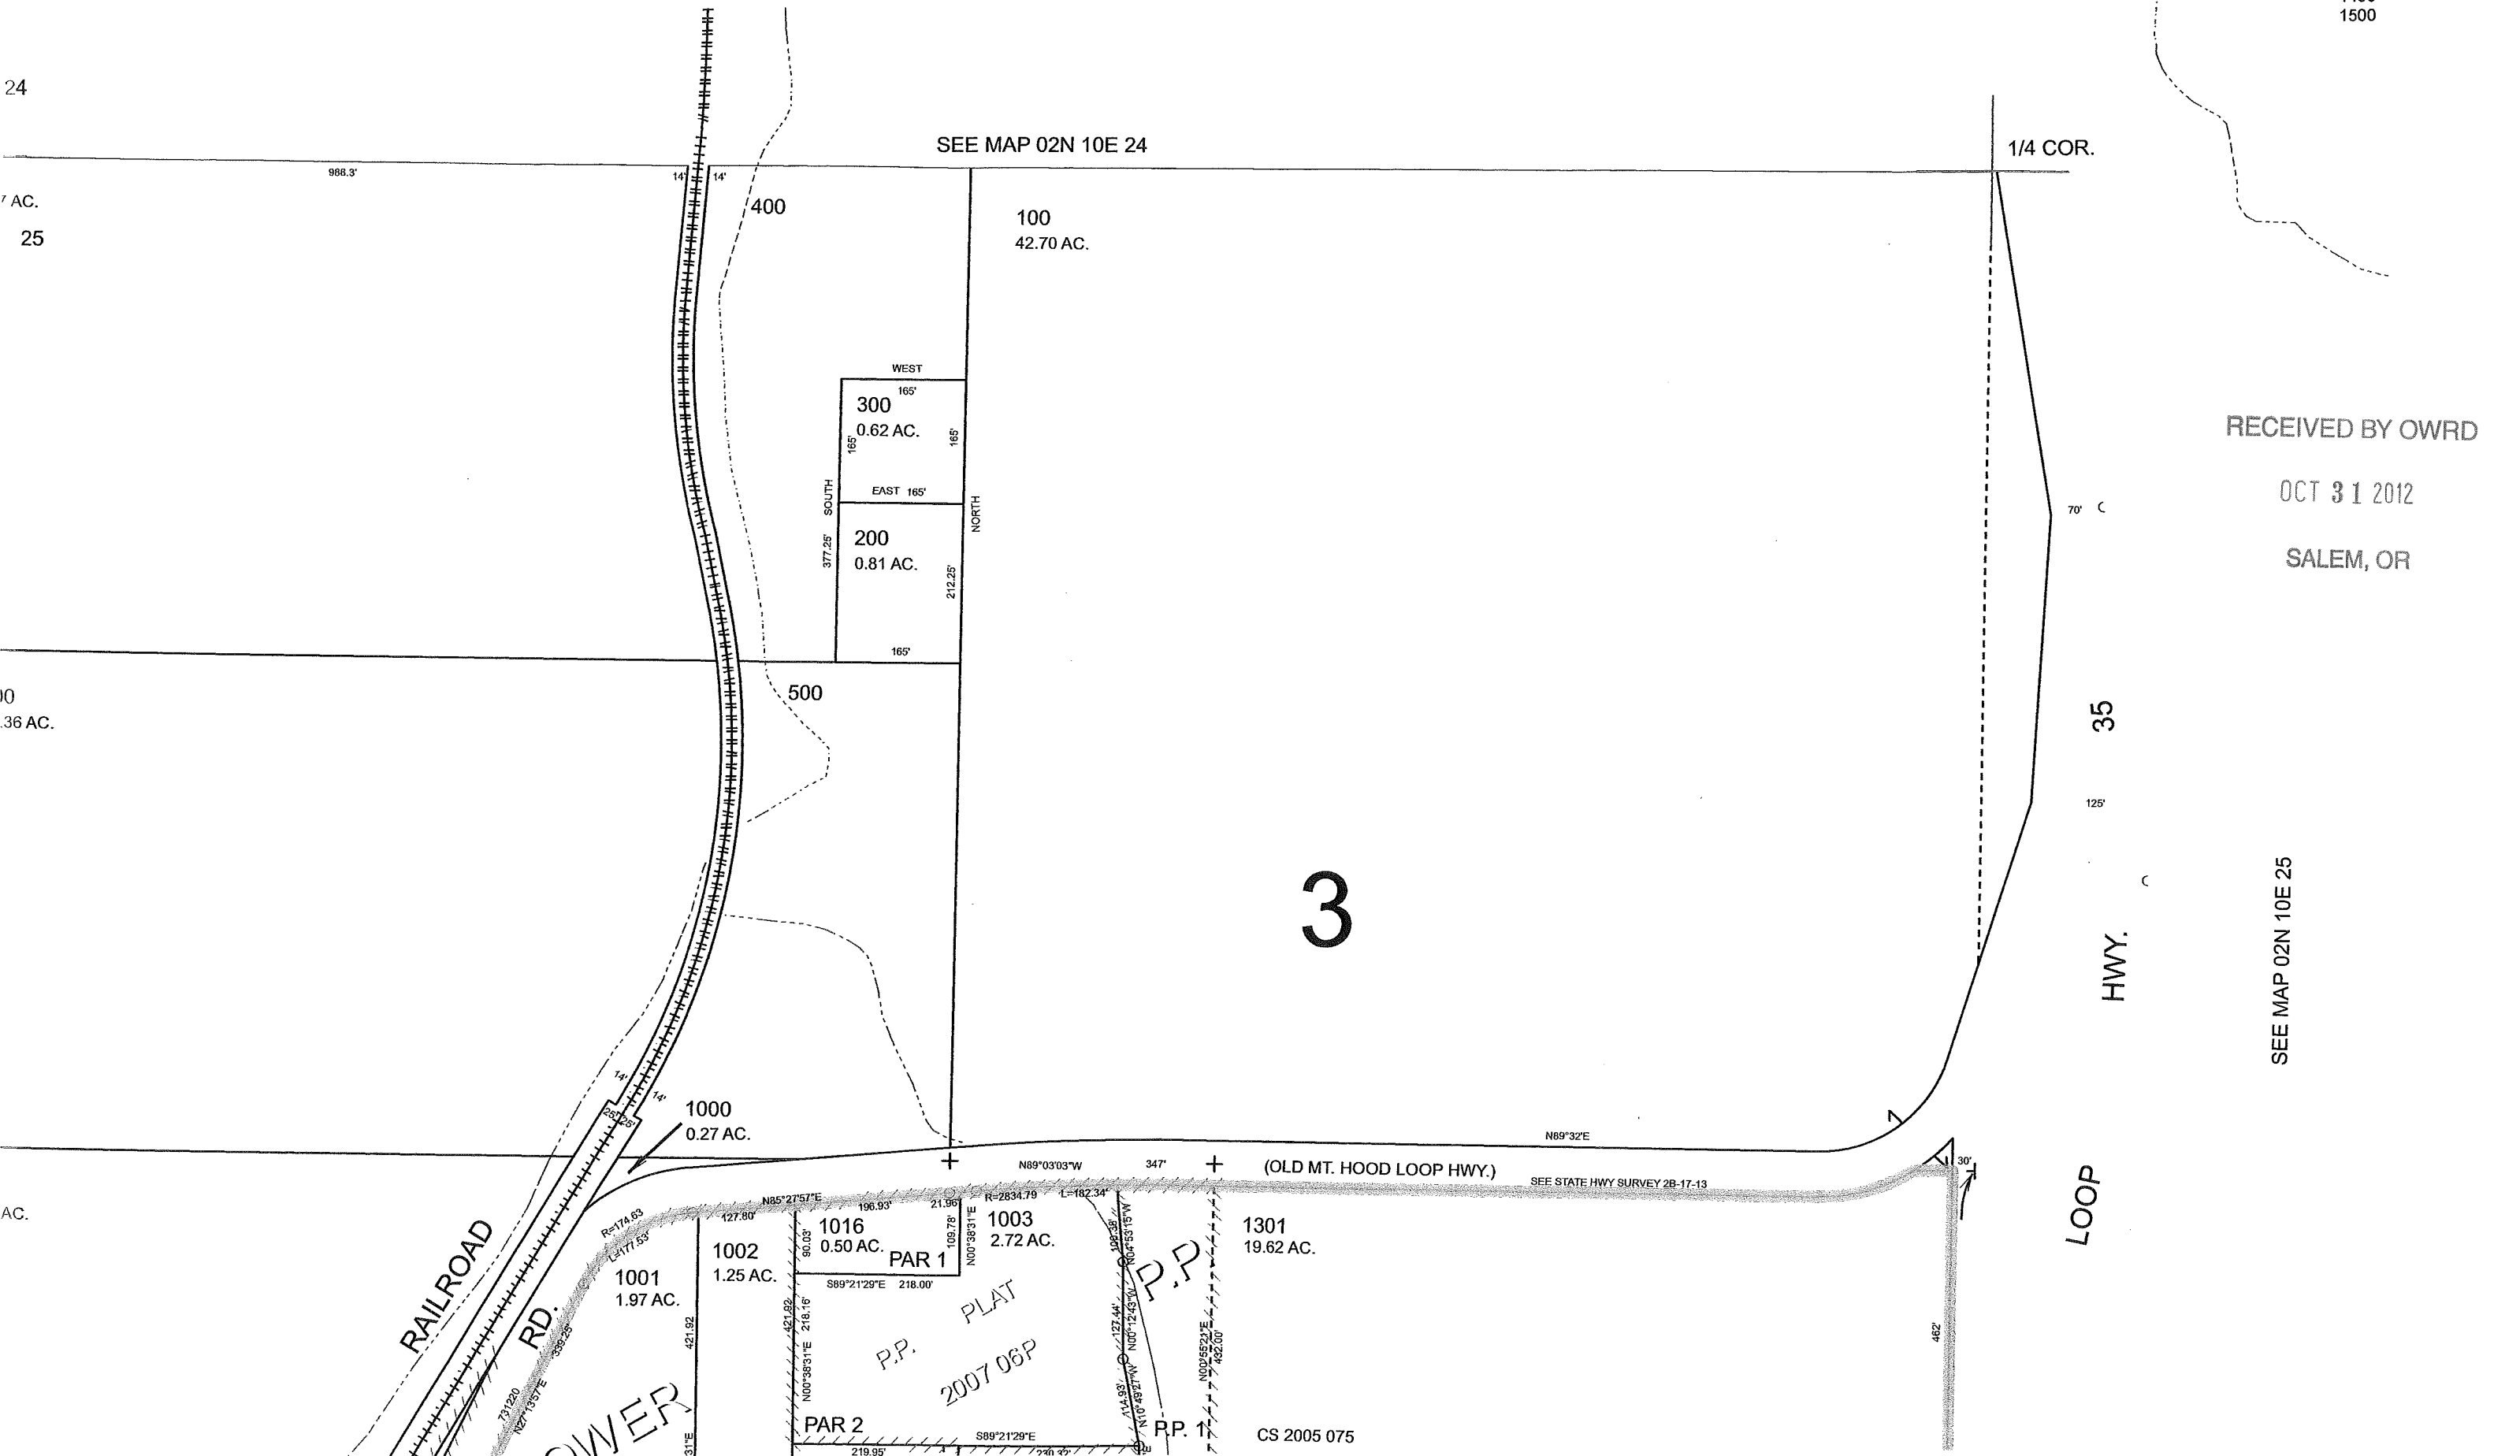

RECEIVED BY OWRD
OCT 31 2012
SALEM, OR

SEE MAP 02N 10E 25

SEE MAP 01N 10E 10

SEE MAP 01N 10E 11



RECEIVED BY OWRD

OCT 31 2012

SALEM, OR

Map Legend

Map Symbols

⊗ Valve

--- Pipeline

— Property Line

Water Right Certificate

C-80929


Transfer To

Transfer From

East Fork Irrigation District
Hood River, Oregon

Section 1N-10E-10D

Scale 1" = 200' cms

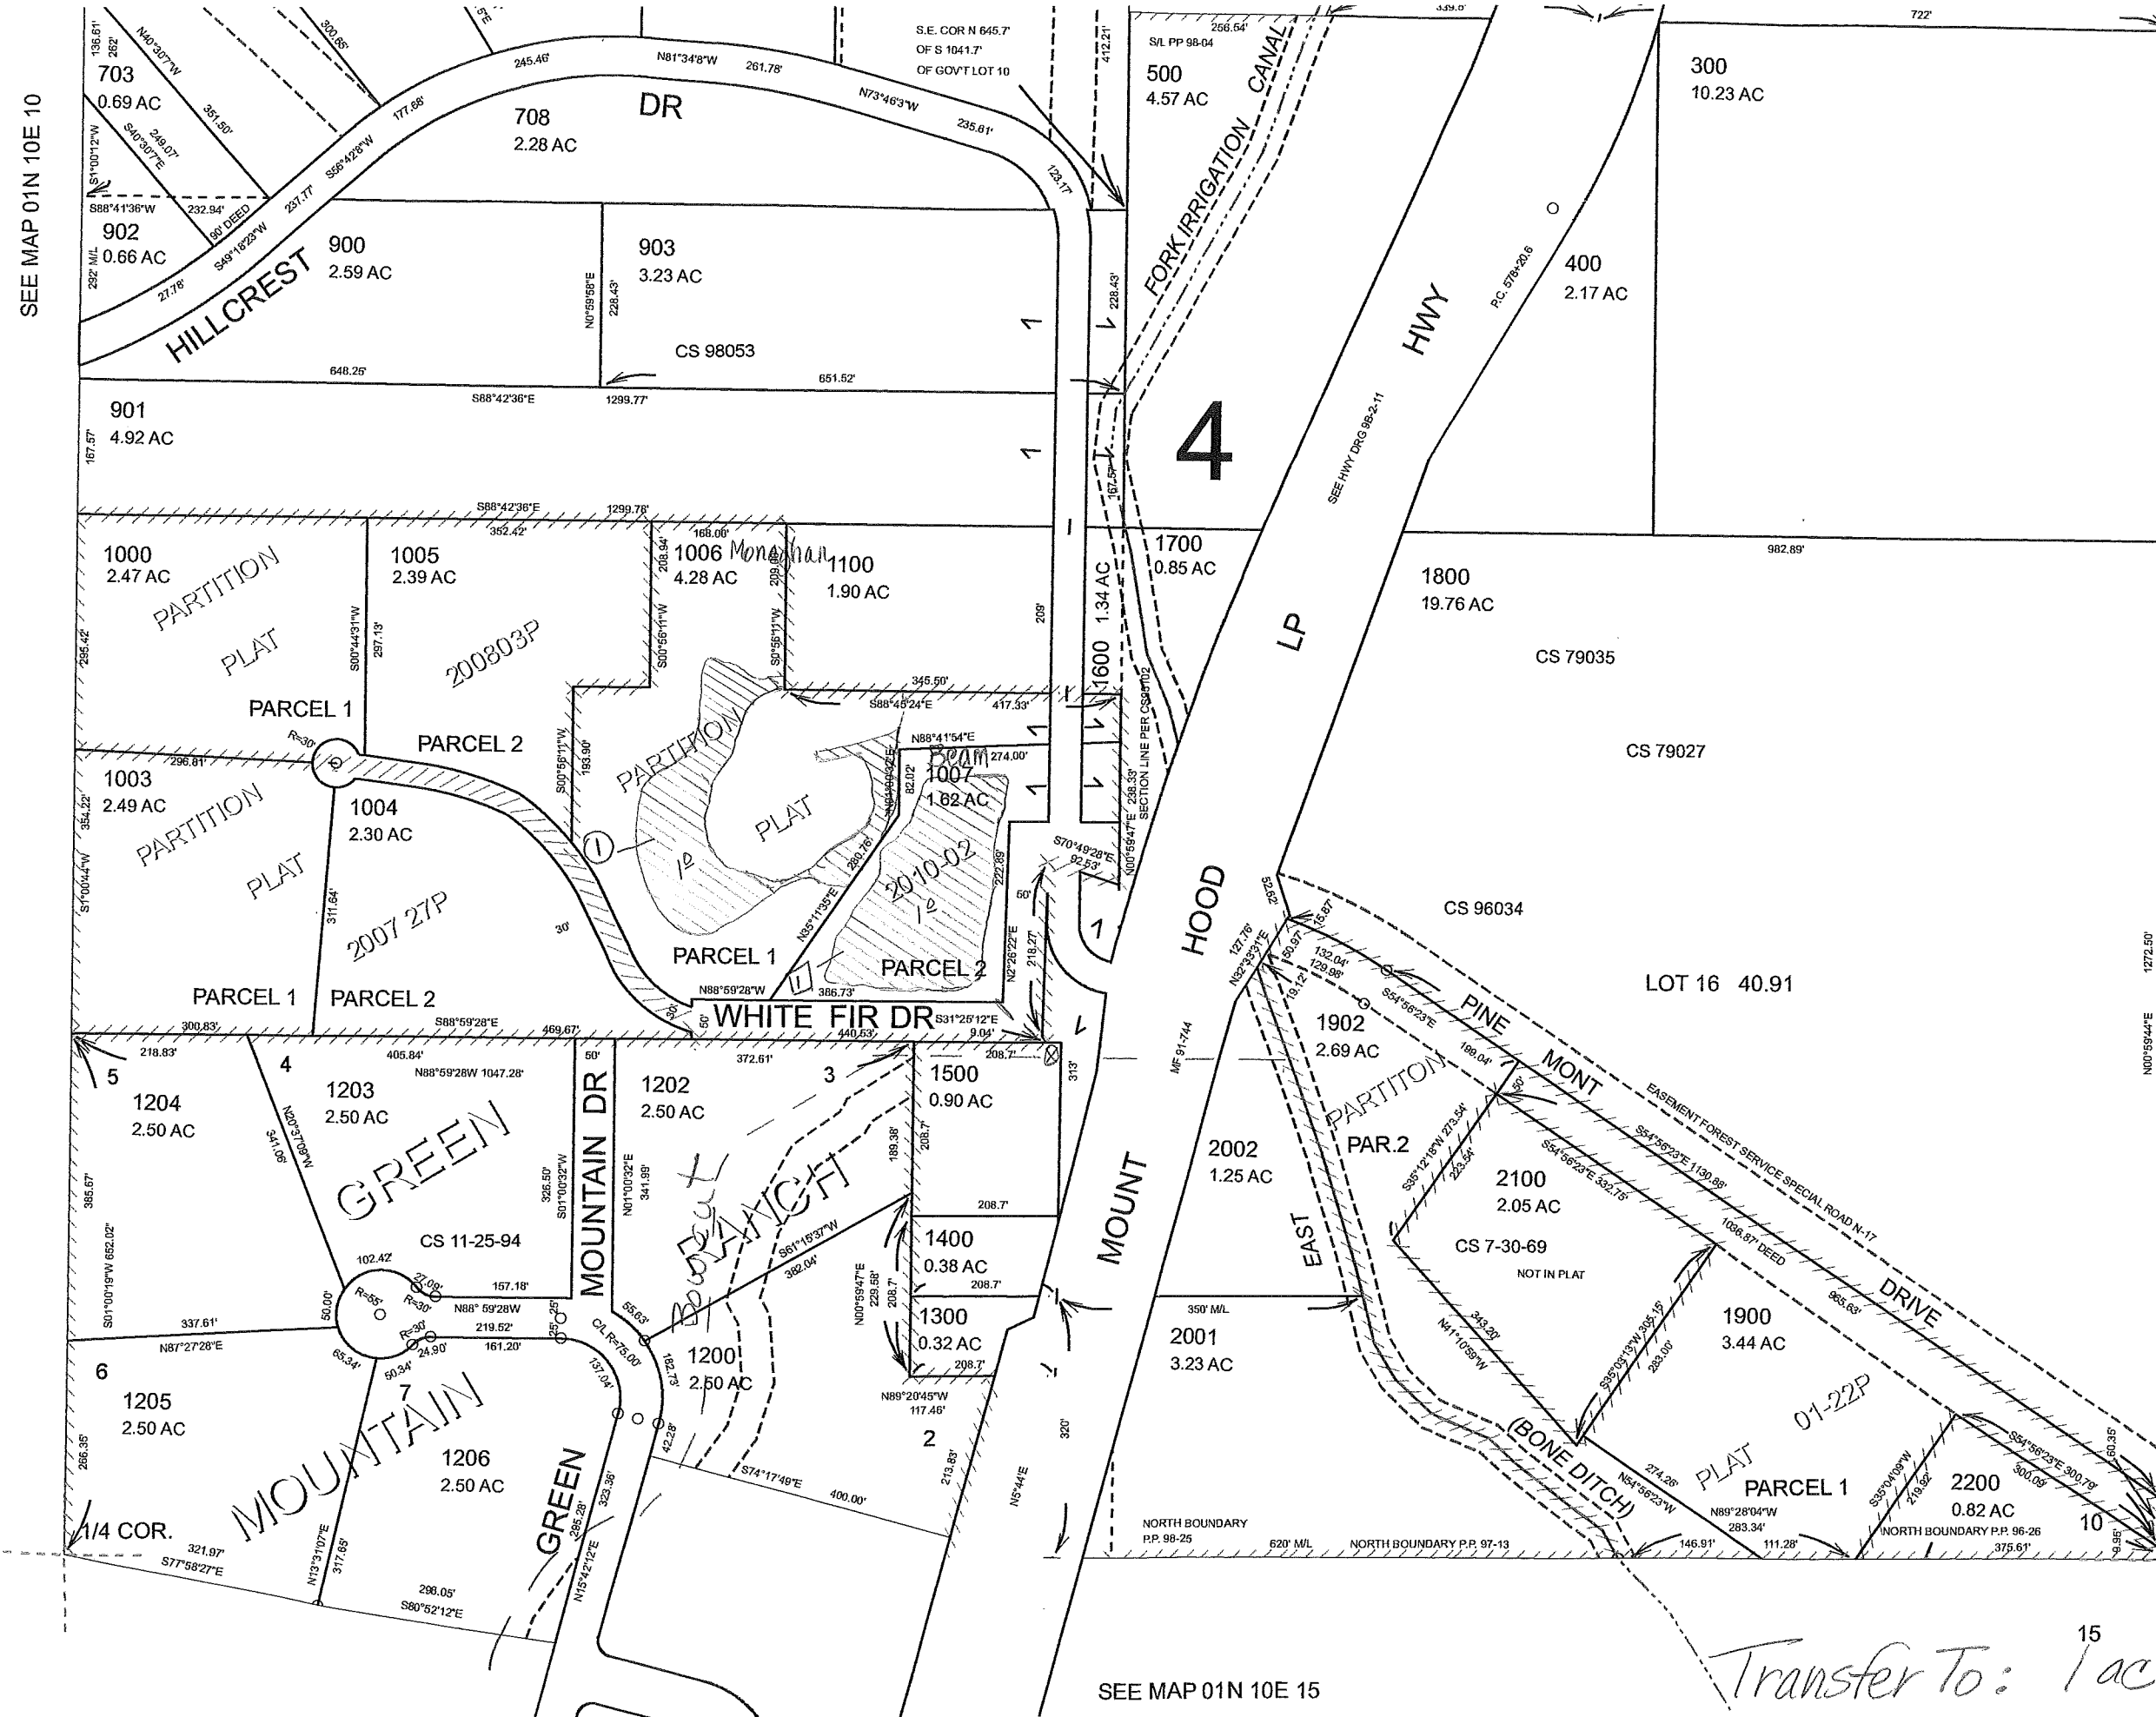


SEE MAP 01N 10E 15

Transfer To: 1 ac.
Transfer From: 1 ac.

Revi
01N'

PREPARED FOR
PURPOSE ONLY

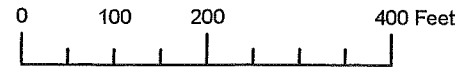


S.E. 1/4 SEC. 10 T.1N. R.10E. W.M. HOOD RIVER COUNTY

1" = 200'

01N10E10D

CANCELLED:

- 705
- 1001
- 1002
- 1201
- 1901
- 2000

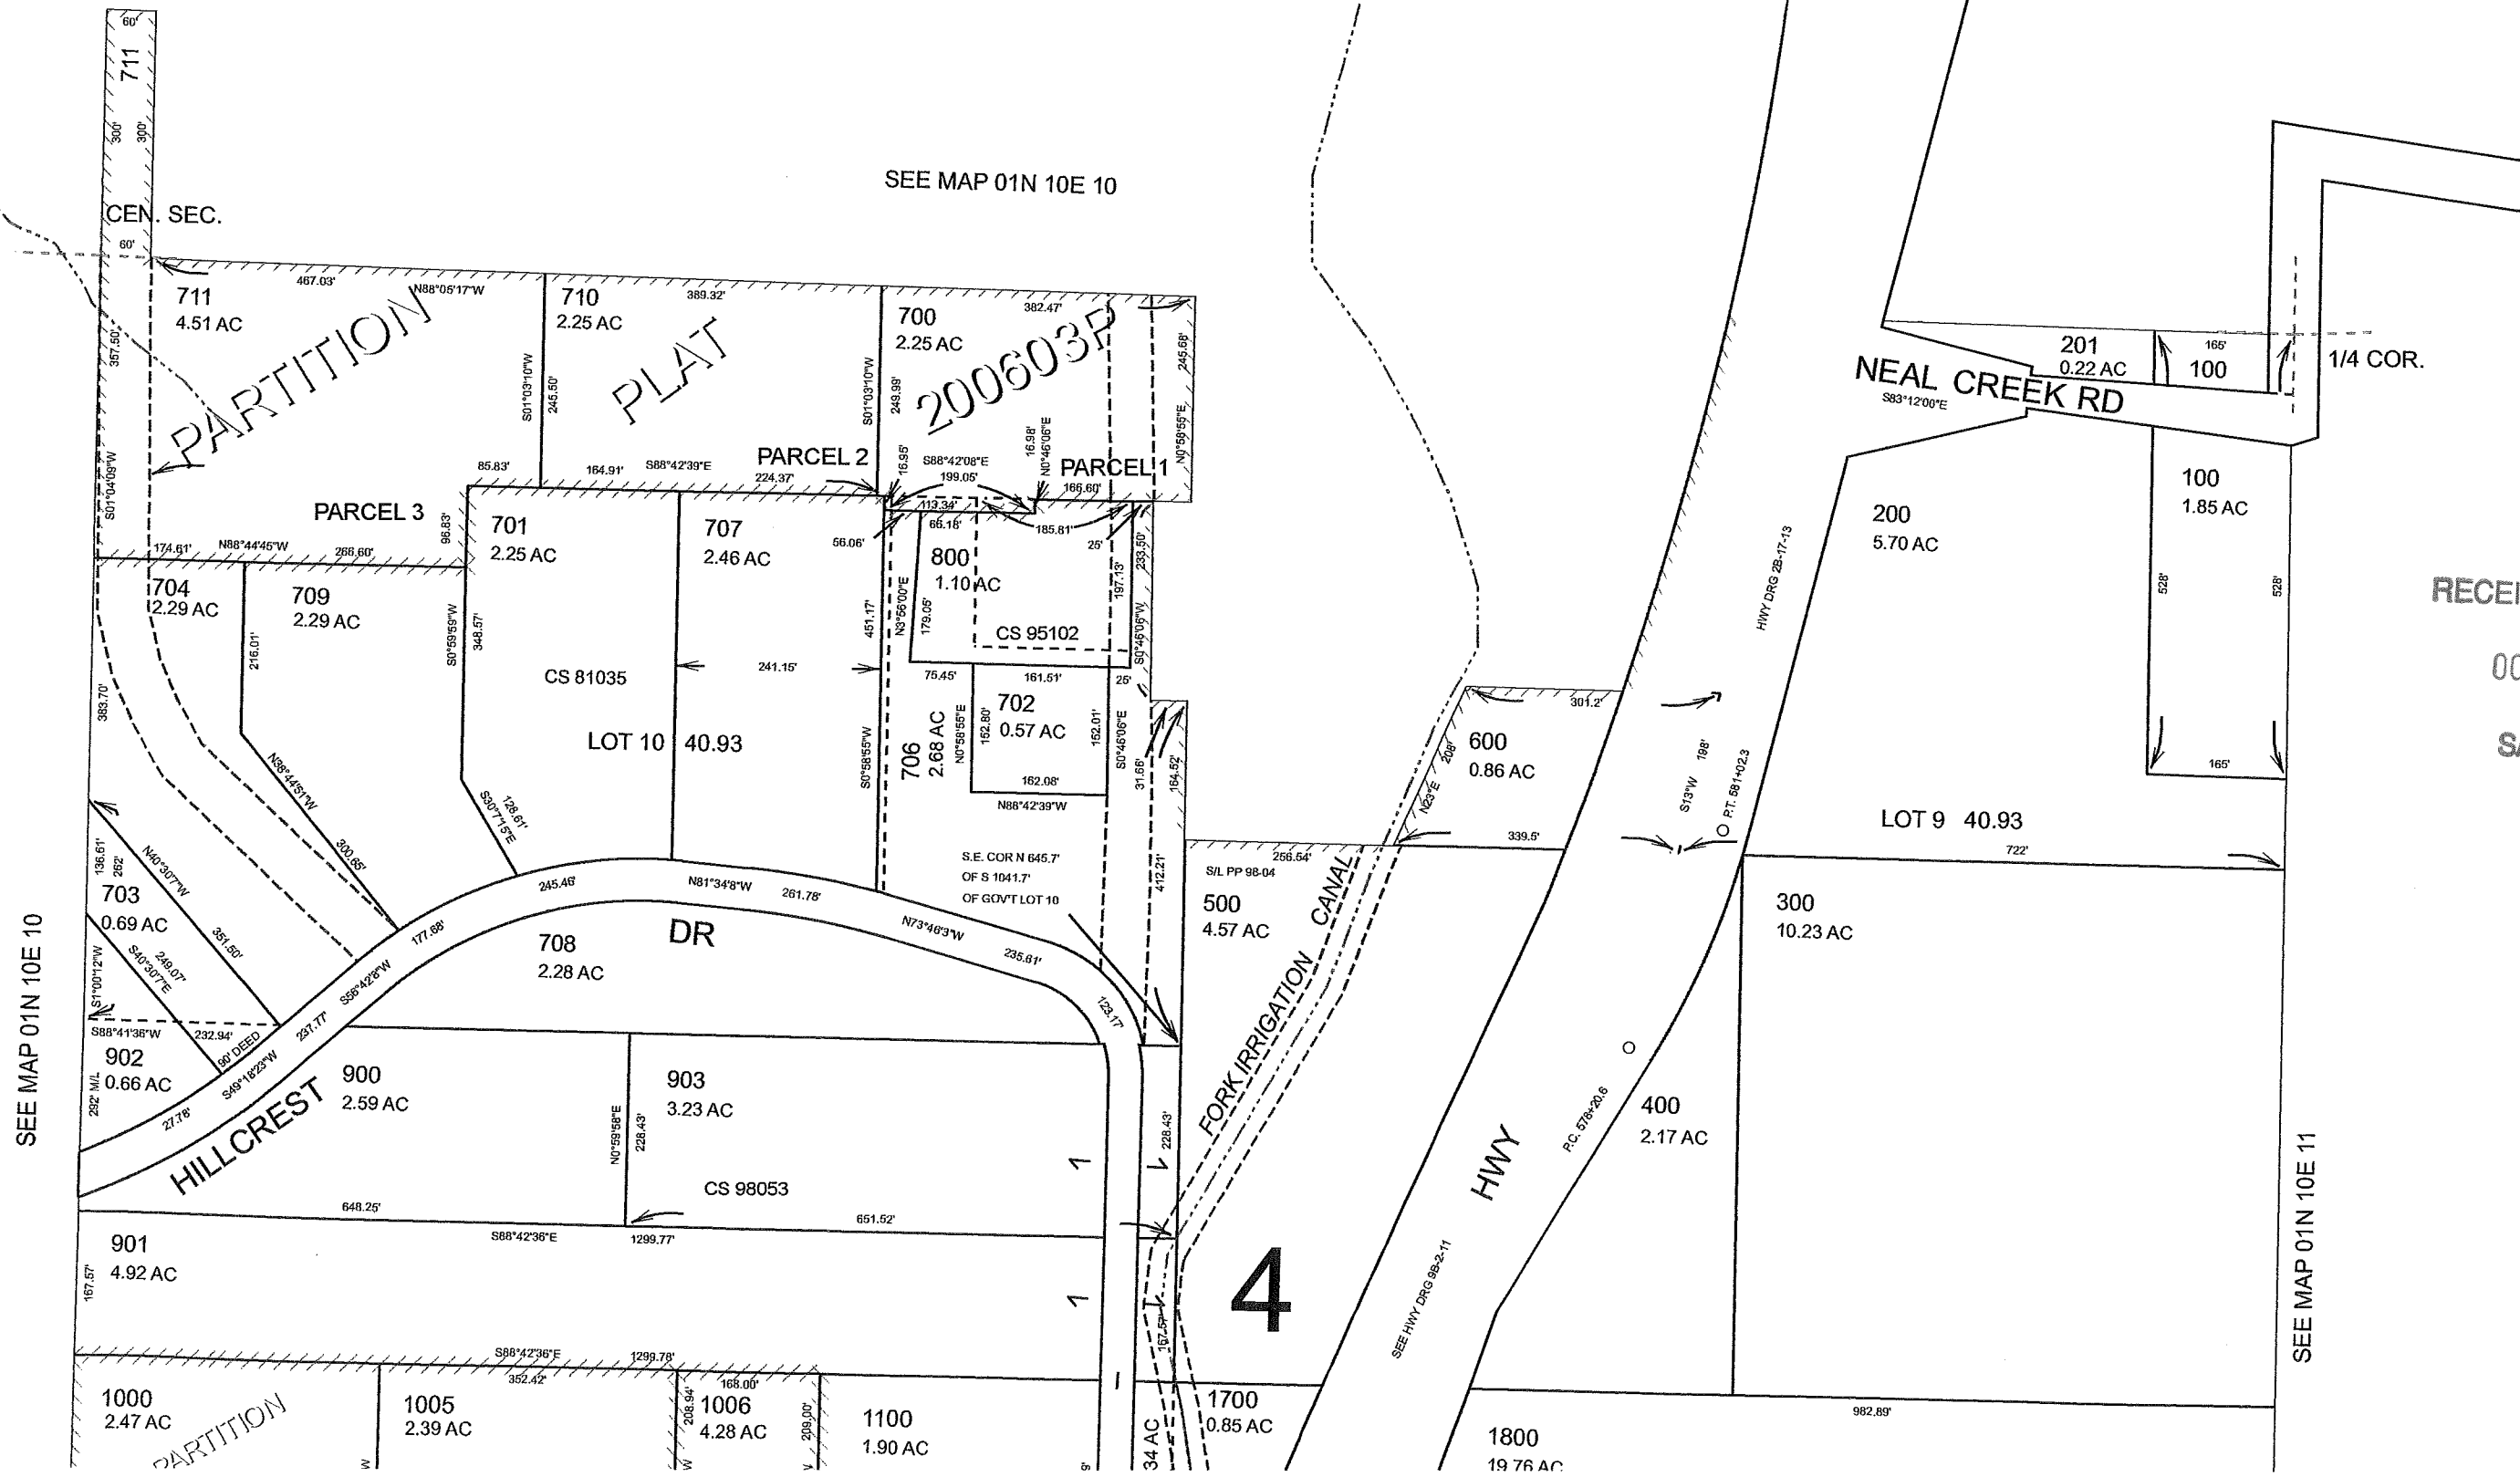

RECEIVED BY OWRD
OCT 31 2012
SALEM, OR