


MD
INITIAL

mls
INITIAL

Tumalo Irrigation District

Mel & Marsha Stout off
map .50 acres

16-12-17-NE/NE-00101

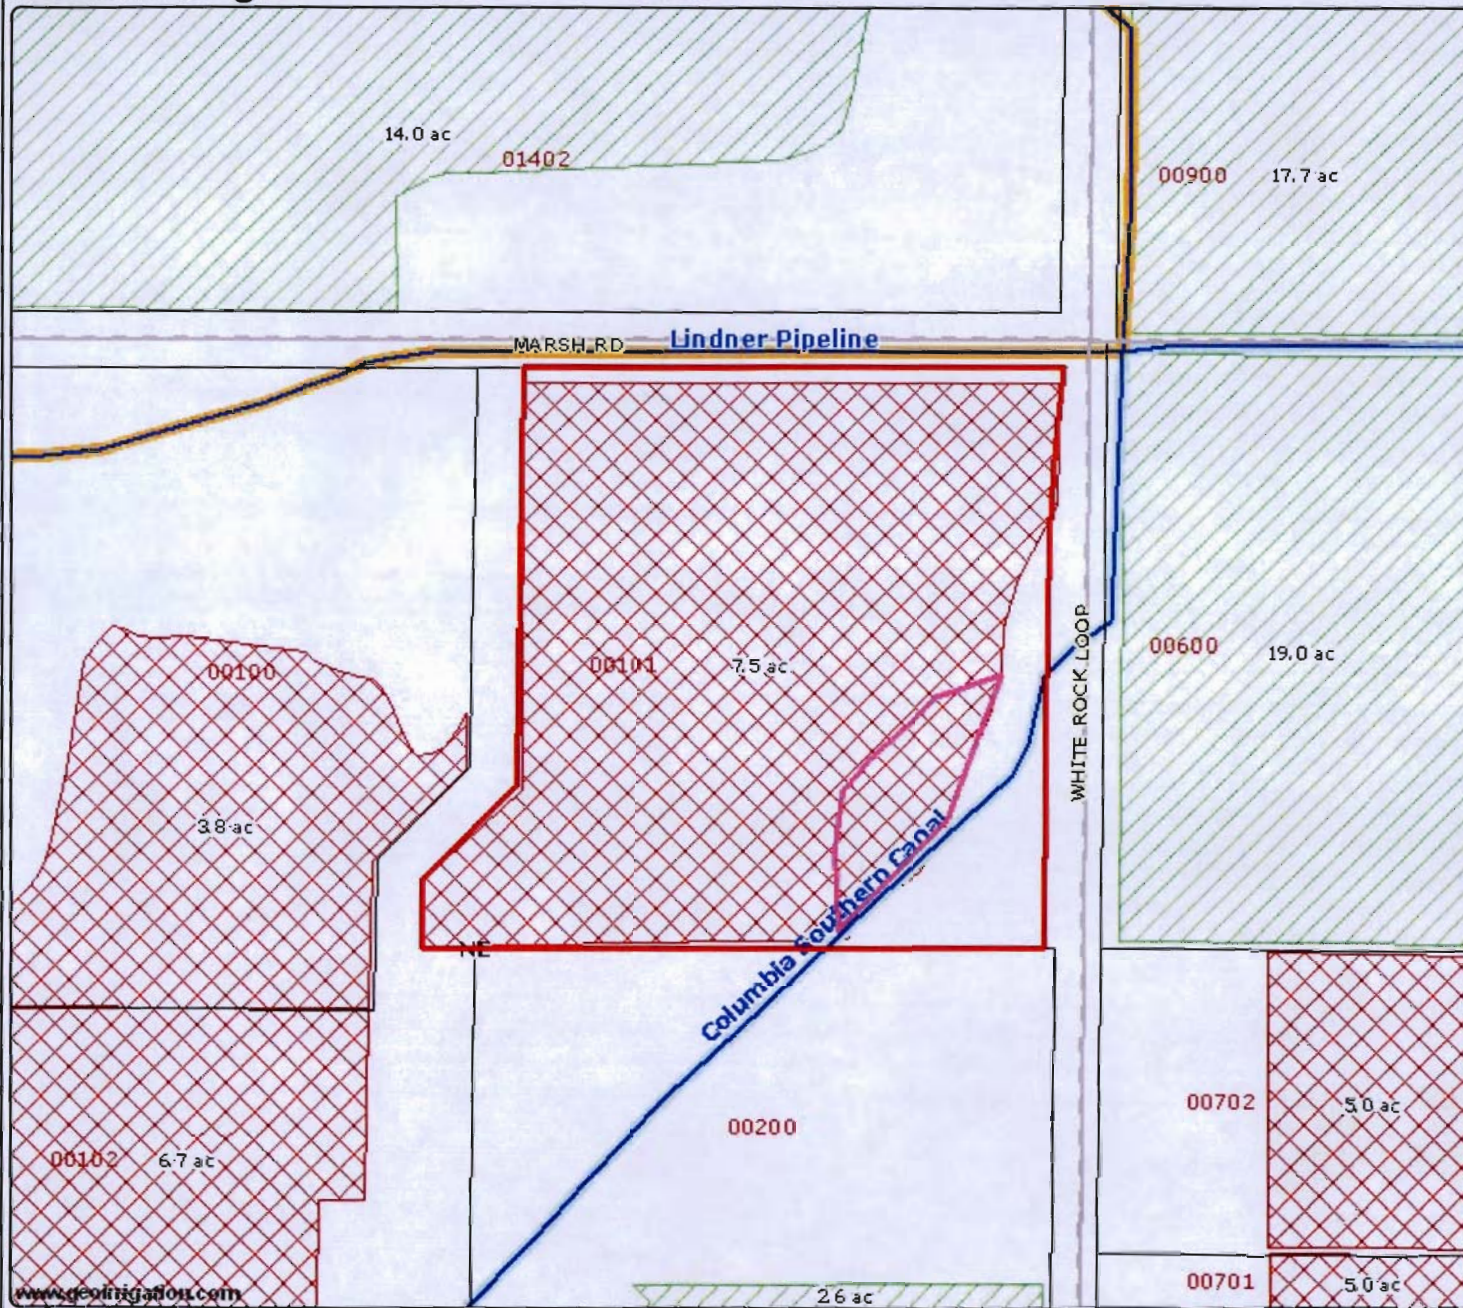

- Cities
- District Boundary
- Highways
- Major Roads
- Road Labels
- Township Range
- Sections
- Section Labels
- Quarters
- Quarter Labels
- Quarter Quarters
- Quarter Quarter Labels
- Lot Labels
- Taxlots
- Canal All
- Canal Closed
- Canal Open
- Reservoir
- Unmapped Rights Labels
- Unmapped Rights
- Mapped Rights Labels
- Primary 74146 7
- Primary 76106
- NHD Stream/River Area

RECEIVED BY OWRD

DEC 19 2012



Scale 1" = 200'
SALEM, OR
Created: 1/27/2012


www.geoirrigation.com

DISCLAIMER: This map is intended for display purposes only and is not intended for any legal representations. There are no warranties, expressed or implied, that accompany this product.

MS
INITIAL

mls
INITIAL

Tumalo Irrigation District

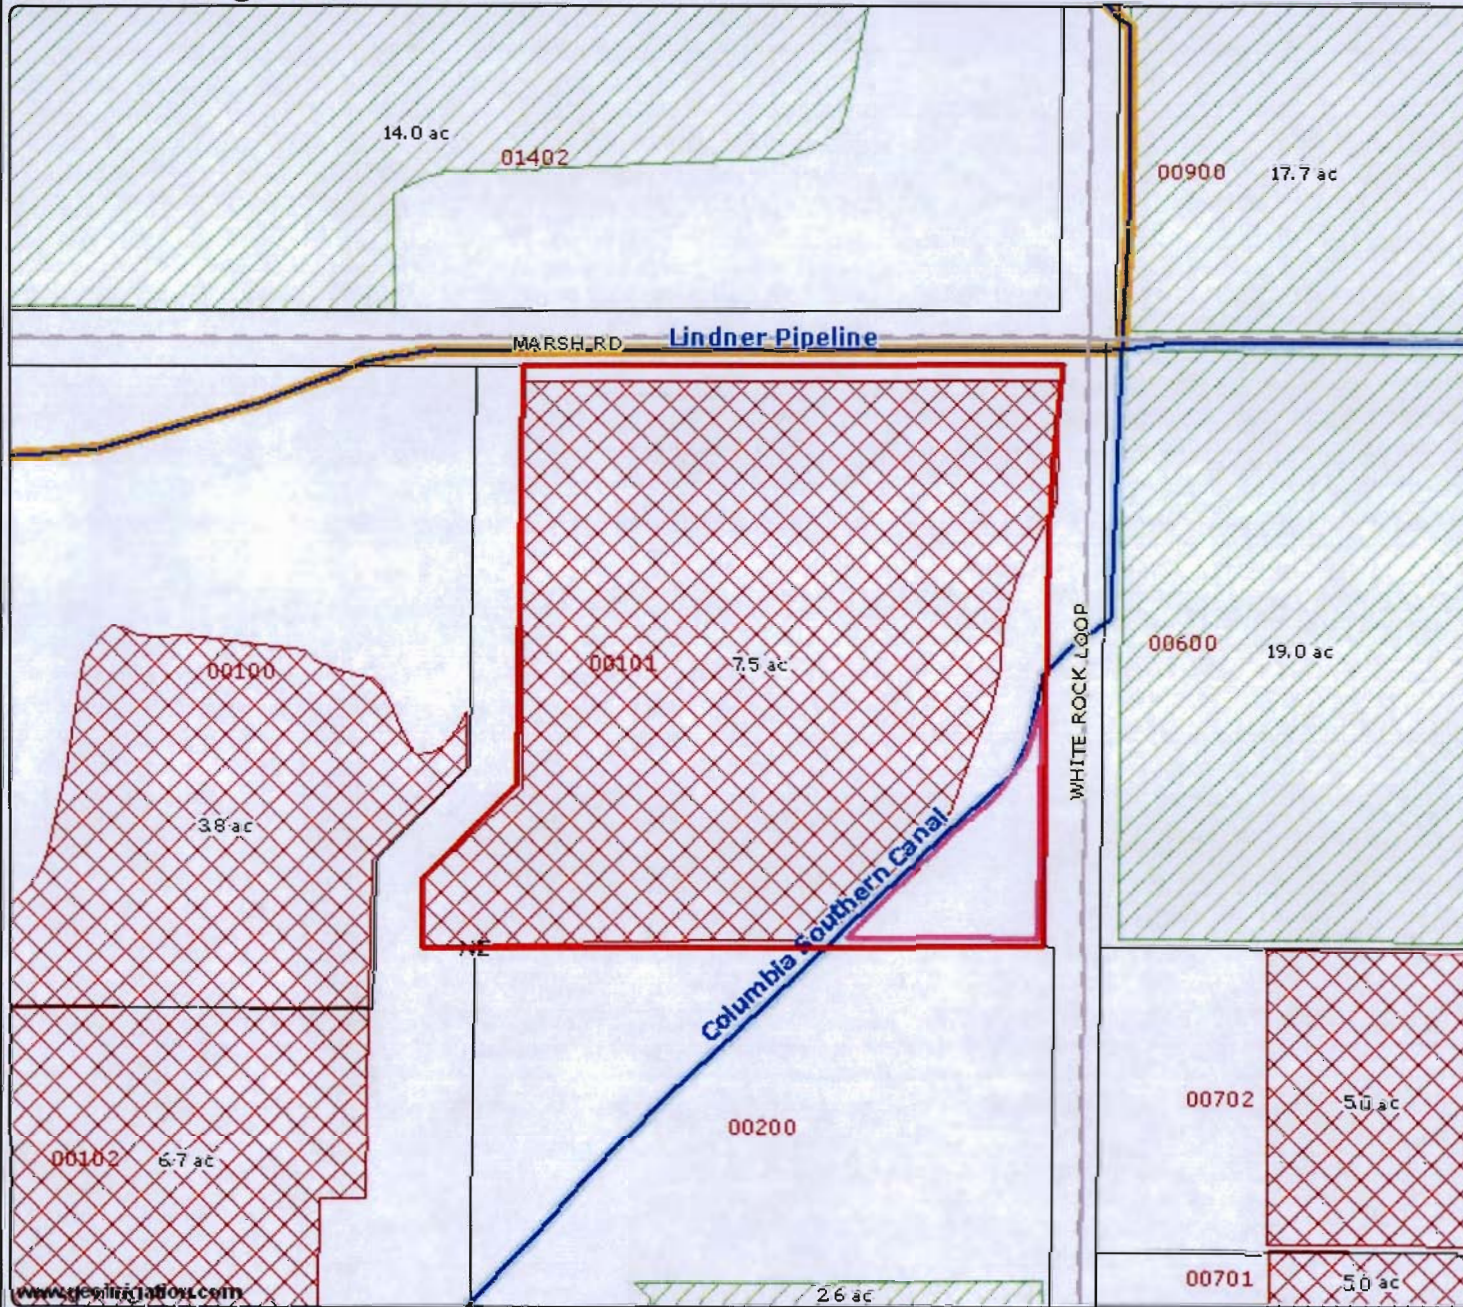

Mel & Marsha Stout on map .50 acres

16-12-17-NE/NE-00101

- Cities
- District Boundary
- Highways
- Major Roads
- Road Labels
- Township Range
- Sections
- Section Labels
- Quarters
- Quarter Labels
- Quarter Quarters
- Quarter Quarter Labels
- Lot Labels
- Taxlots
- Canal All
- Canal Closed
- Canal Open
- ▣ Reservoir
- Unmapped Rights Labels
- Unmapped Rights
- Mapped Rights Labels
- ▨ Primary 74146 7
- ▨ Primary 76 106
- ▨ NHD Stream/River Area

RECEIVED BY OWRD

DEC 19 2012




Scale 1" = 200'
Created: 11/27/2012
SALEM, OR

www.gemirrigation.com

DISCLAIMER: This map is intended for display purposes only and is not intended for any legal representations. There are no warranties, expressed or implied, that accompany this product.

Tumalo Irrigation District

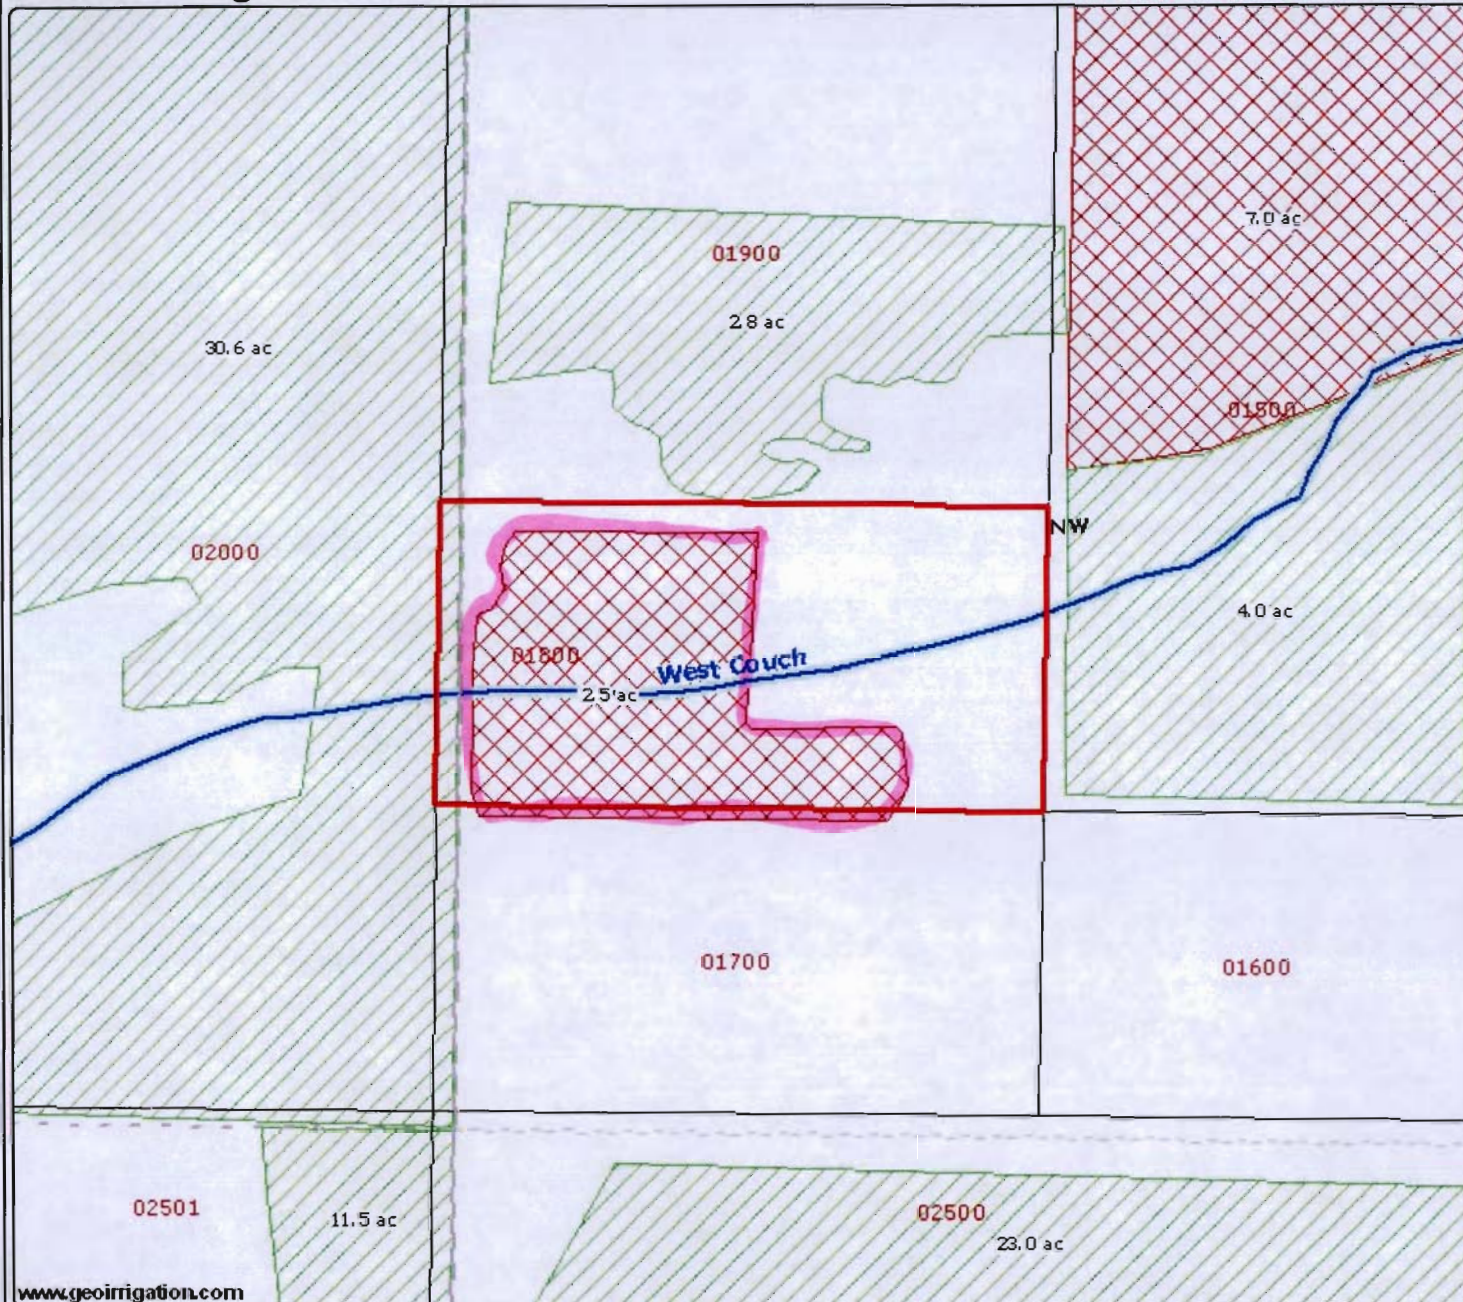

**Rocketts 2.5 acres off
16-11-22-NW/SE-01800**

- Cities
- District Boundary
- Highways
- Major Roads
- Road Labels
- Township Range
- Sections
- Section Labels
- Quarters
- Quarter Labels
- Quarter Quarters
- Quarter Quarter Labels
- Lot Labels
- Taxlots
- Canal All
- Canal Closed
- Canal Open
- Reservoir
- Unmapped Rights Labels
- Unmapped Rights
- Mapped Rights Labels
- Primary 74146 7
- Primary 76106
- NHD Stream/River Area

RECEIVED BY OWRD

DEC 19 2012




SALEM, OR

Scale 1" = 200'
Created: 1/30/2012

INITIAL

Tumalo Irrigation District

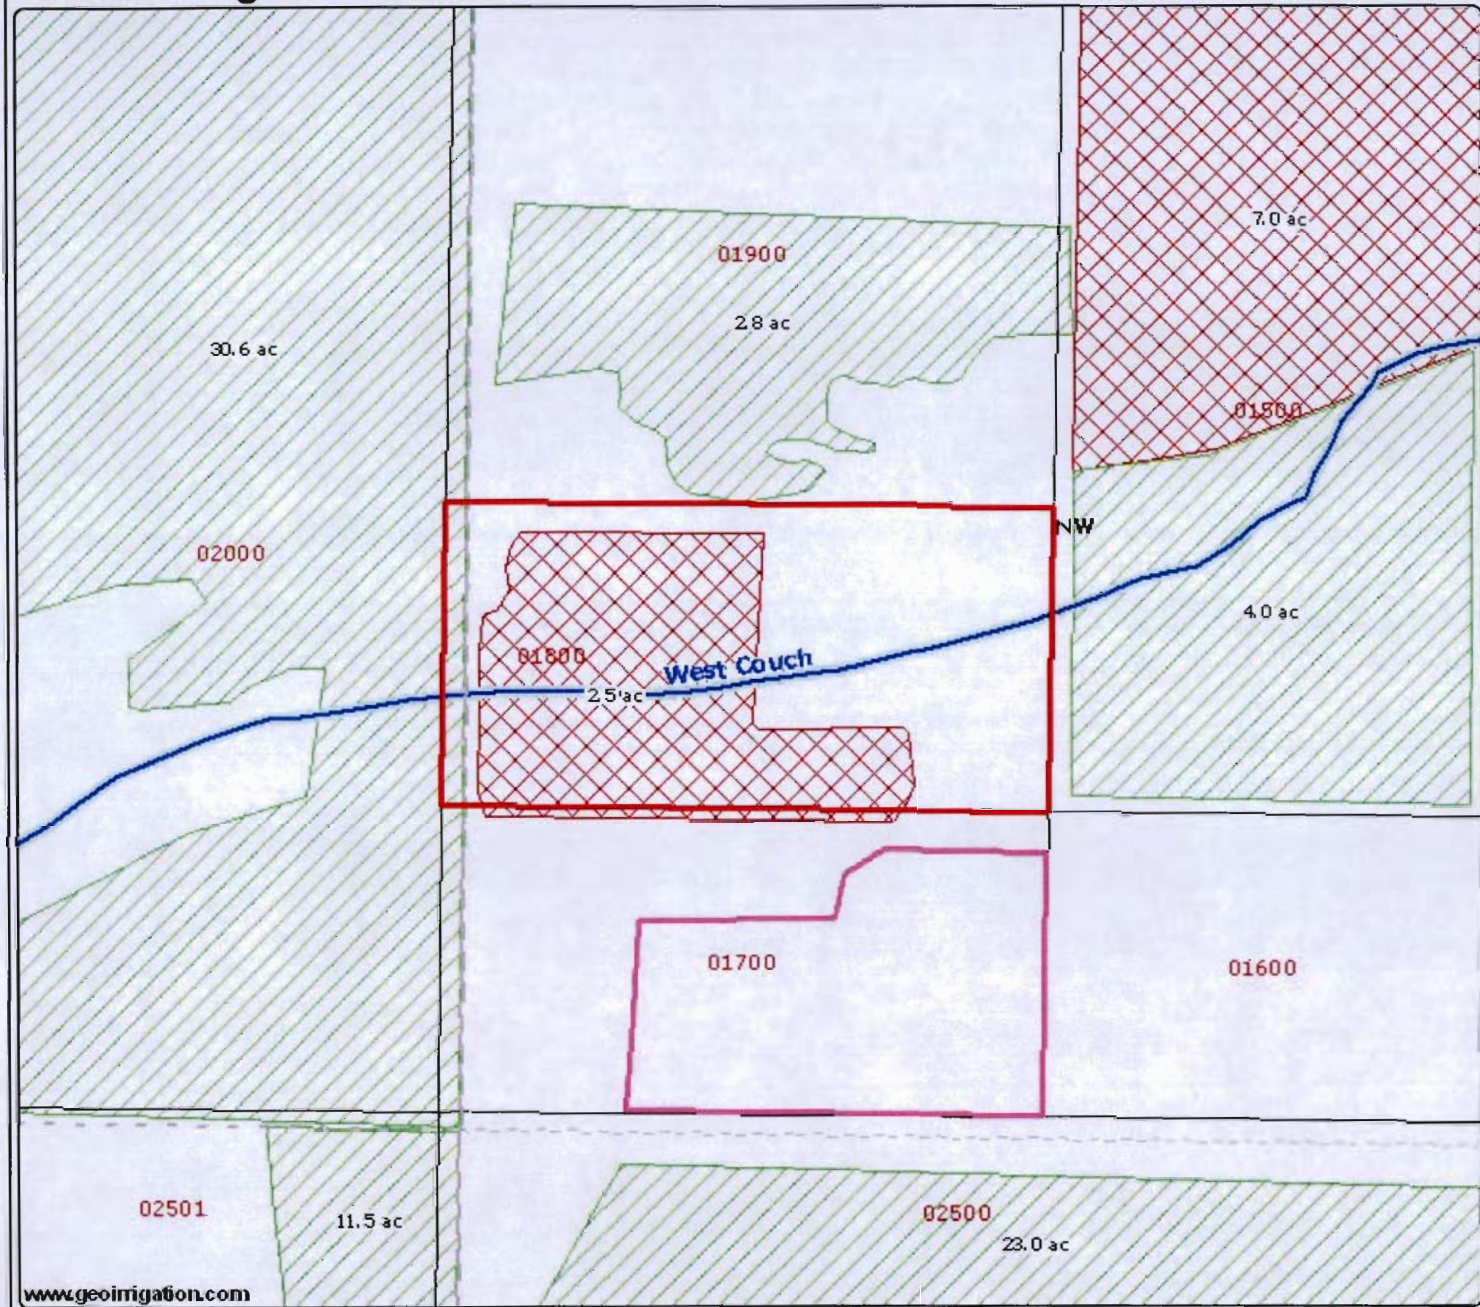

Kruskamp & LaBelle 2.5 acres water on

16-11-22-NW/SE-01700

- Cities
- ▭ District Boundary
- Highways
- Major Roads
- Road Labels
- ▭ Township Range
- ▭ Sections
- ▭ Section Labels
- ▭ Quarters
- ▭ Quarter Labels
- ▭ Quarter Quarters
- ▭ Quarter Quarter Labels
- ▭ Lot Labels
- ▭ Taxlots
- Canal All
- ▭ Canal Closed
- ▭ Canal Open
- ▭ Reservoir
- ▭ Unmapped Rights Labels
- Unmapped Rights
- ▭ Mapped Rights Labels
- ▭ Primary 74146 7
- ▭ Primary 76 106

RECEIVED BY OWRD

DEC 19 2012




SALEM, OR
Scale 1" = 200'
Created: 1/30/2012



www.geoirrigation.com

DISCLAIMER: This map is intended for display purposes only and is not intended for any legal representations. There are no warranties, expressed or implied, that accompany this product.


2012 Tumalo Irrigation District Transfer Map

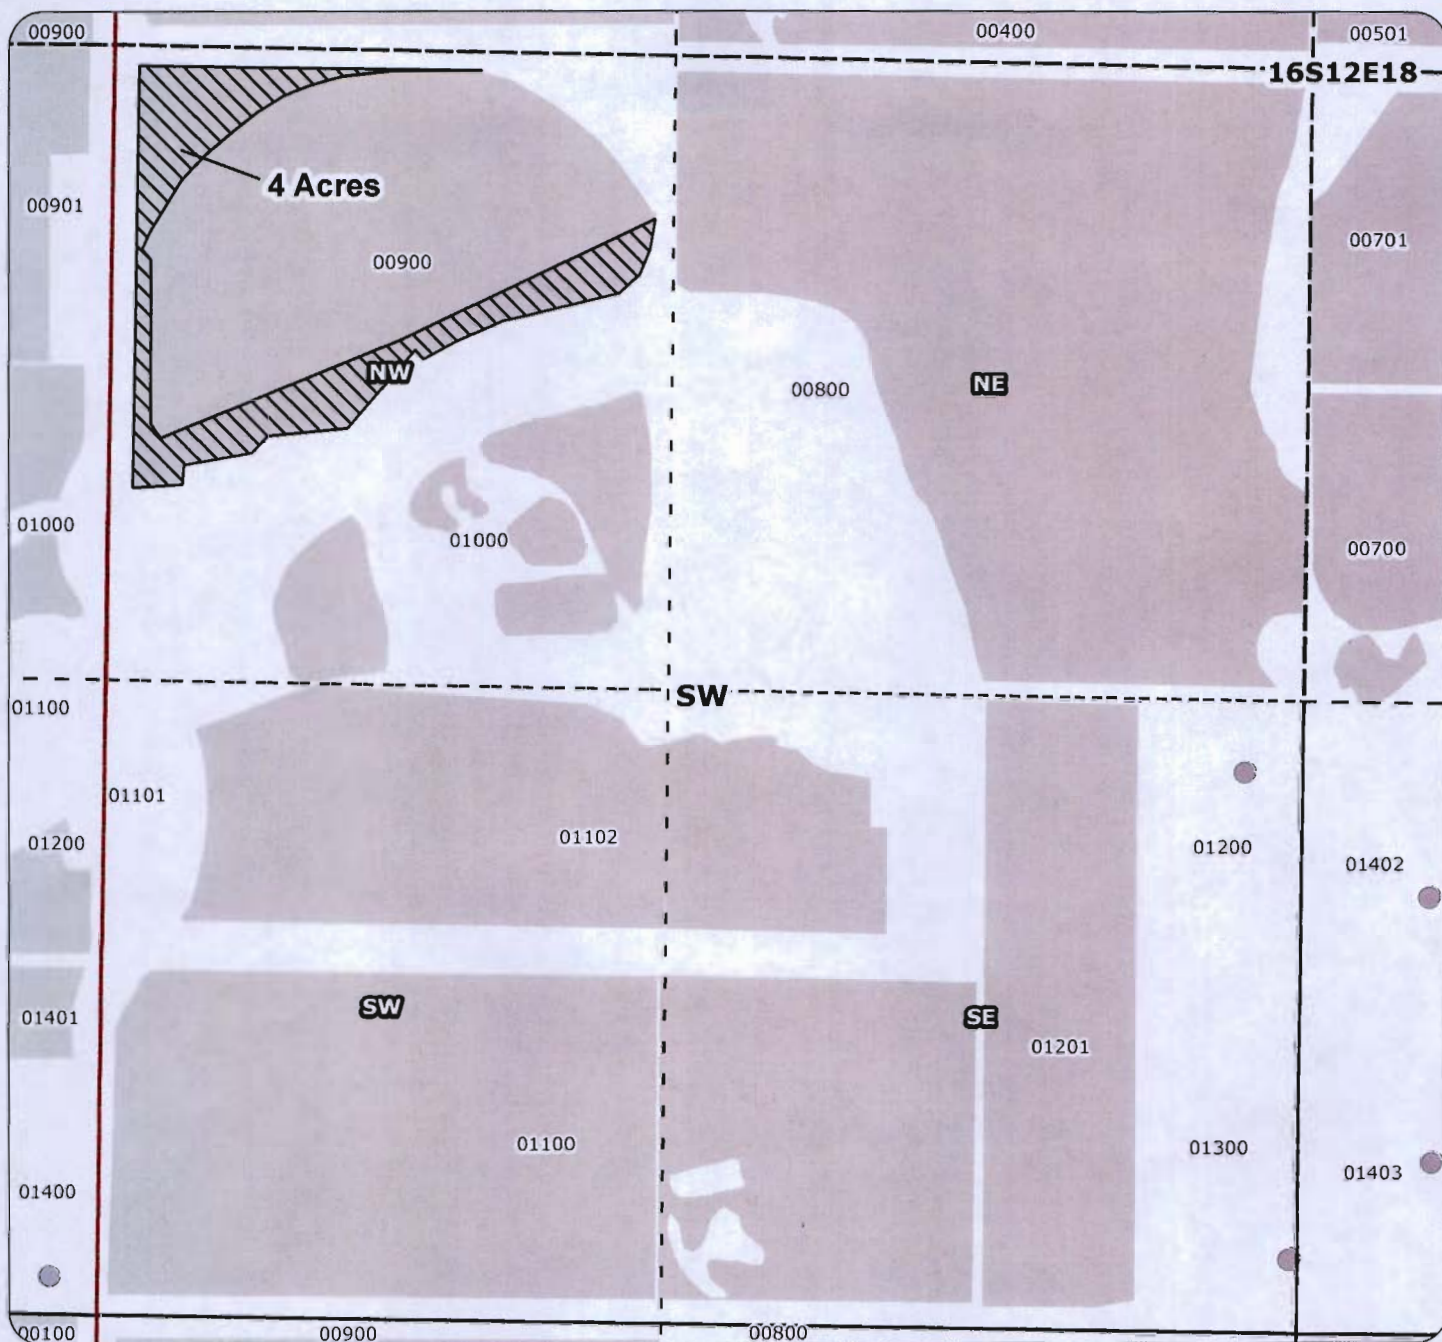

Application for Permanent District Transfer Primary: Certificate 74146

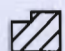-  Transfer ON
-  Transfer OFF
-  Unmapped Water Rights
-  Cert 76106
-  Cert 74146 & 74147


Vlach Trust
Taxlot 900 - 4.0 Acres OFF Certificate 74146
Total Proposed Water Right
on Taxlot 900 - 11.0 Acres (Cert 74146)
in 161218NWSW

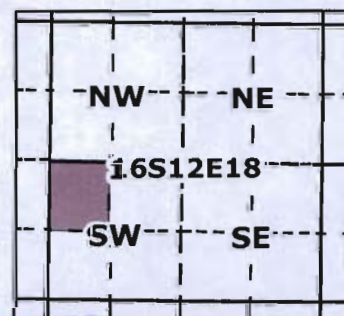

RECEIVED BY OWRD

DEC 19 2012

SALEM, OR

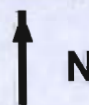


1 inch = 400 feet








Geo-Spatial Solutions, Inc.
www.geospatialolutions.com

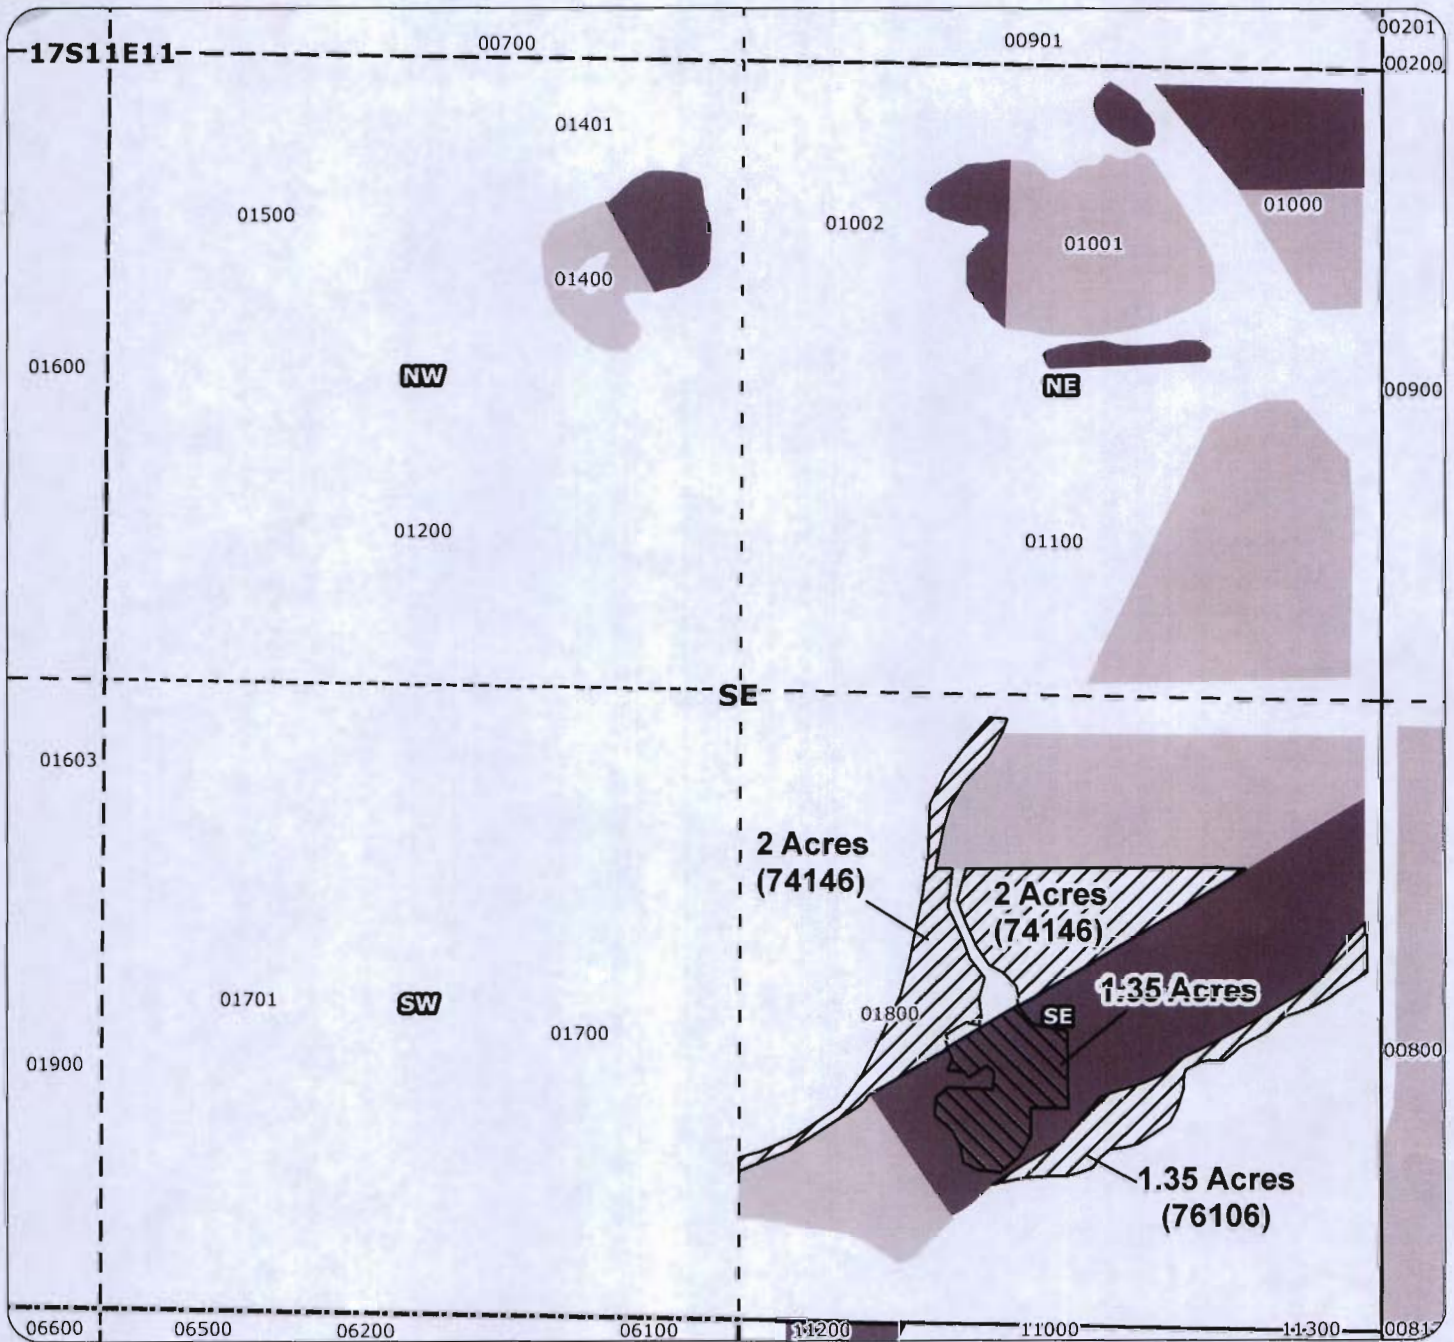Date Created: April 2012


2012 Tumalo Irrigation District Transfer Map

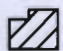

Application for Permanent District Transfer Primary: Certificates 74146, 76106


-  Transfer ON
-  Transfer OFF
-  Unmapped Water Rights
-  Cert 76106
-  Cert 74146 & 74147

Bud Horsman
 Taxlot 1800 - 4.0 Acres ON Certificate 74146
 Taxlot 1800 - 1.35 Acres ON Certificate 76106
 Taxlot 1800 - 1.35 Acres OFF Certificate 76106
 Total Proposed Water Right
 on Taxlot 1800 - 11.0 Acres (Certs 74146, 74147)
 Total Proposed Water Right
 on Taxlot 1800 - 7.2 Acres (Cert 76106)
 in 171111SESE

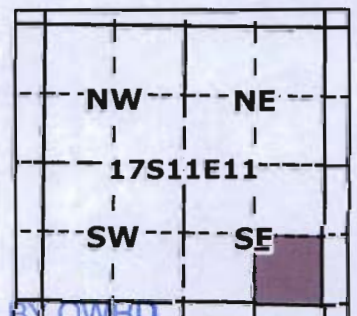

RECEIVED BY OWNER

DEC 19 2012

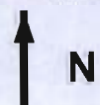

SALEM, OR


1 inch = 400 feet

Whiterock Loop

WHITE ROCK

1601

1600

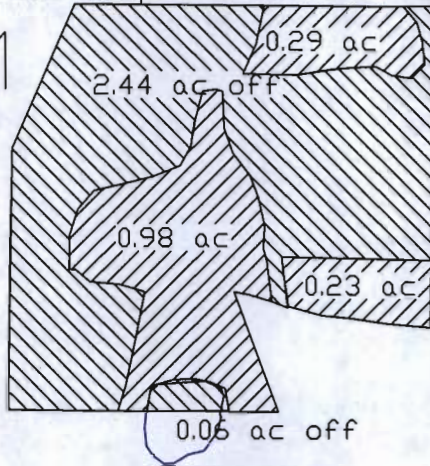

16-12-08-NE/SW-01601
 Total off 2.5 ac of CT# 74146 DATE 09-01-1900
 Total Remaining 1.5 ac of CT# 74146 DATE 09-01-1900

1501

06

1500

TWIN BRIDGES RD

05

1500

1501

RECEIVED BY OWRD

DEC 19 2012

SALEM, OR



Snyder, Hillary & Robert

Tumalo Irrigation District

64697 COOK AVE, BEND, OREGON 97701

PH-541-382-3053 www.tumalo.org

DRAWN BY Snyder

DATE 7/26/2012

DWG NAME Layout4Master


REV 0

CHECKED BY FDR


SCALE 1/200xp


SHEET 1

**TUMALO IRRIGATION DISTRICT
WATER RIGHT ON MAP
FOR
BRIAN J. AND HEATHER TURNER
65215 SMOKEY BUTTE RD. BEND, OR 97701
LOCATED IN THE SE 1/4 OF THE SW 1/4
OF SECTION 24, T. 16 S., R. 11 E., W.M.
TAX LOT 16-11-24 #3001
DESCHUTES COUNTY, OREGON**

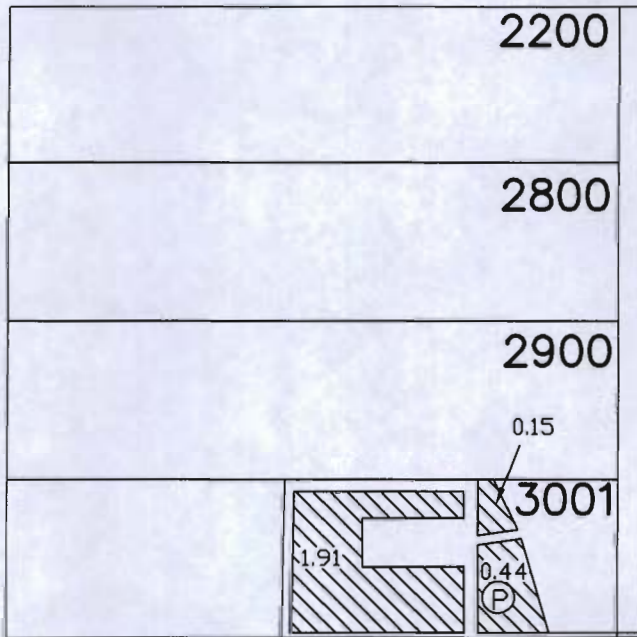

RECEIVED BY OWRD
DEC 19 2012
SALEM, OR

 = 2.50 AC. WATER TO BE TRANSFERRED ON,
CERT. NC 74146; DATED 9/1/1900

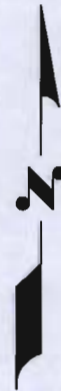

I, ROBERT E. BAXTER, CERTIFIED WATER RIGHT EXAMINER
IN THE STATE OF OREGON, HEREBY CERTIFY THAT THIS
WATER RIGHT SURVEY MAP WAS PREPARED BY ME.

SCALE: 1" = 400'
DATE: 6-22-11

THE PREPARATION OF THIS MAP IS FOR THE PURPOSE
OF IDENTIFYING THE LOCATION OF THE WATER RIGHT
ONLY AND HAS NO INTENT TO PROVIDE DIMENSIONS OR
LOCATIONS OF PROPERTY OWNERSHIP LINES.

