




RECEIVED BY OWRD

Legend

 Township, Range, Section

Authorized POD


JAN 07 2013

*Twp Rng Sec 1/4 1/4
1N 32E 27 SW SE*

SALEM, OR

*50ft North and 475ft East
from South quarter corner
of section 27*


RICHARD BANISTER
43794 HOEFT RD.
PENDLETON, OR 97801

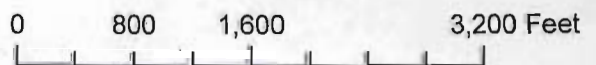

1 inch equals 1,320 feet



T. 1N., R. 32E., SEC. 22 & 27, W.M.

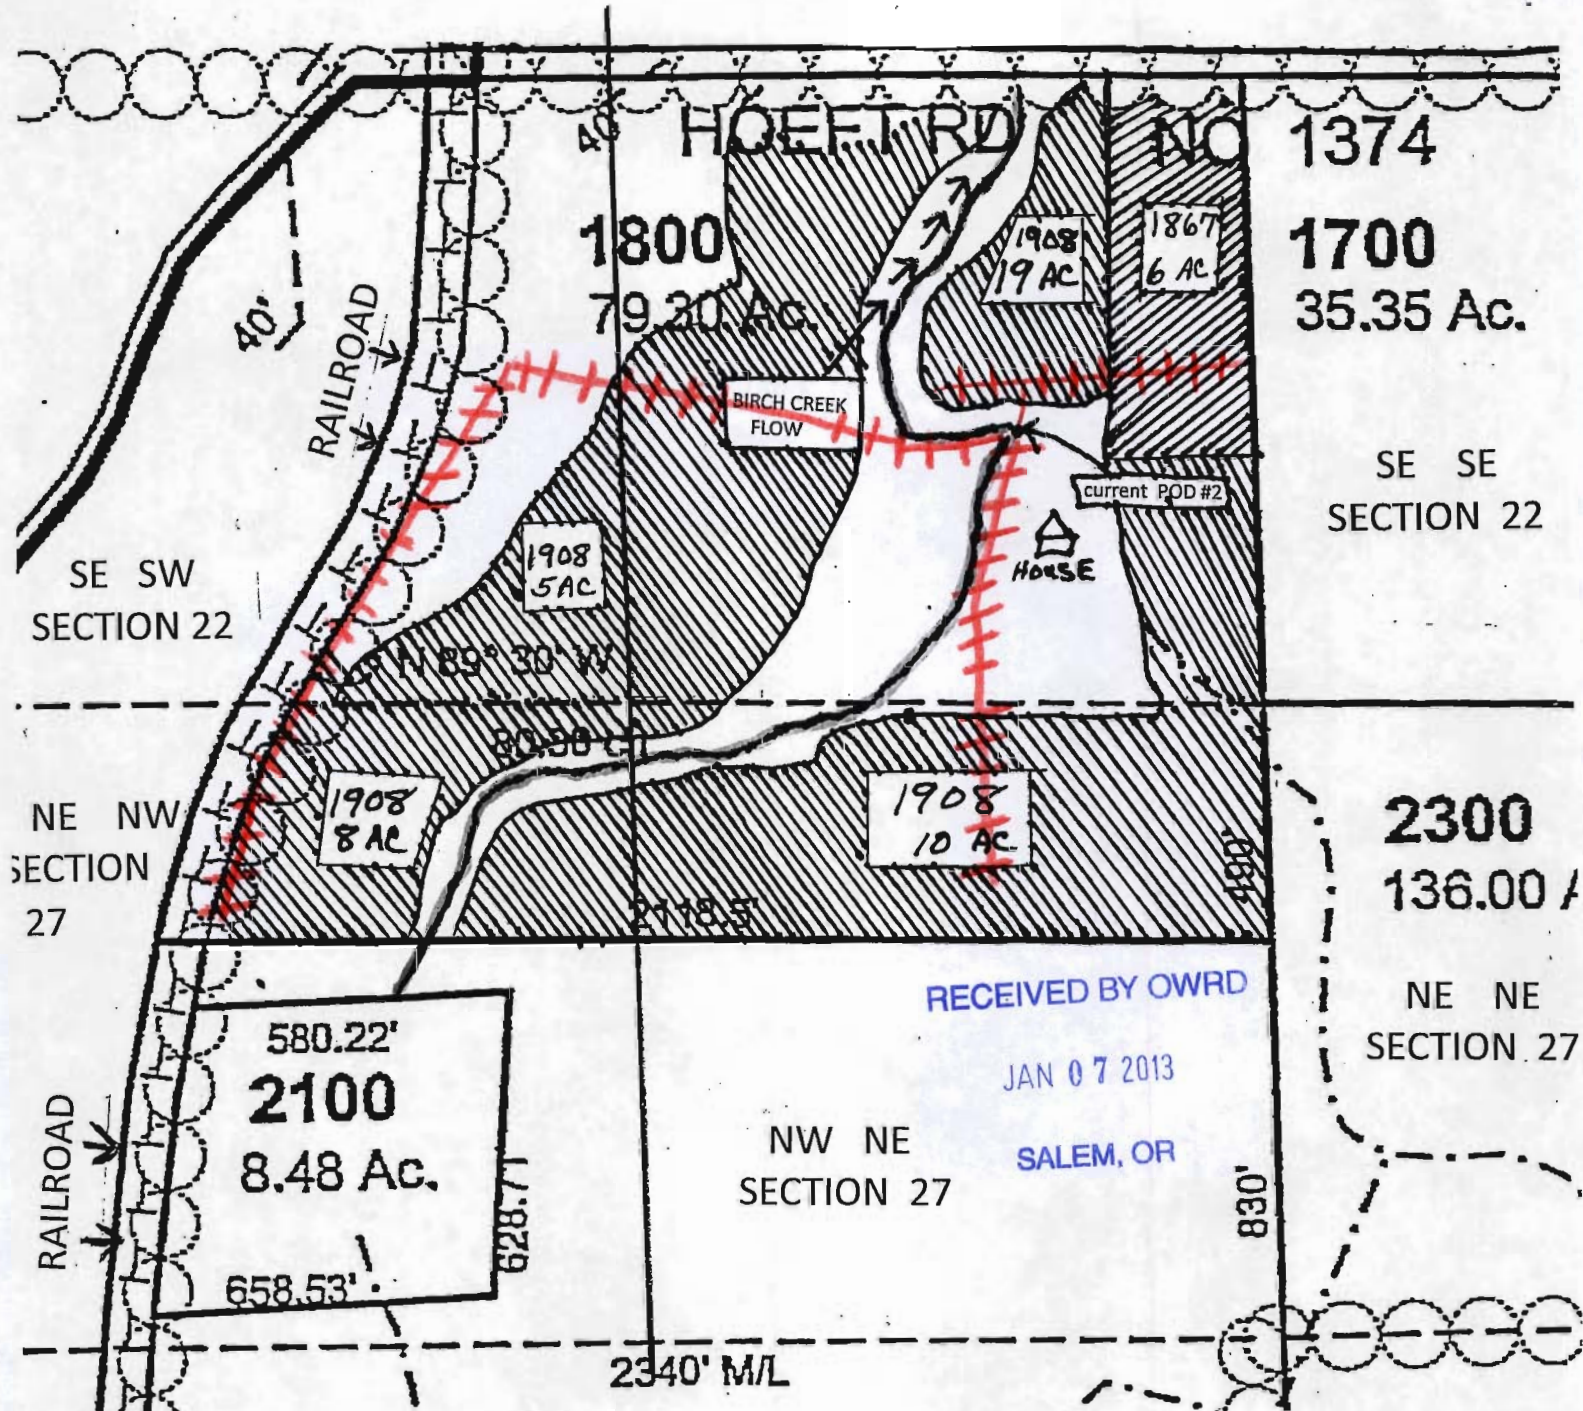

Richard Banister
43794 Hoeft Rd.
Pendleton, Or 97801

Tax Lot 1800

Scale 1" = 400'

Authorized POD: 50' North and 475' East
from the South ¼ Corner
of Section 27, being within the
SW ¼ SE ¼, Section 27.
(POD # 1)

Current POD: N 45.54576, -118.79408

(POD # 2)
670' North and 768' East
from the South ¼ Corner of
Section 22, being within the
SW ¼ SE ¼, Section 22.



Delivery system HHHH