

Melville Water Right Transfer

Date: 4/11/2013


RECEIVED BY OWRD

APP 18 2013

SALEM, OR

Legend

- Taxlot
- Unchanged 62259 Priority 4/22/1976
- Unchanged 62262 Priority 6/9/1976
- Acres Removed from 62259 Priority 4/22/1976
- Acres Removed from 62262 Priority 6/9/1976
- Water Rights from 62259 Priority 4/22/1976
- Water Rights From 62262 Priority 6/9/1976
- Delivery System
- Proposed Delivery
- Prairie Creek
- Point of Diversion
- Township Range
- Quarter Quarter Sections

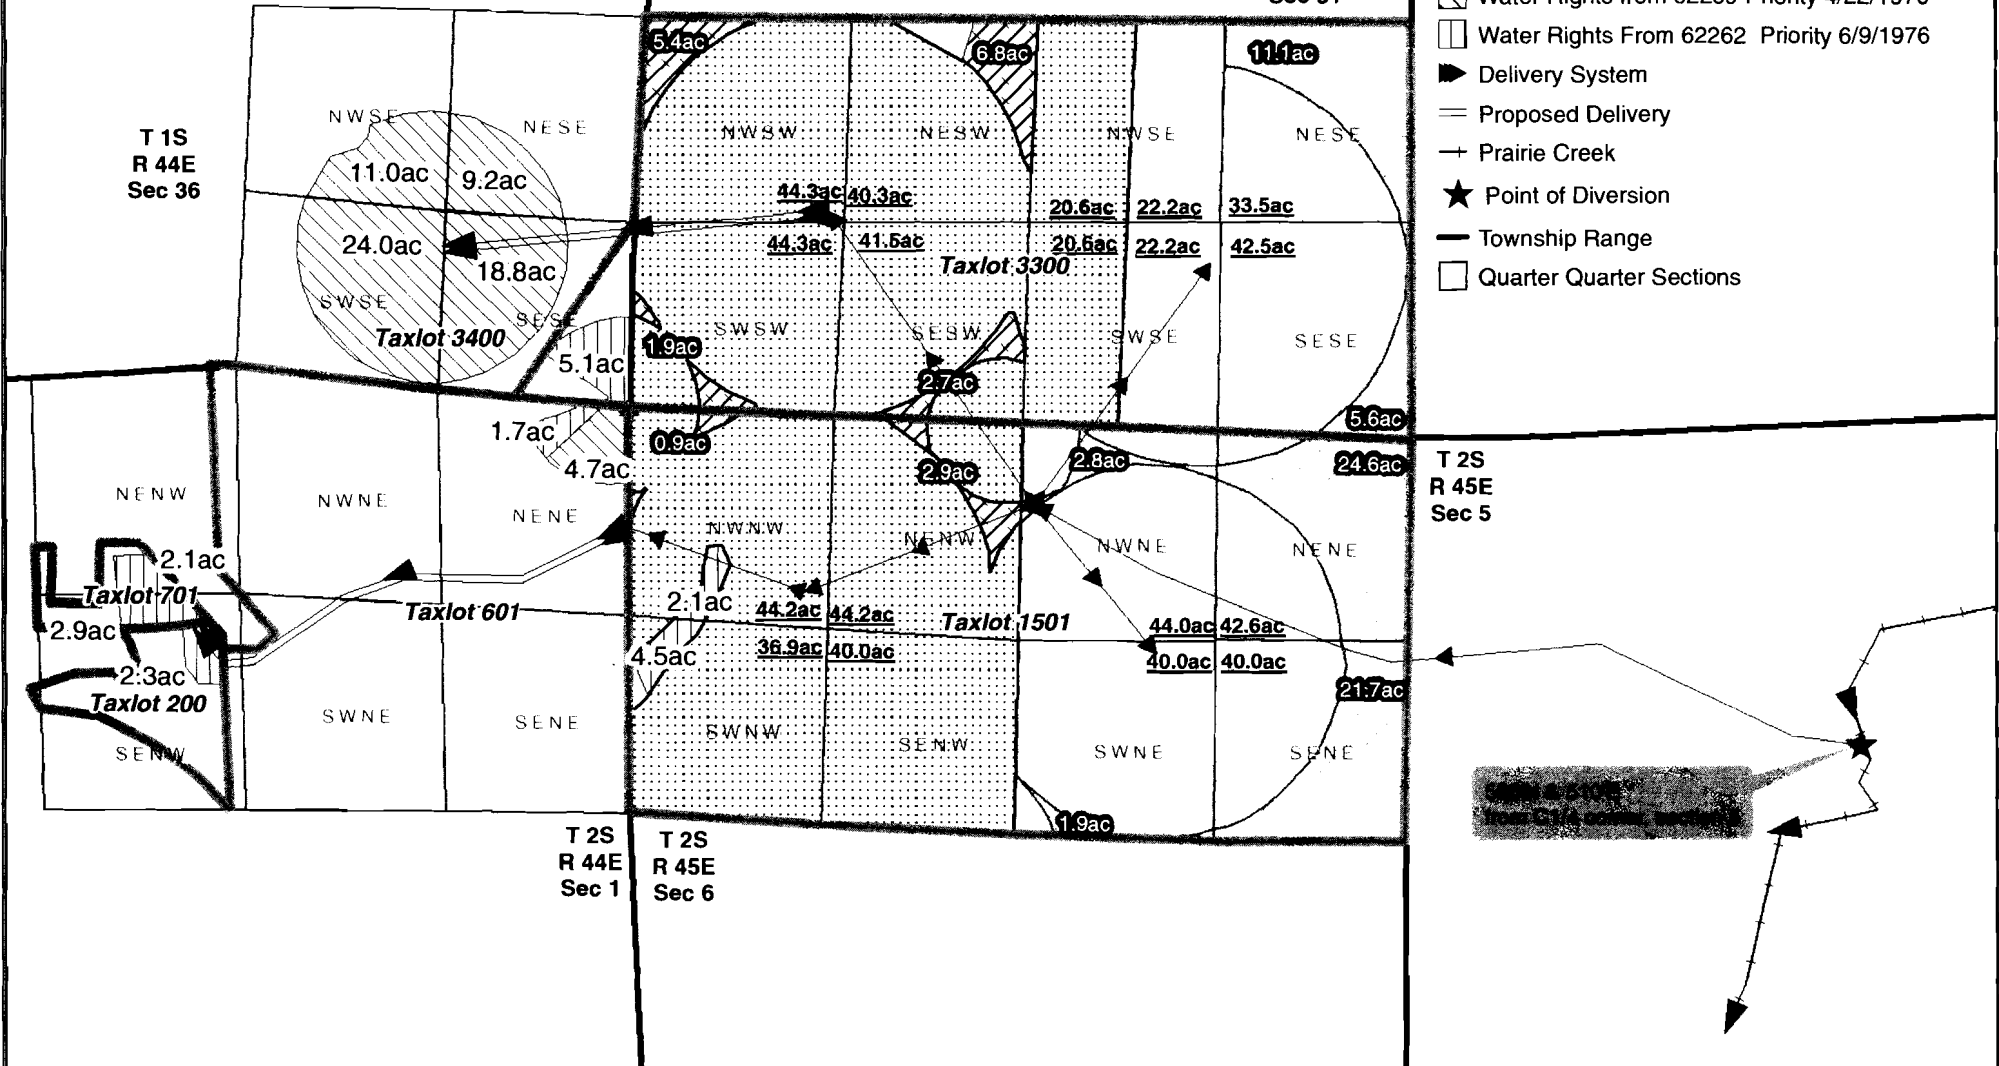

1"=1,320'

T011579

