
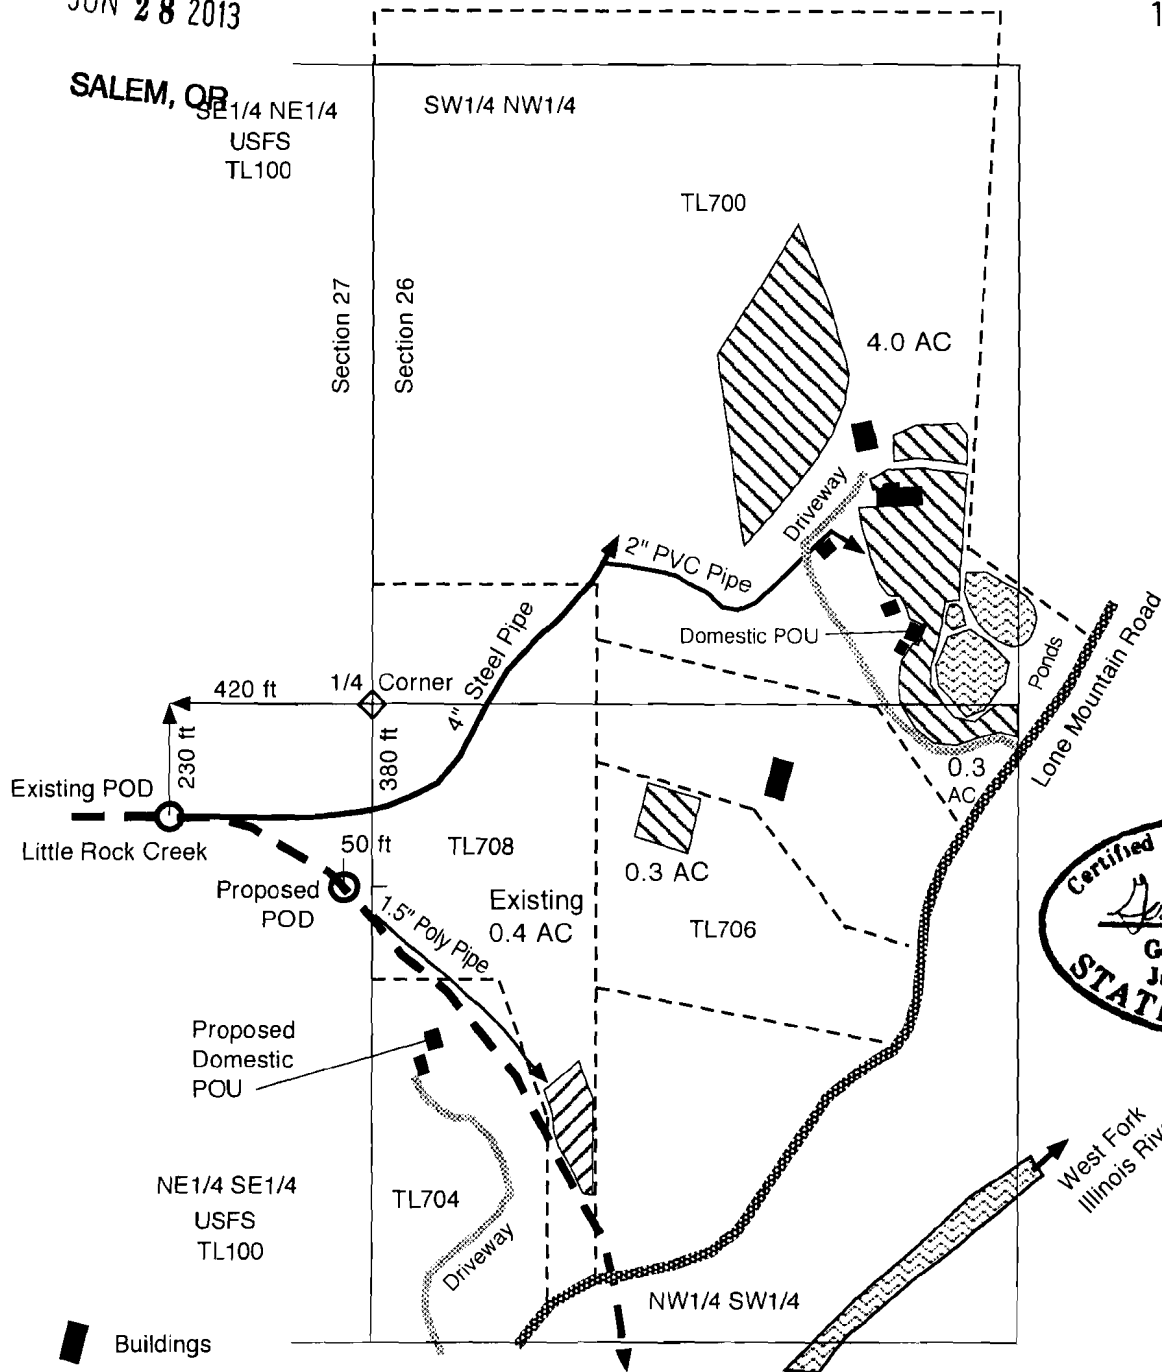


Water Right Transfer Map from Certificate # 20977  
 T40S, R9W, WM, JOSEPHINE COUNTY  
 Portions of Section 26  
 June 17, 2013

RECEIVED BY OWRD

JUN 28 2013

SALEM, OR

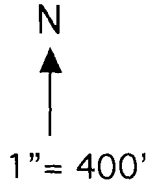

6-17-2013  
 exp 12-31-2014

Note: A Final Proof survey was never done for permit S-17966, and the application S-22836 and WRIS maps do not properly depict the certificate 20977 POU. Therefore the water rights were described based on the present POU. The authorized POD was incorrectly located and is re-described on this transfer map based on GPS measurements.

- Existing 0.4 acres of irrigation proposed for changes in POD, POU, and USE under certificate 20977 with a priority of September 23, 1947 from application S-22836 and permit S-17966 at a rate of 0.02 cfs per acre.
- Remaining rights of 4.6 acres irrigation and domestic use for one family under certificate 20977.

This map was drawn by Gordon R. Lyford for Robert and Wanda Powell to support their application for a water right transfer to change the point of diversion, place of use, and character of use from Little Rock Creek. They own tax lots 704 and 708.

This map was prepared for the purpose of identifying the location of water rights only and is not intended to provide legal dimensions or the location of property ownership lines.

1011628