


1" = 400'

SEE MAP 37 5 18-4

T-5579

NEW HOPE ROAD

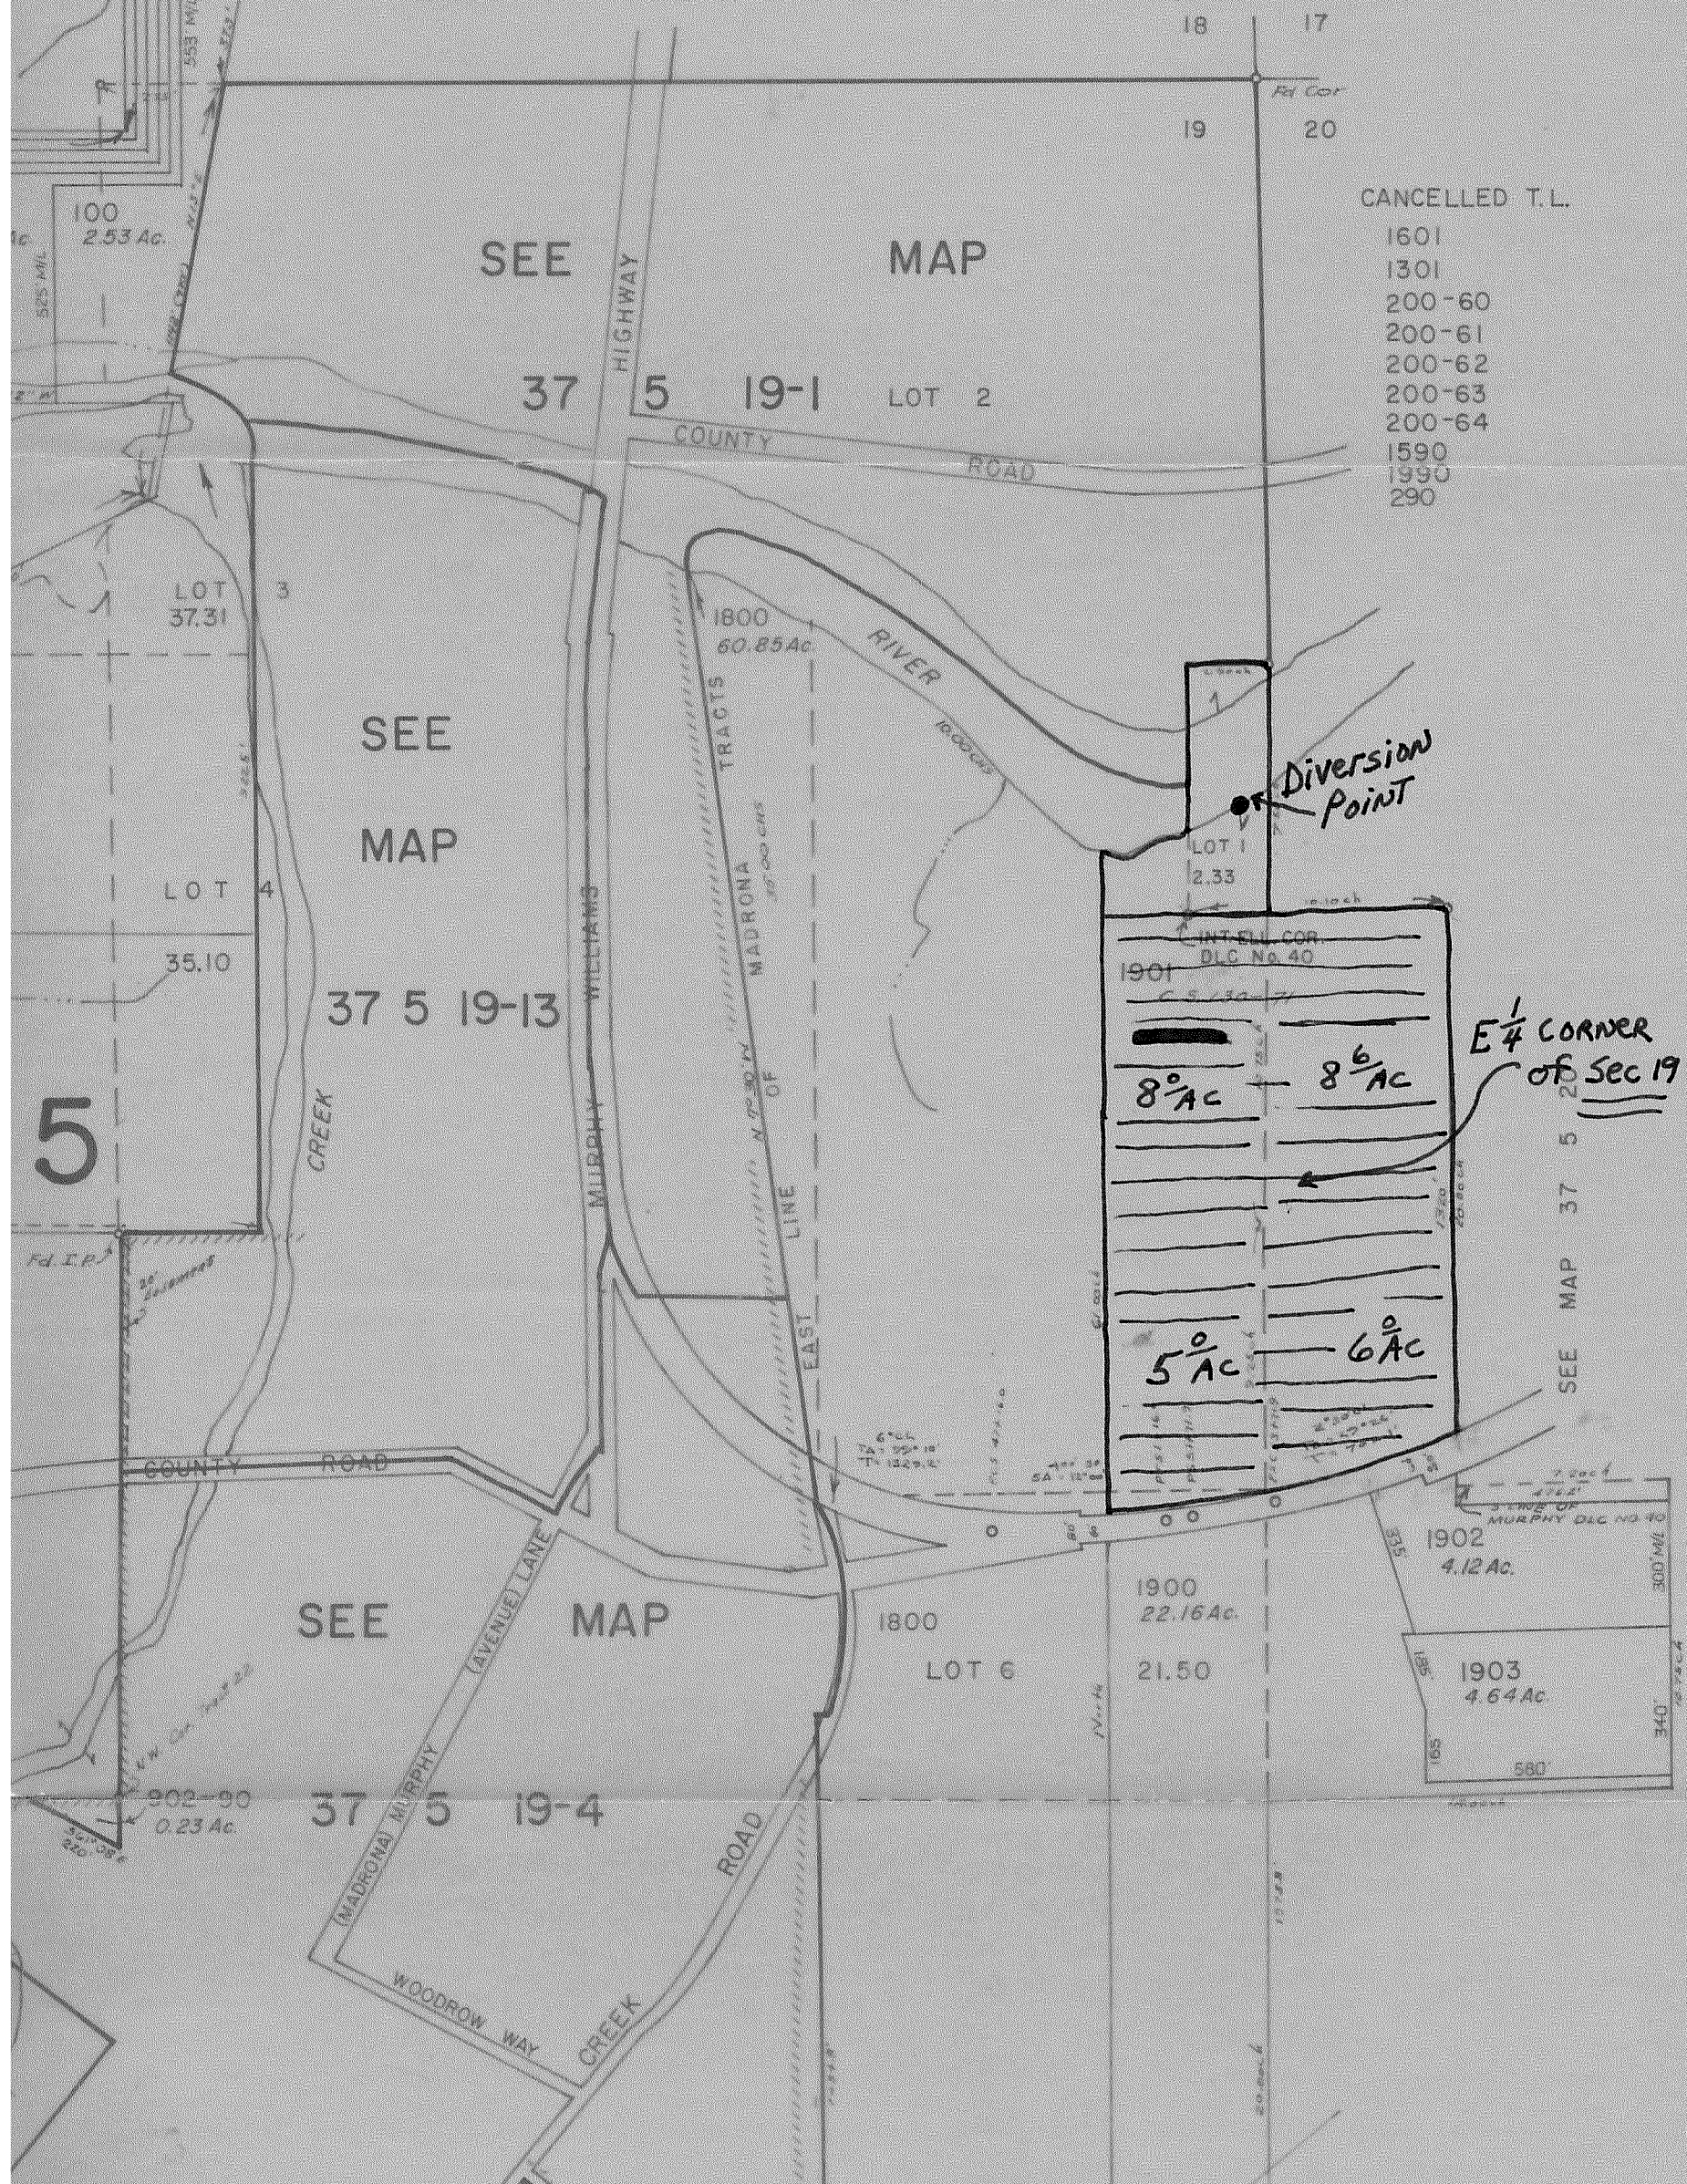

SEE MAP

37 5 19-1 LOT 2

CANCELLED T.L.

- 1601
- 1301
- 200-60
- 200-61
- 200-62
- 200-63
- 200-64
- 1590
- 1990
- 290

SEE MAP

37 5 19-13

5

INT. ELY. COR.  
DLC NO. 40  
1901  
C.S. 150-77

---

8<sup>0</sup>/<sub>10</sub> AC — 8<sup>6</sup>/<sub>10</sub> AC

---

5<sup>0</sup>/<sub>10</sub> AC — 6<sup>0</sup>/<sub>10</sub> AC

E 1/4 CORNER OF SEC 19

SEE MAP 37 5 20-4

SEE MAP

37 5 19-4

1902  
4.12 Ac.

---

1903  
4.64 Ac.

1800 LOT 6 21.50

WOODROW WAY