


41590

ATTACHMENT
E

67133

T.37S.,R.88&9E., W.M.

MAP - TO LANDS
1-4 2

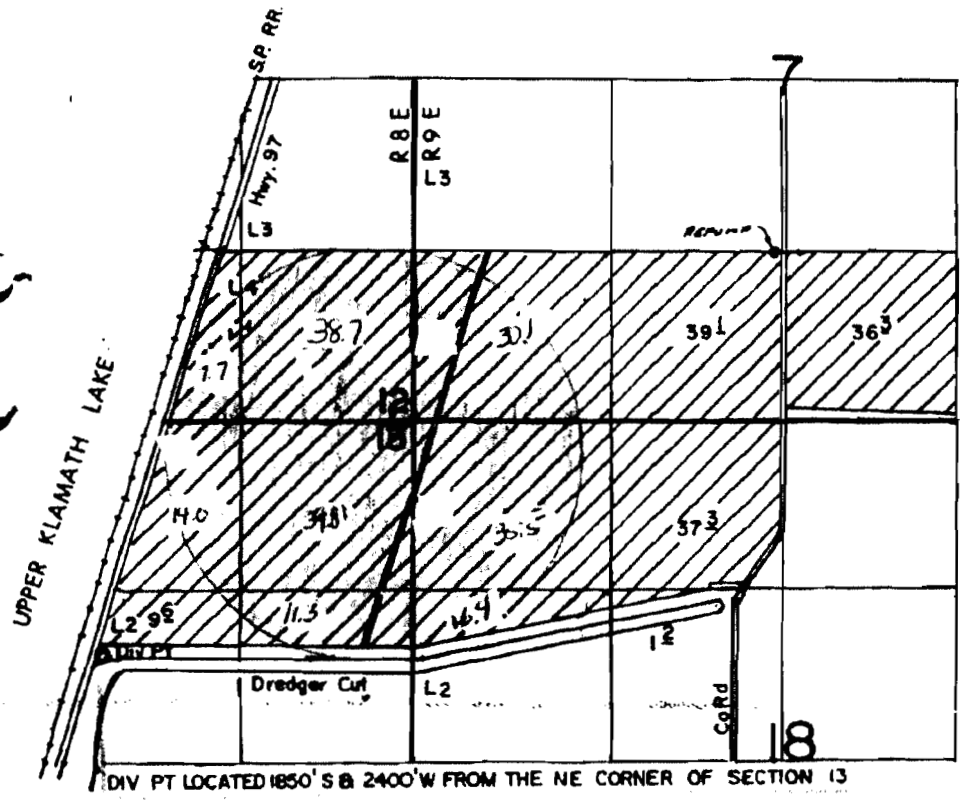

TO LANDS

POD 1850' SOUTH +
2400' WEST OF
NE CORNER,
SECTION 13

SCALE: 1"=1320'

FINAL PROOF SURVEY UNDER

Application No. 55924... Permit No. 41590.....
IN NAME OF
FORNEY W. & JENNIFER D. SCRONCE

Surveyed APRIL 10, 1990., by B.W. BISHOP.....
Oct. 16 1990

RECEIVED

SEP 09 2013

WATER RESOURCES DEPT
SALEM, OREGON



41035-178-179D

REVISED 1-29-91/BLB
6-14-90 DLM

T011663

T.37S.,R.88&9E., W.M.

MAP - TO LANDS 1 of 2

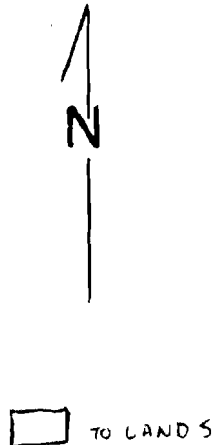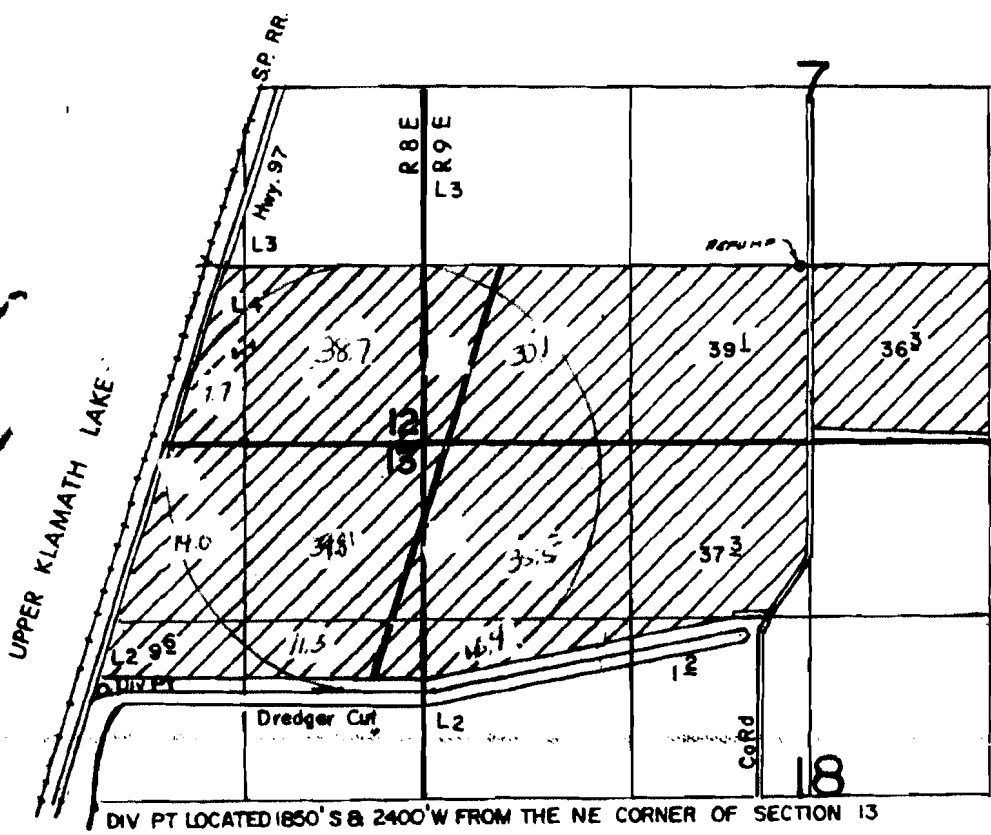

Upper Kl. Lake & Marsh

SCALE: 1"=1320'

RECEIVED

SEP 09 2013

WATER RESOURCES DEPT SALEM, OREGON

FINAL PROOF SURVEY UNDER

Application No. 55994... Permit No. 41590..... IN NAME OF

FORNEY W. & JENNIFER D. SCRONCE

Surveyed APRIL 10, 1990., by B.W. BISHOP..... Oct. 16 1990

Attachment 'E'
MAP - TO LANDS 2092


35928
44733

T378 ROAPE, W.M.

Source:

Upper Klamath Lake

TO LANDS

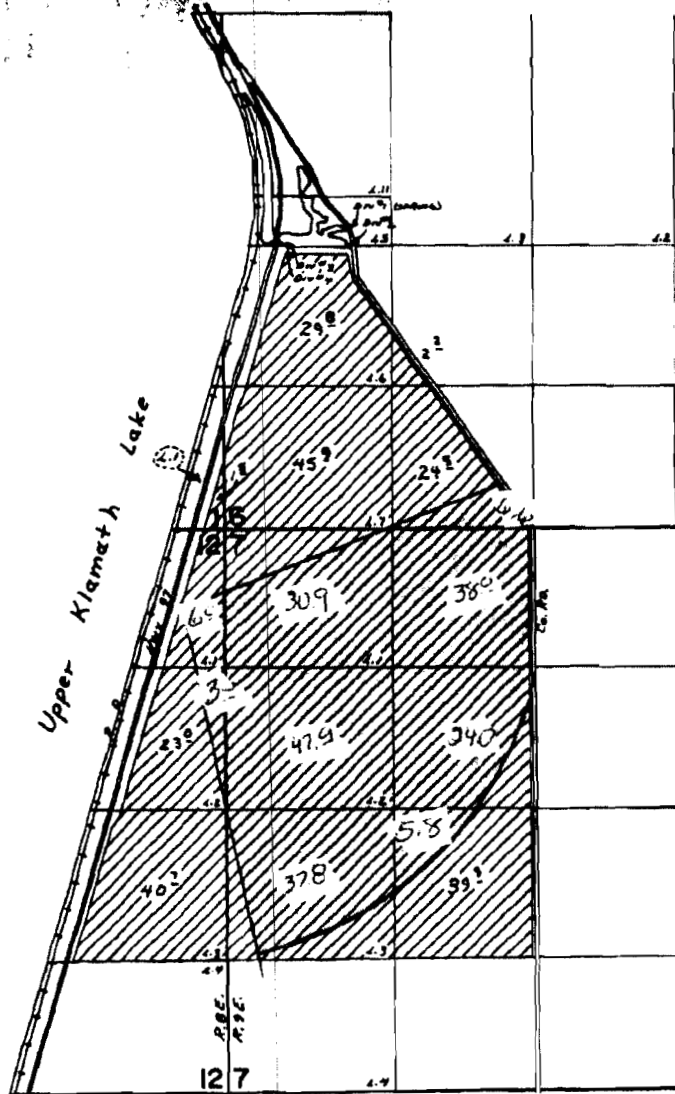

Div #1 - 2800' N AND 1130' E
 Div #2 - 2640' N AND 1140' E
 Div #3 - 2640' N AND 640' E
 Div #4 - 2640' N AND 600' E

} FROM SW COR SEC 6

FINAL PROOF SURVEY
UNDER

Application No. 48878 Permit No. 35928 Cert # 44733
IN NAME OF



FREDERIC B. ROBERTA SCHILDMAYER

Surveyed July 11, 1975, by L. E. Gould.

ATTACHMENT
 B
 MAPS FROM
 LANDS
 2 of 2

KLAMATH BASIN ADJUDICATION
 KLAMATH PROJECT LANDS MAP

TOWNSHIP 37 SOUTH, RANGE 9 EAST, W.M.

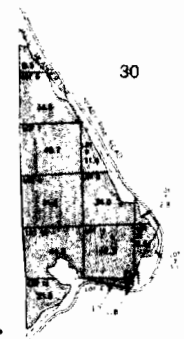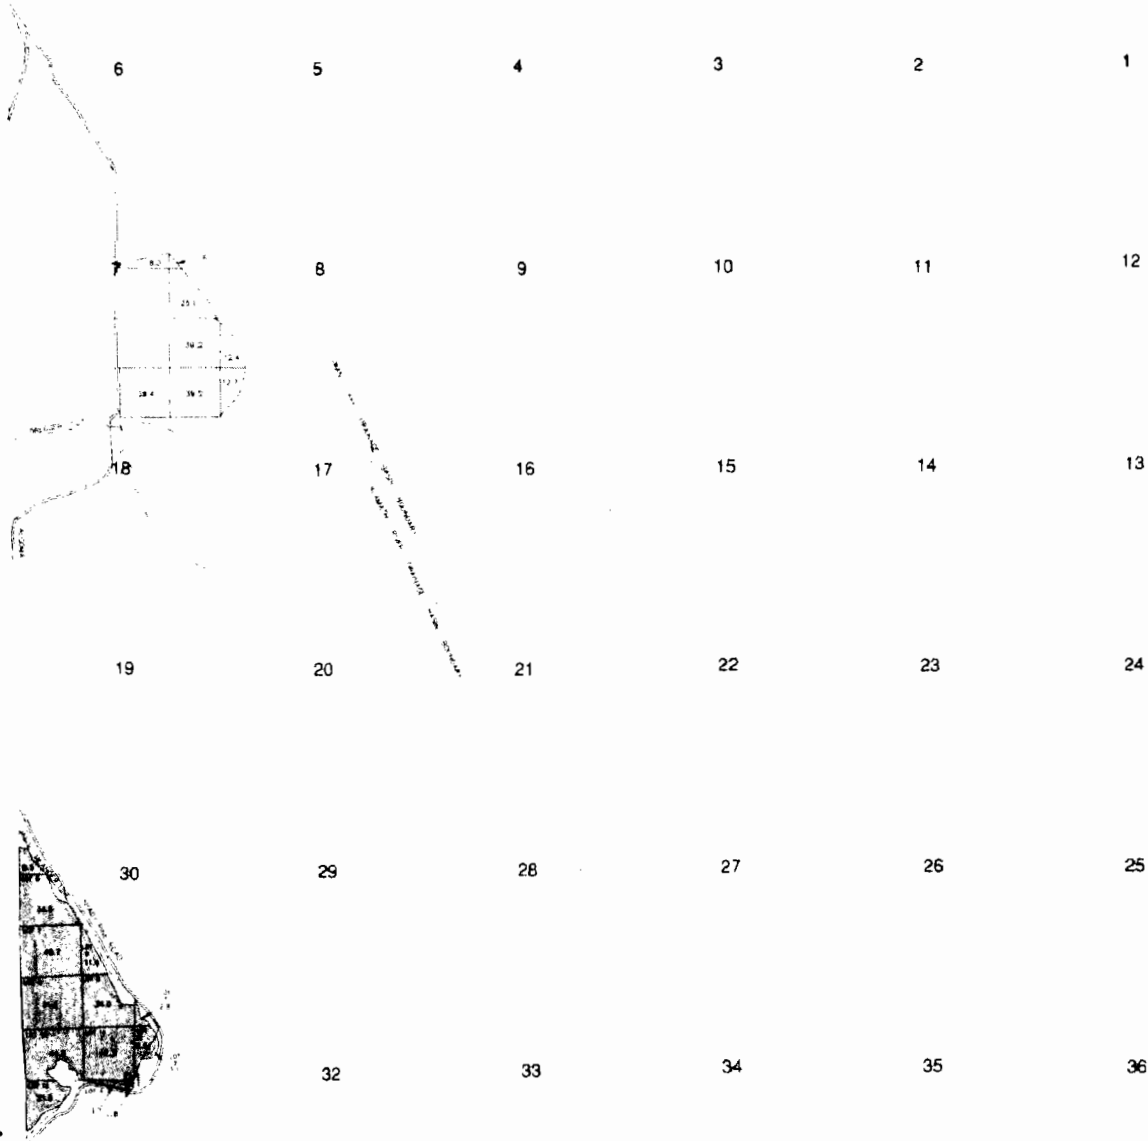

ADKINS








ATTACHMENT
B
MAPS FROM
LANDS
1 of 2

KLAMATH BASIN ADJUDICATION
KLAMATH PROJECT LANDS MAP

TOWNSHIP 37 SOUTH, RANGE 8 EAST, W.M.

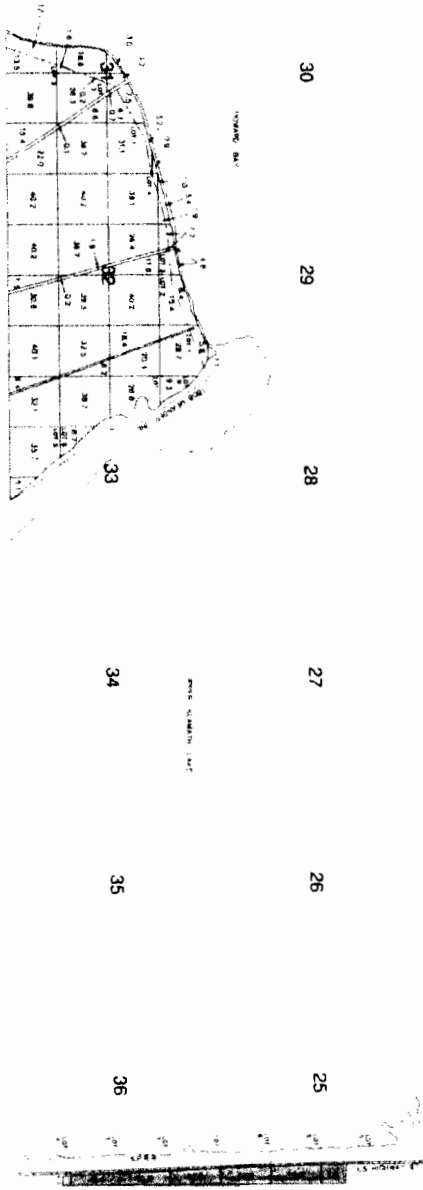






RECEIVED

SEP 09 2013

WATER RESOURCES DEPT
SALEM, OREGON

ADKINS
