


ATTACHMENT A
ORIGINAL POU & POD MAPS

RECEIVED BY OWRD


SEP 26 2013

SALEM, OR

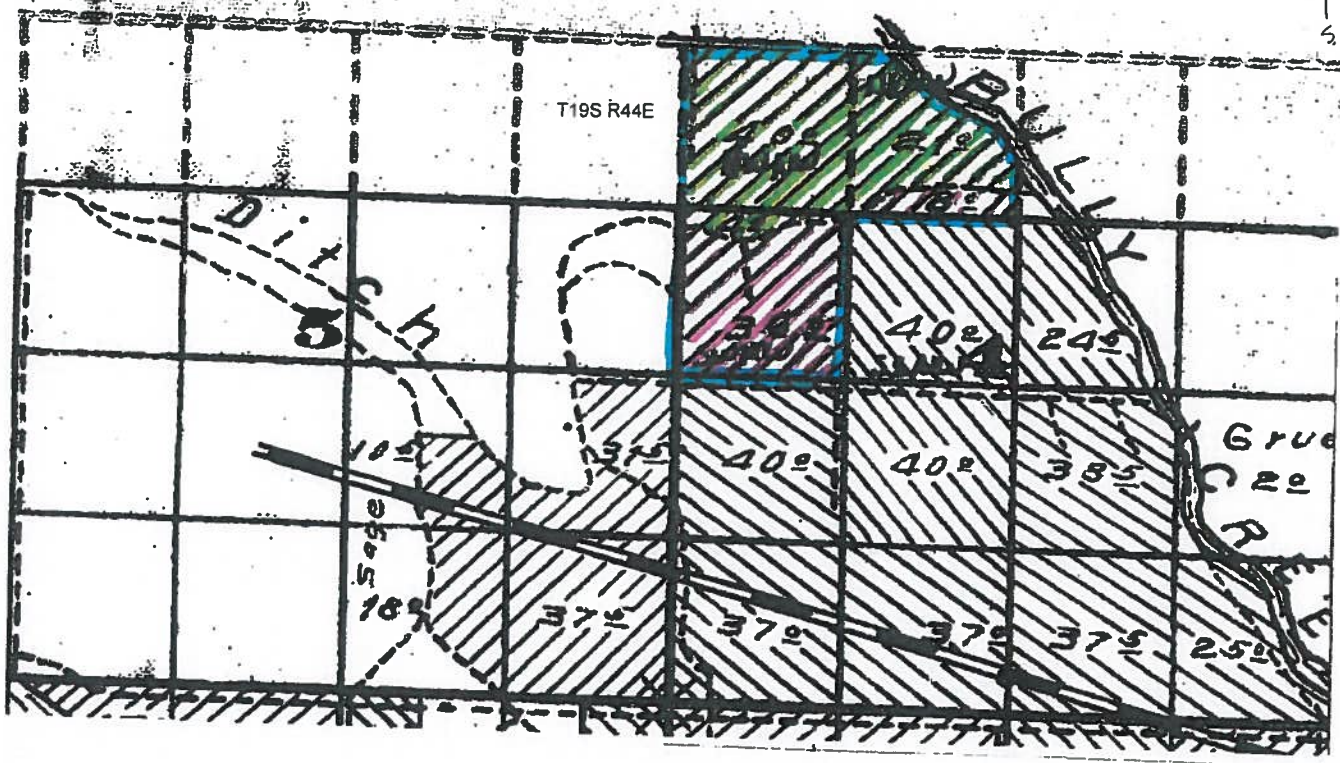

 Certificate 7049 authorized place of use
 Acres proposed for Change
 Acres unchanged

SALEM, OR

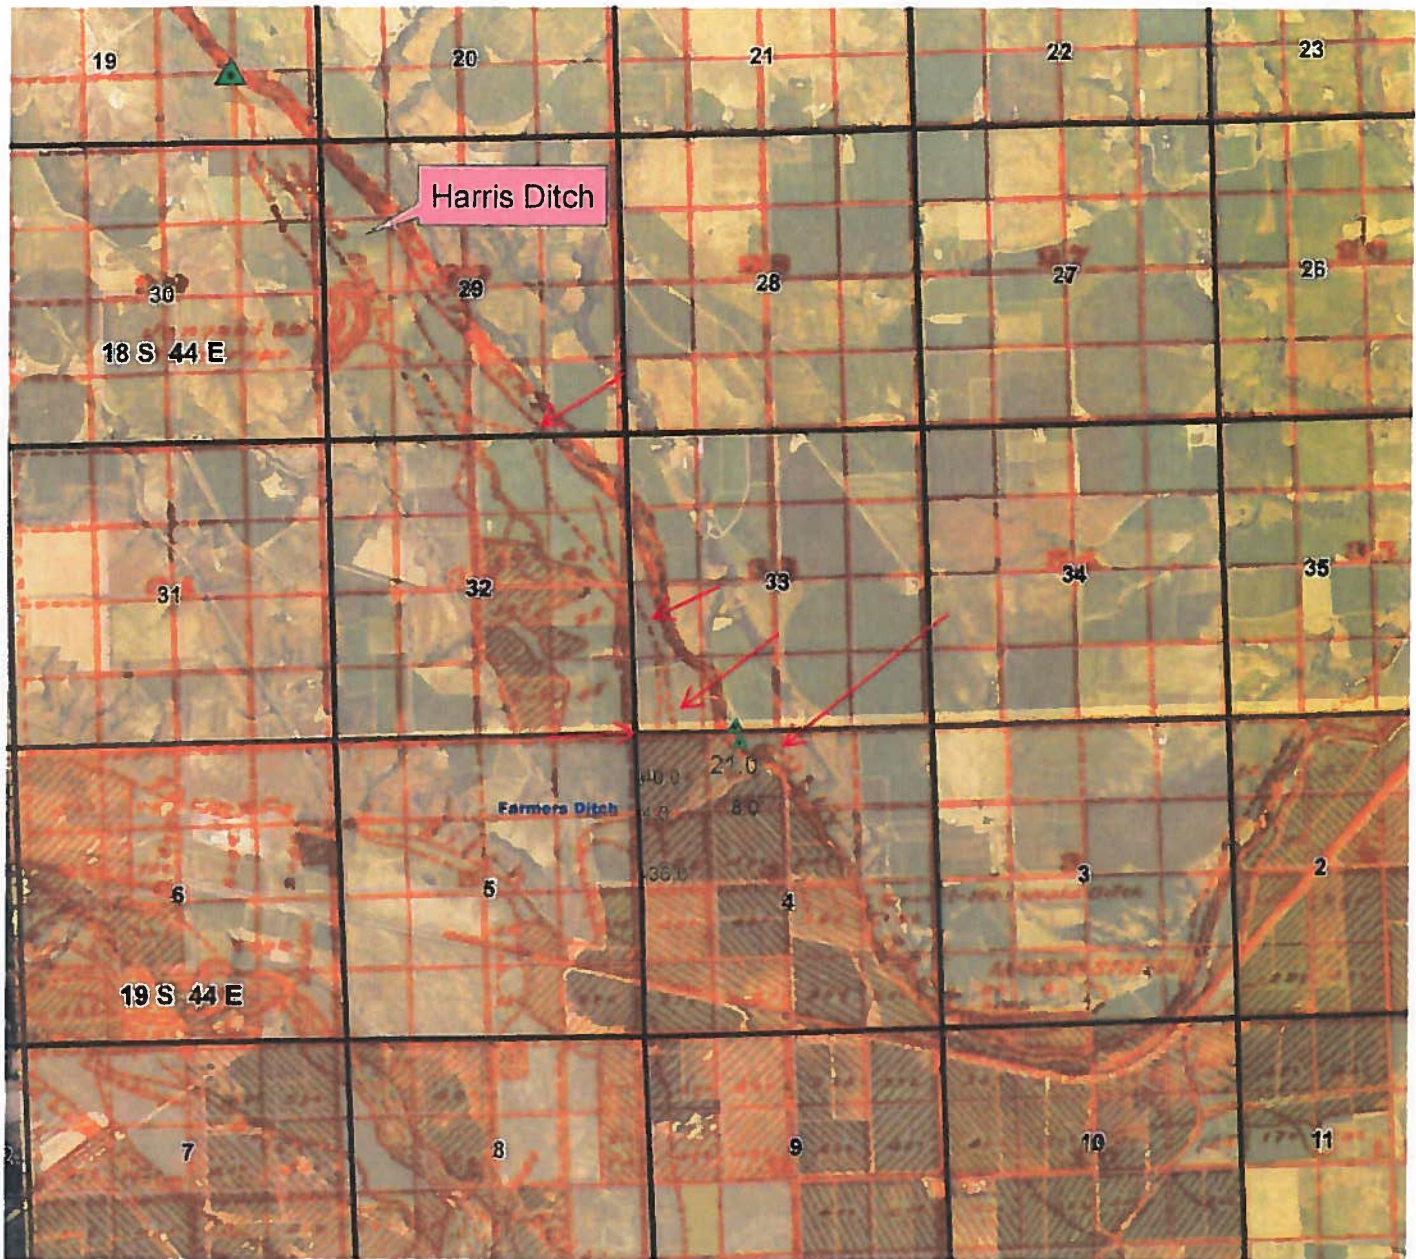

ORIGINAL DECREE MAP GEOREFERENCED ONTO AERIAL PHOTO

RECEIVED BY OWRD

SEP 26 2013

T011668

SALEM, OR


ATTACHMENT B
PROPOSED POU & POD MAP

RECEIVED BY OWRD

SEP 26 2013

T011668

SALEM, OR

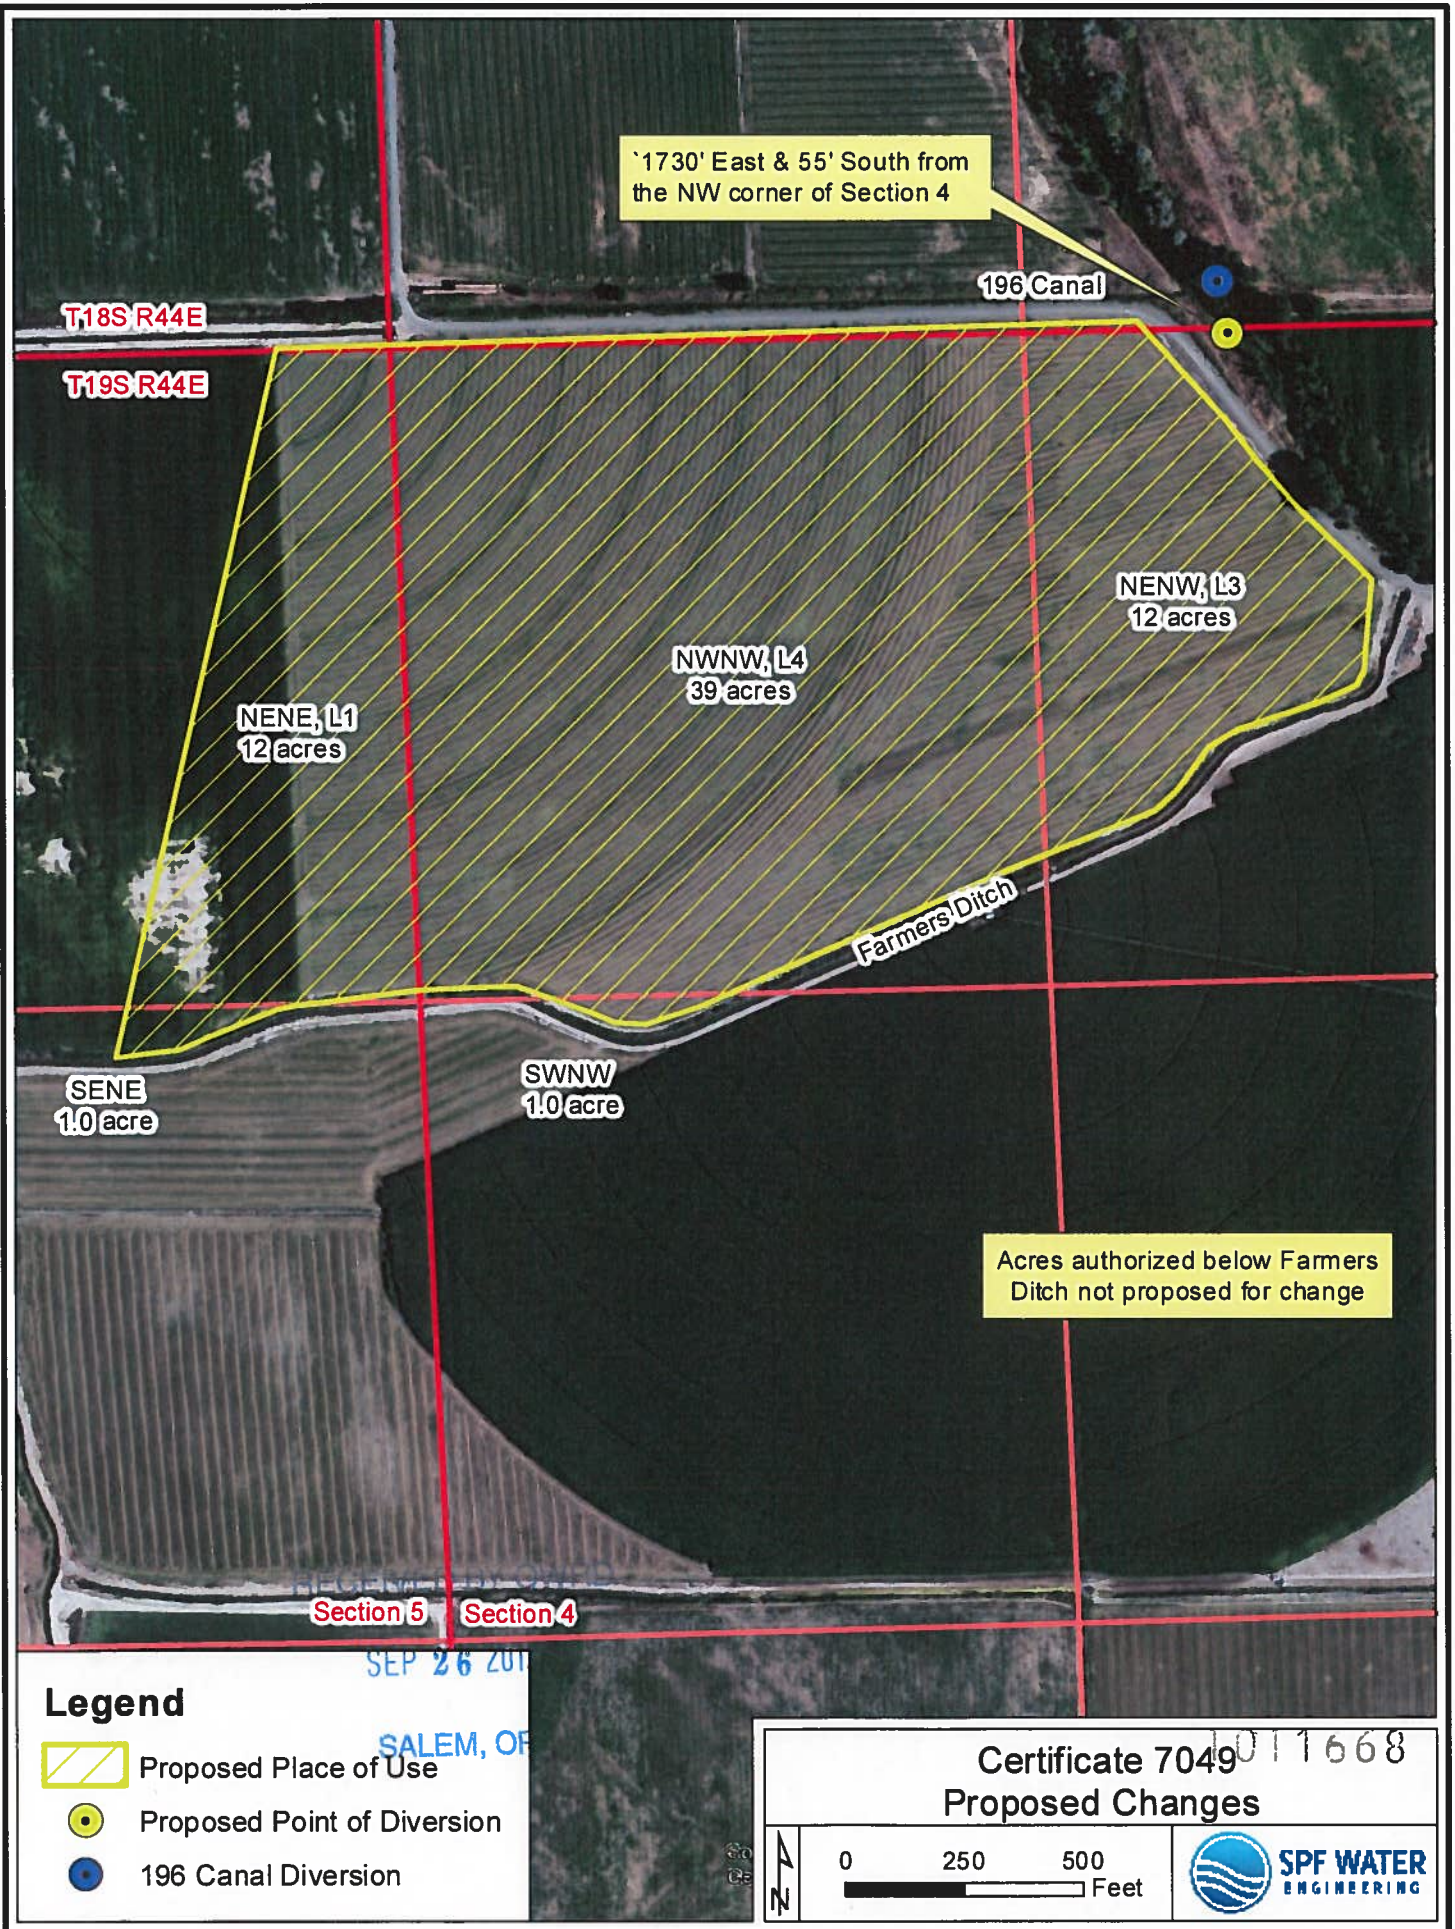

ATTACHMENT C
TAX LOT 3700 BOUNDARY MAPS

RECEIVED BY OWRD

SEP 26 2013


SALEM, OR

1" = 2000'
SEE MAP 18S 44E



TAX LOT 3700 BOUNDARY MAP

GREG AMARAL TRANSFER

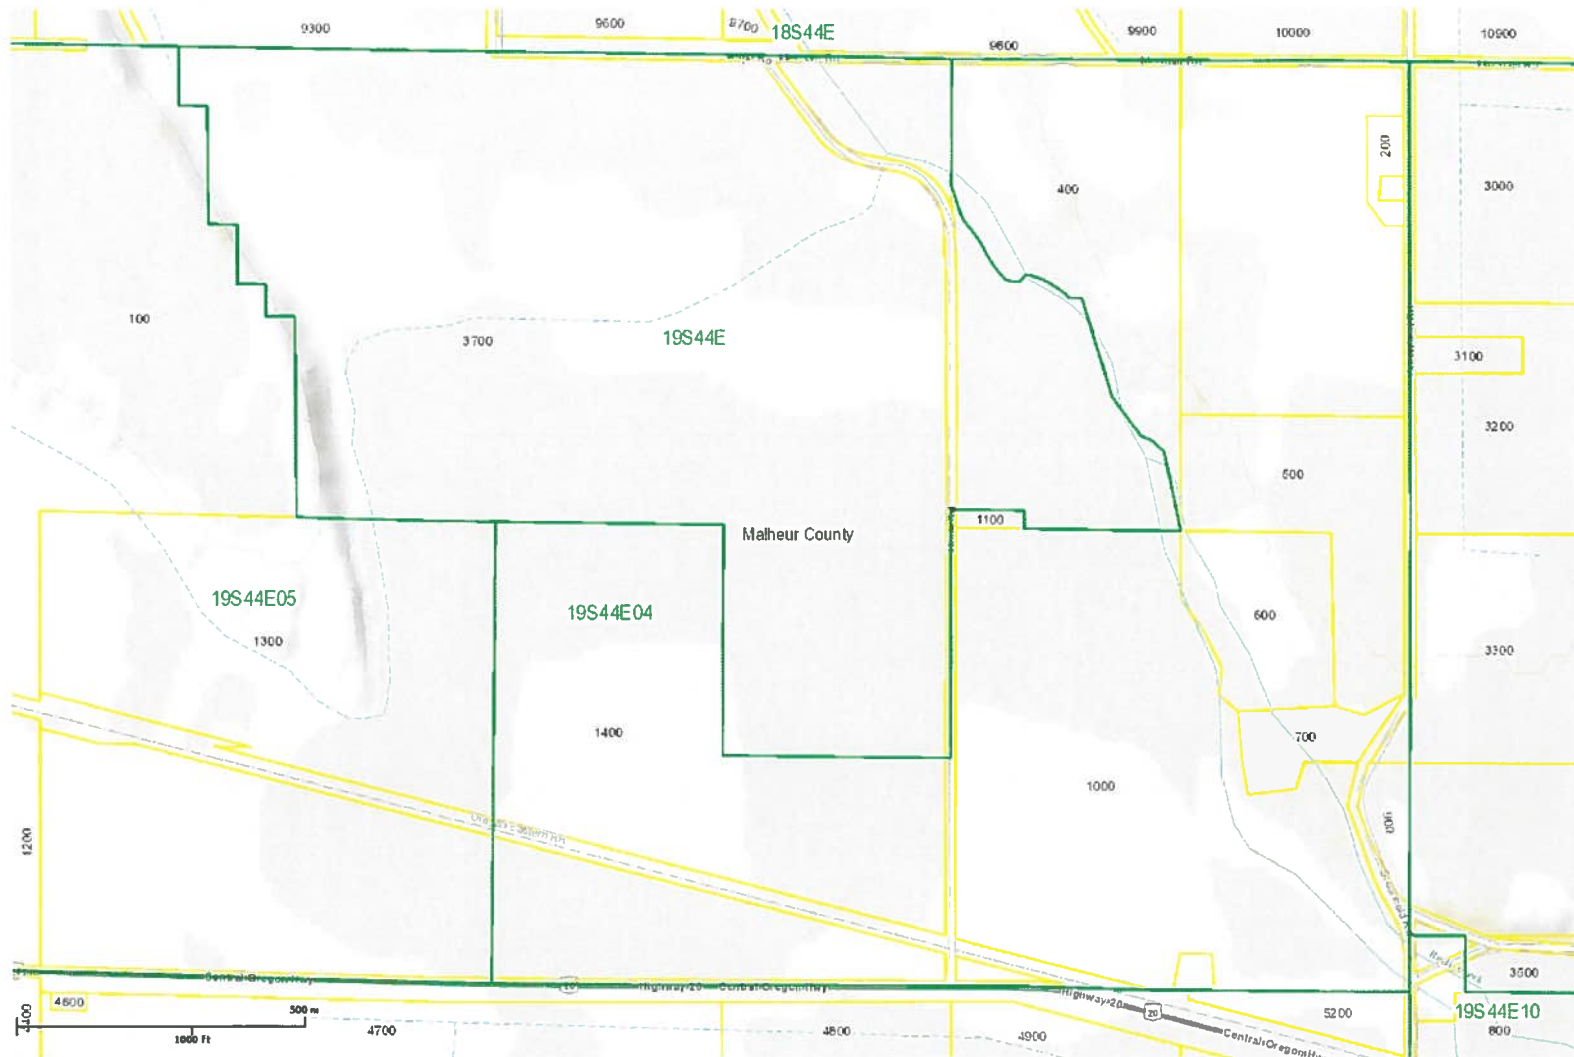

Copyright 2011 ORMAP. All rights reserved. Sun Sep 8 2013 11:05:01 AM

RECEIVED BY OWRD

SEP 26 2013

T011668

SALEM, OR

TAX LOT 3700 BOUNDARY MAP

GREG AMARAL TRANSFER



T011668

RECEIVED BY OWRD

SEP 26 2013

SALEM, OR