


Map to Accompany Historic Point of Diversion Change for Don Crompton

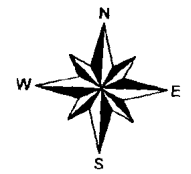


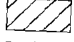
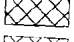

Scale: 1" = 1320'


T.8S, R.39E, WM

Legend

roads

Bennett_Ditch_H2O

-  Cert. 4018 - 1890
-  Cert. 4018 - 1890
-  Cert. 75726 - 1888
-  Cert. 75726 - 1888

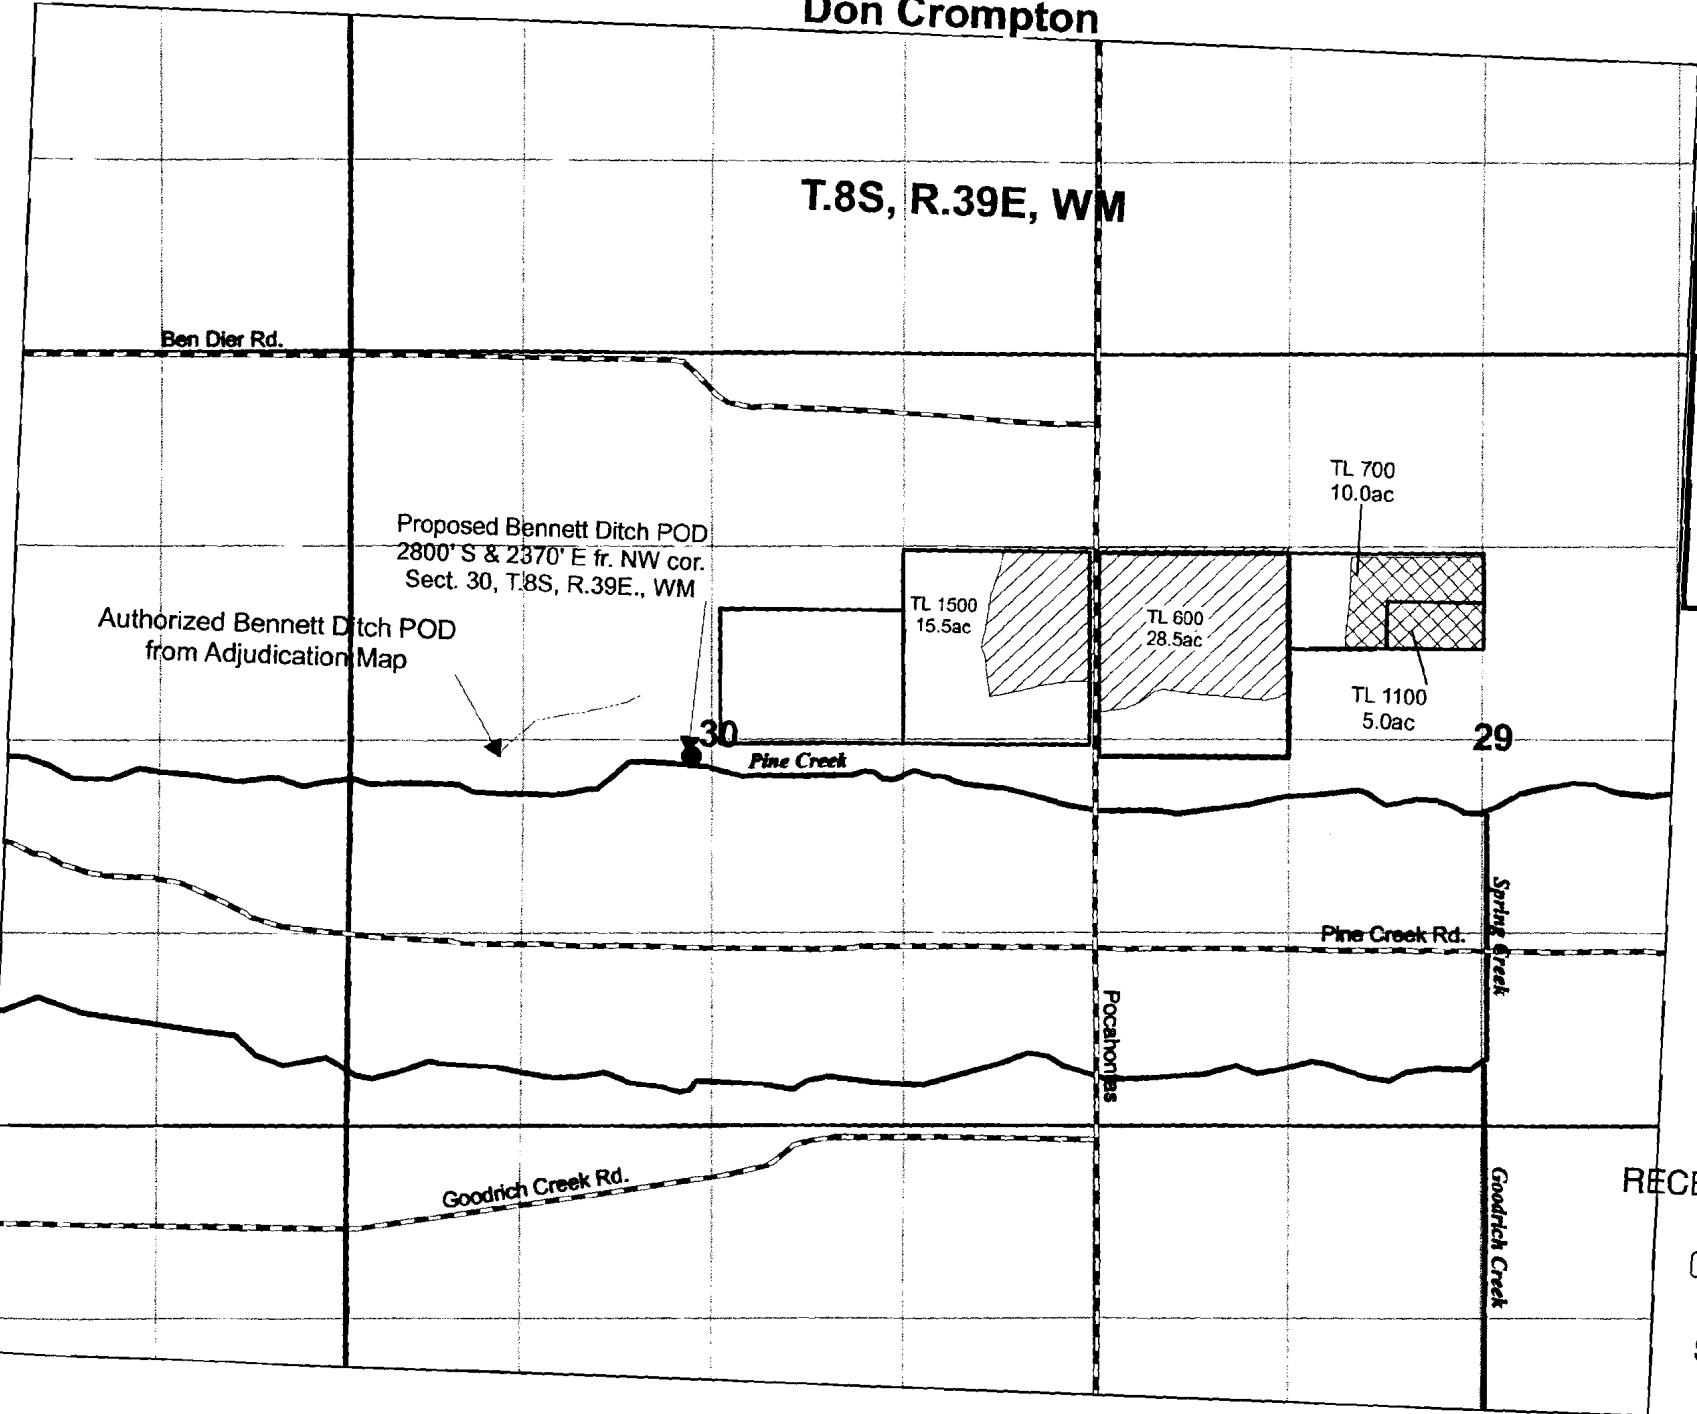

1011679

RECEIVED BY OWRD
OCT 23 2013
SALEM, OR