

33 | 34

4 | 3

NW CORNER  
SEC. 3

1701'  
1425'

(Tax Lot 1500  
Map 15-10-03B)

NW NW POA 1

NE NW

238'

7.15

0.1

371'

1.9

3.0

0.5

2.4

POA 2

Tax Lot 1501  
Map 15-10-03B


Section 3  
T15S, R10E, W.M.  
Deschutes Co. OR

SW NW

SE NW

# Application Map Water Rights Transfer

Certificate 80627 RECEIVED BY OWRD

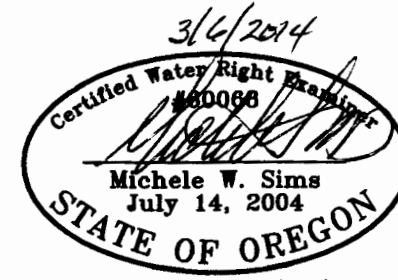

Renewal date: 6/30/2014

MAR 10 2014

SALEM, OR

Changes to Cert. 80627, priority date  
12/17/1990:



Water to remain




Water to transfer off



Water to transfer on

Property line

THIS MAP IS FOR THE PURPOSE OF IDENTIFYING THE LOCATION OF THE WATER RIGHT. IT IS NOT INTENDED TO PROVIDE LEGAL DIMENSIONS OR LOCATIONS OF PROPERTY OWNERSHIP LINES.

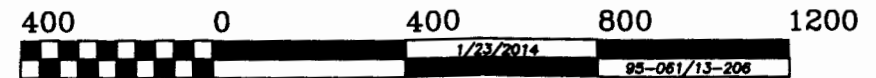

GRAPHIC SCALE - FEET

