

2N-10E-20
SE 1/4 1/4



RECEIVED BY OWRD


APR 17 2014

SALEM, OR

SEE MAP 02N 10E 2

Map Legend	
Grant & Sandra Porter	
Map Symbols	
	Valve
	Pipeline
	Property Line
Water Right Certificate	
C-81340	
	Transfer To
Water Right Certificate	
C-80929	
	Transfer To
Section	
2N-10E-20 SE 1/4 1/4 TL 2202	
W.M. Hood River County	
Scale 1" = 400'	
East Fork Irrigation District Hood River, Oregon	

SEE MAP 02N 10E 29
 Transfer To: 12 ac. C-81340
 19 ac C-80929
 1011794

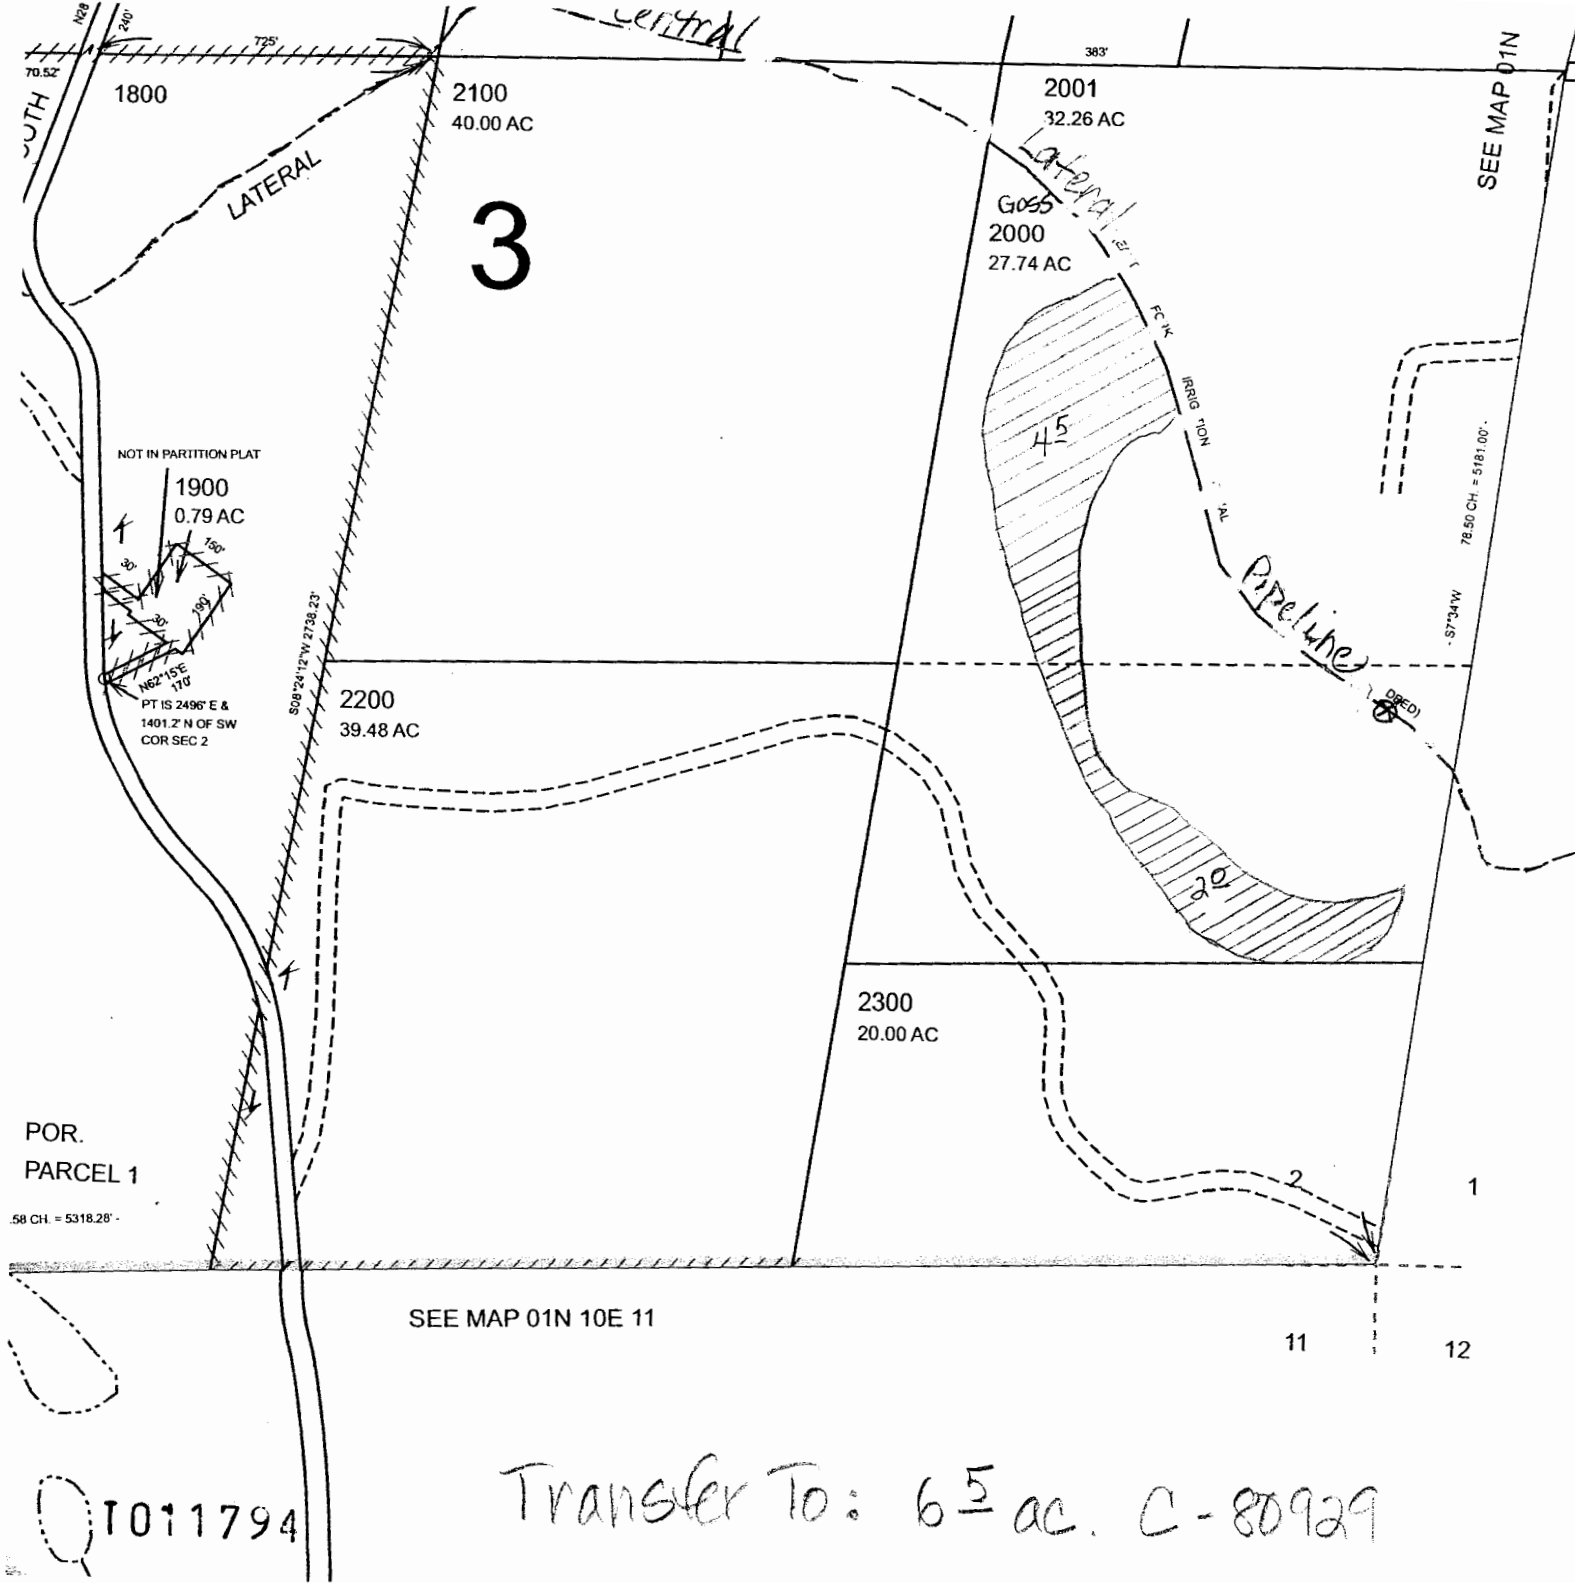

IN-10E-02
SE 1/4 1/4

RECEIVED BY OWRD
APR 17 2014
SALEM, OR



Map Legend	
Truman & Mildred Goss	
Map Symbols	
	Valve
	Pipeline
	Property Line
Water Right Certificate	
C-80929	
	Transfer To
Section	
1N-10E-02 SE 1/4 1/4 TL 2100	
W.M. Hood River County	
Scale 1" = 400'	
East Fork Irrigation District Hood River, Oregon	

POR.
PARCEL 1

58 CH. = 5318.28'

SEE MAP 01N 10E 11

11 12

Transfer To: 6 ⁵/₈ ac. C-80929

Q1011794

01N10


RECEIVED BY OWRD

APR 17 2014

SALEM, OR

1N-10E-02
SW 1/4 1/4

3

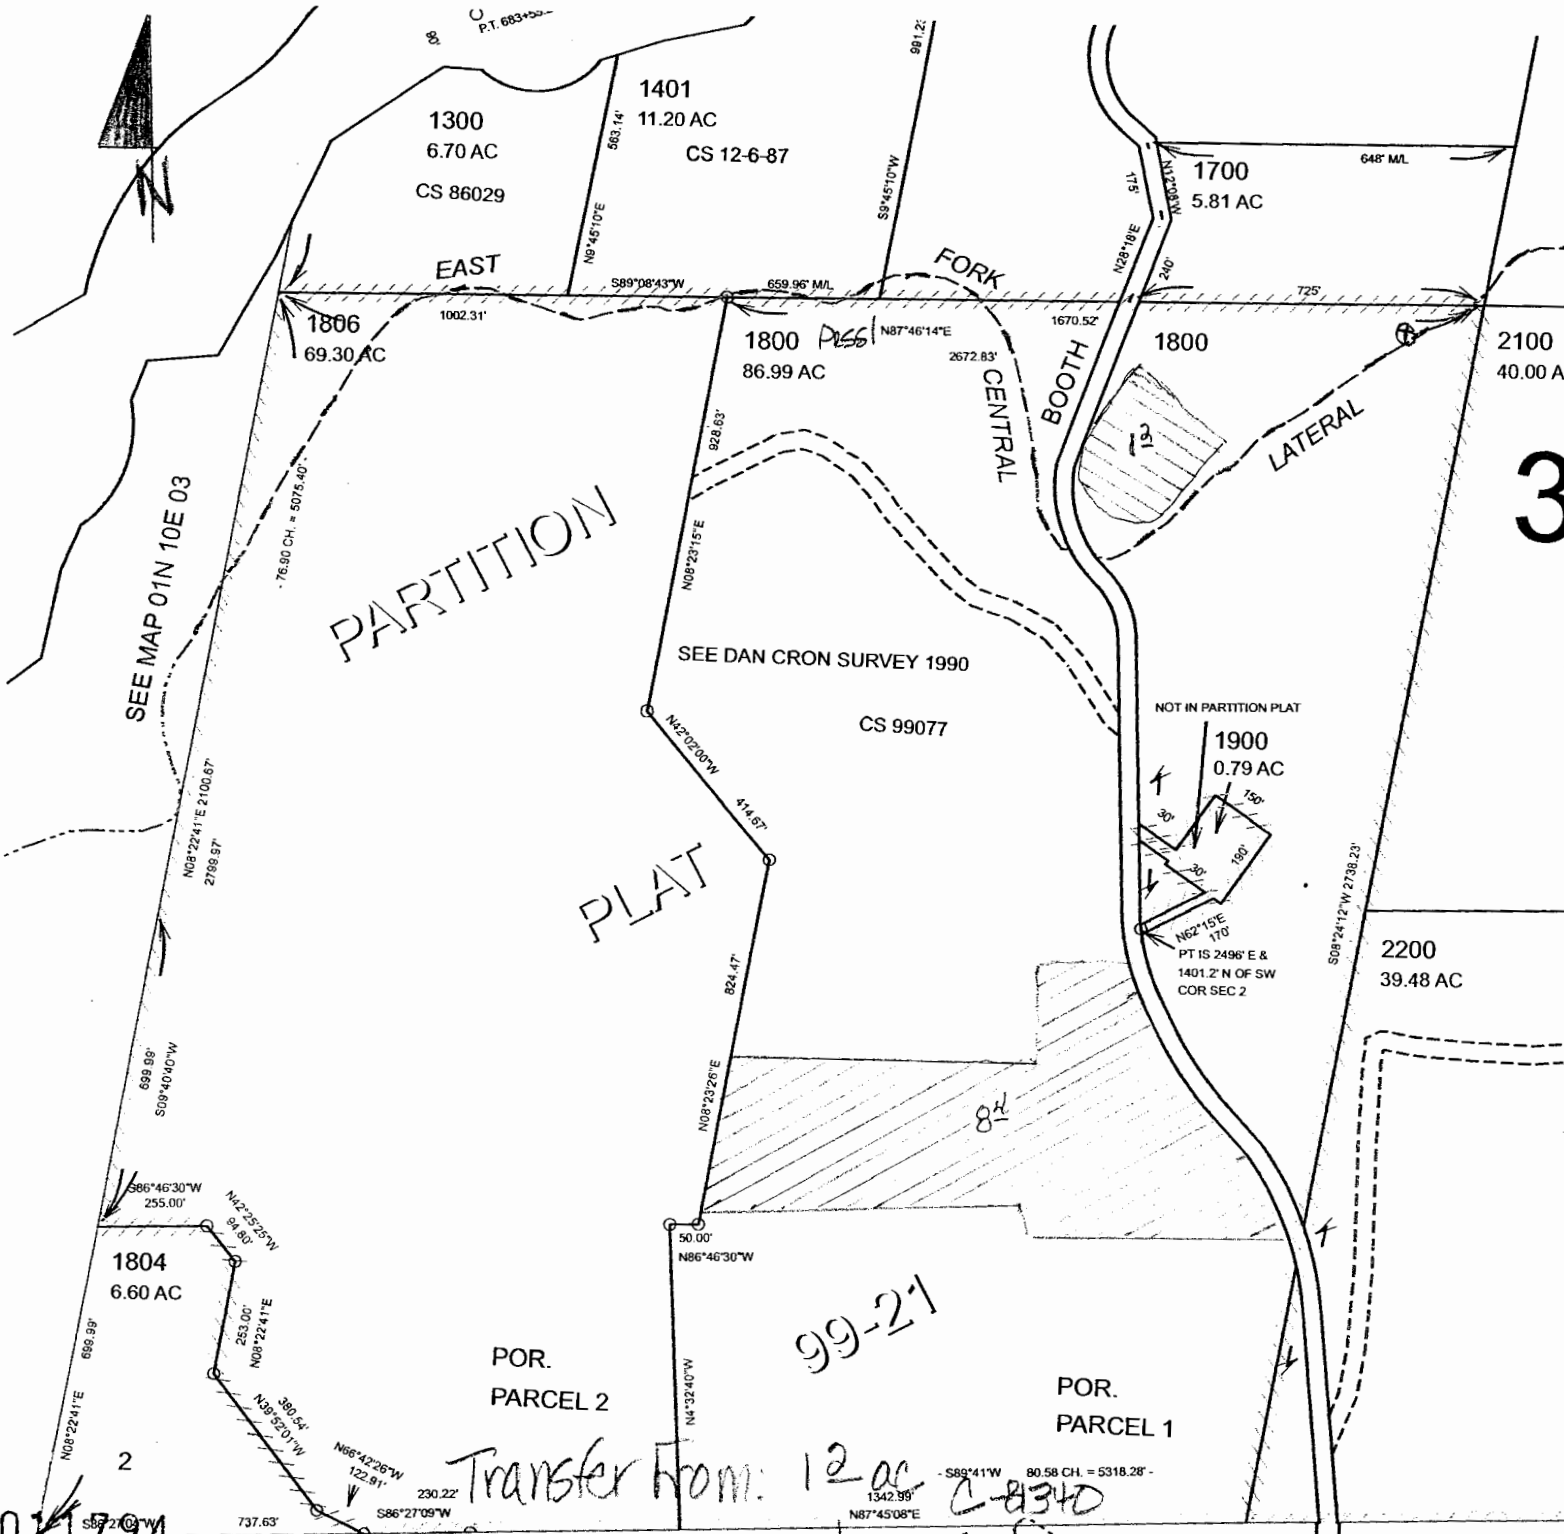

Map Legend	
H. Michael Pessi	
Map Symbols	
	Valve
	Pipeline
	Property Line
Water Right Certificate	
	Transfer From
Water Right Certificate	
	Transfer From
Section	
1N-10E-02 SW 1/4 1/4 TL 1800	
W.M. Hood River County	
Scale 1" = 400'	
East Fork Irrigation District Hood River, Oregon	

TO 11794

99-21

Transfer From: 12 ac C-8340
8 1/2 ac C-80929

SEE MAP 01N 10E 11