


Frances Nibler Temp Transfer

1" = 1320'

Tax Lot: 100 & 1400

Certificate 24217

Township 7 South, Range 5 West, Section 25 & 36

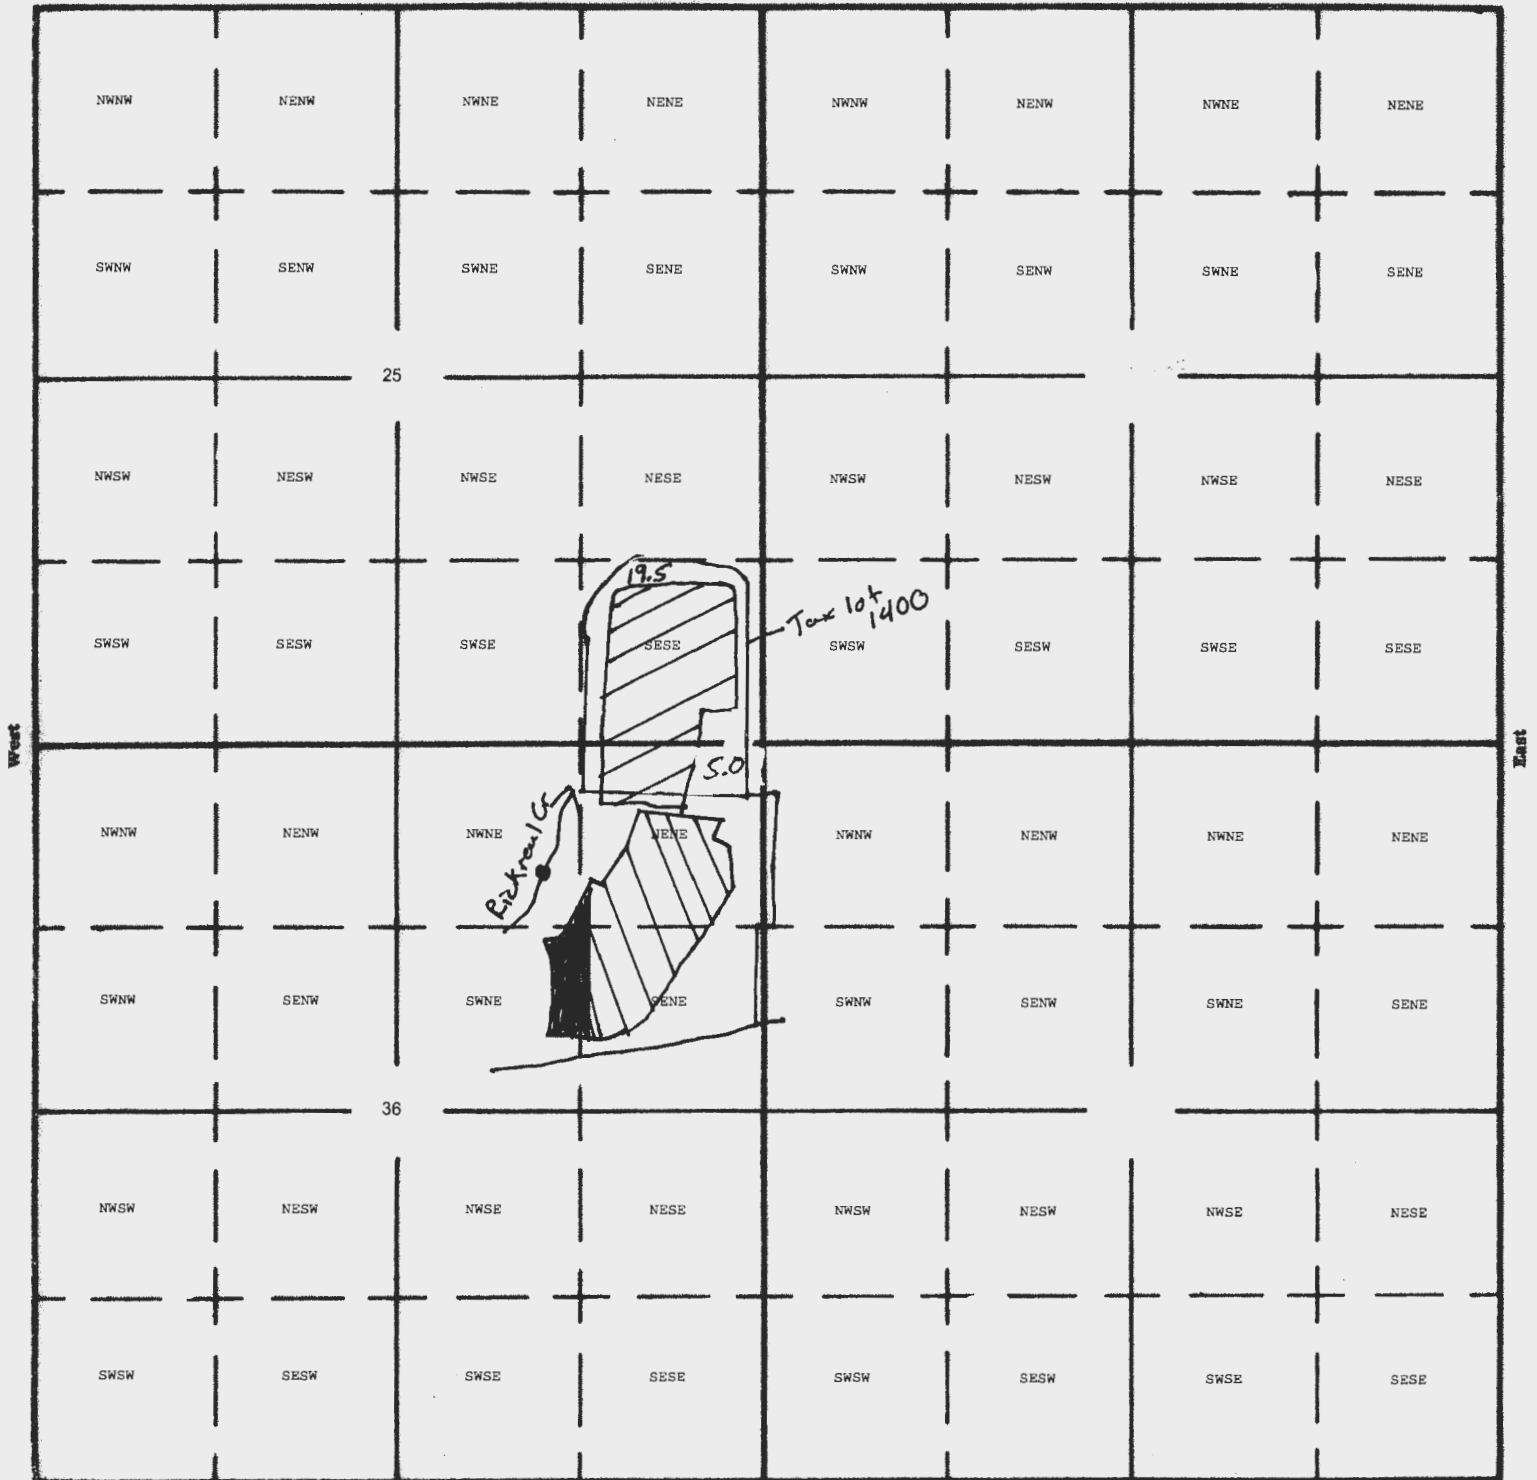

South

*Francis Nibler*      5-16-2014

Point of Diversion: same as original NWNE as projected within James Kinsey DLC #72, Section 36, Township 7 South, Range 5 West, W.M.

//// From

//// to

~~////~~ Remain