


**MAP TO ACCOMPANY WATER RIGHT  
TRANSFER APPLICATION**

SECTION 29, T. 5 N., R. 29 E., W.M.  
UMATILLA COUNTY, OREGON  
APPLICANT: THURMAN L. DAVIS  
A PORTION OF  
PERMIT G-7060 CERTIFICATE 76378

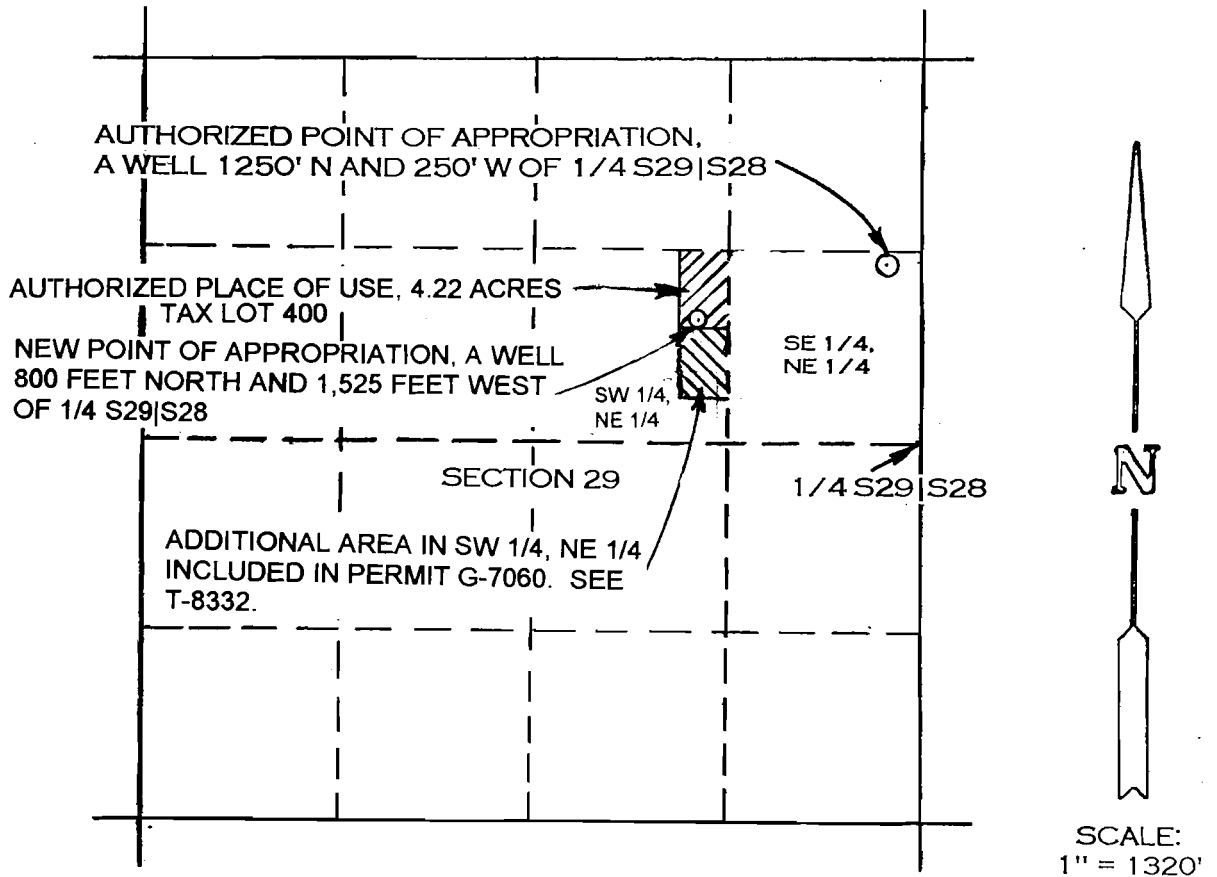


**RECEIVED**

MAR 25 2004

WATER RESOURCES DEPT  
SALEM, OREGON

*7.9685*

THIS MAP IS PREPARED FOR THE EXPRESS PURPOSE TO SHOW WATER APPROPRIATION AND USE. IT IS NOT INTENDED TO SHOW OR LOCATE PROPERTY OWNERSHIP LINES.

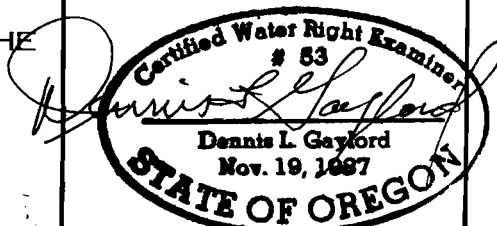

DENNIS L. GAYLORD, CWRE  
71614 S.W. LAKE DRIVE  
PENDLETON, OR 97801  
541 - 276 - 6260

JANUARY, 2004



RENEWS JUNE 30, 2005