



Township 1 South Range 39 East

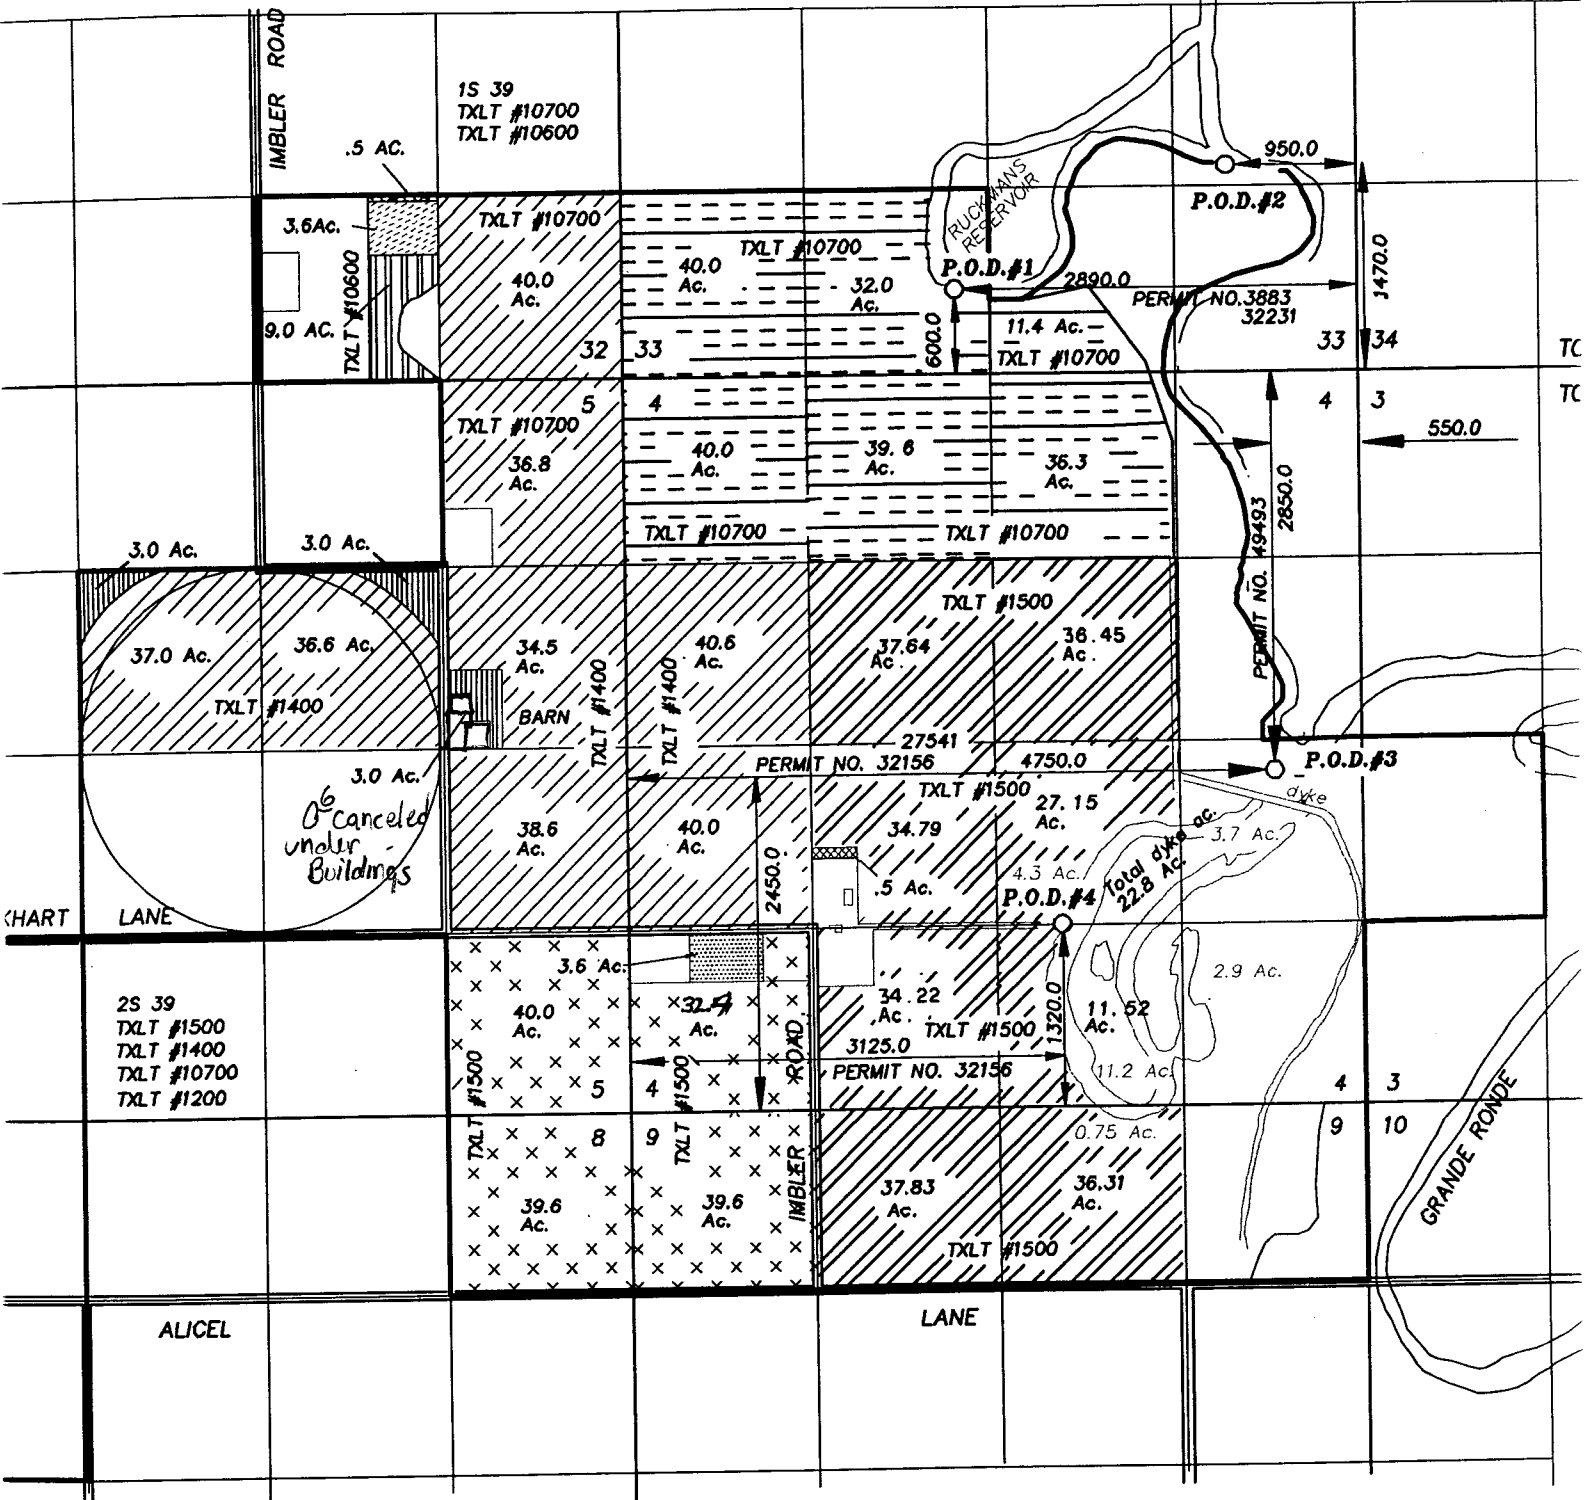

Township 2 South Range 39 East

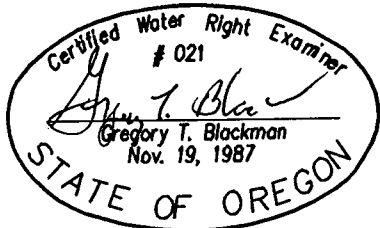

SUPERSEDING
ALICEL IRRIGATION DISTRICT

BY
BAGETT - GRIFFITH & BLACKMAN
2006 ADAMS AVENUE