



FINAL PROOF MAP FOR GROUND WATER RIGHTS

IN THE NAME OF
CHARLES D. & MARGARET G. CHEYNE

LOCATED IN THE E 1/2 SEC. 35, W 1/2 SW 1/4 SEC. 36, T.39S., R.12E., W.M.
KLAMATH COUNTY, OREGON

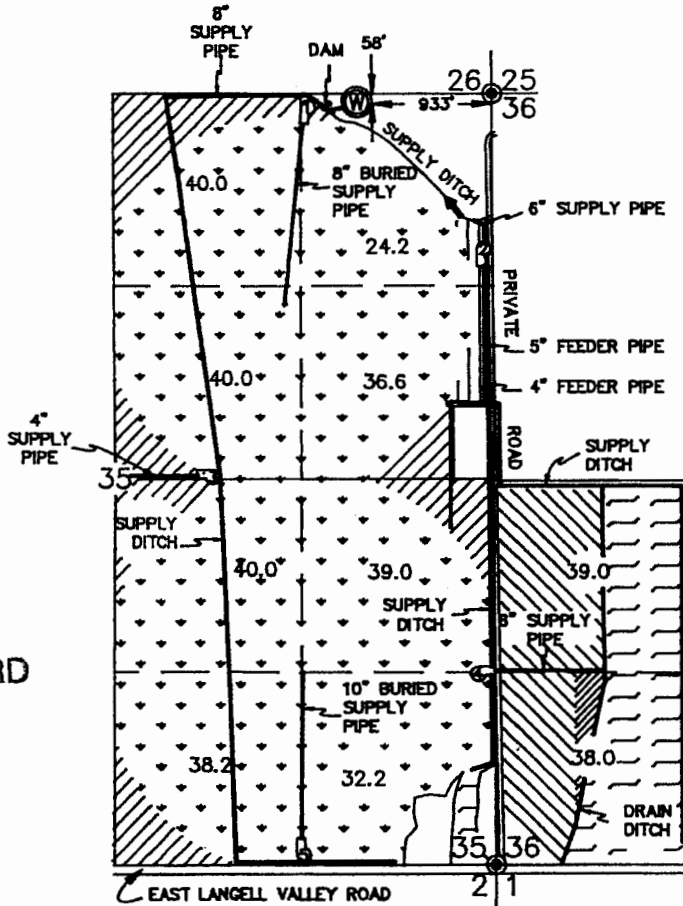

NOTE: THIS MAP IS FOR APPLICATION # G-12566, PERMIT # G-11327, A SUPPLEMENTAL USE TO LANGELL VALLEY IRRIGATION DISTRICT WATER RIGHT

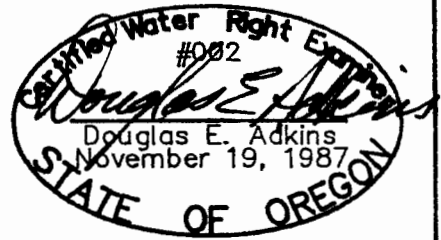








RECEIVED BY OWRD

JUL 25 2014

SALEM, OR

THIS MAP IS FOR THE PURPOSE OF IDENTIFYING THE LOCATION OF THE WATER RIGHT ONLY AND HAS NO INTENT TO PROMISE DIMENSIONS OR LOCATION OF PROPERTY LINES.

-  AREA IRRIGATED BY CENTER PIVOT SYSTEM
-  AREA FLOOD IRRIGATED
-  AREA IRRIGATED BY HAND LINES
-  AREA IRRIGATED BY WHEEL LINES
-  AREA IRRIGATED BY SINGLE SPRINKLER

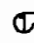-  FOUND 1/2" IRON ROD MONUMENT
-  PUMP - NUMBER REFERENCED IN WRITTEN REPORT
- 40.0 AREA IN ACRES PER 1/4 1/4

MAP PREPARED BY: ADKINS CONSULTING ENGINEERS, INC.
1453 ESPLANADE AVE.
KLAMATH FALLS, OREGON 97601
PHONE: (503) 884-4666

APRIL 1992 JOB NO: 1485-01


THIS MAP WAS PREPARED FOR ASSESSMENT PURPOSE ONLY

SECTION 01 T.40S. R13E. WM. KLAMATH COUNTY

1-400'


NE corner Section 2

SEE MAP 39 12

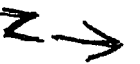

Smith well
NEW 1/4 NEW 1/4 Section 2, T40S R13E Wm, 40 FT South and 275 FT West from the NE corner of Section 2.

1A NEW 1/4 NW 1/4 Section 1
1B SE 1/4 NW 1/4 Section 1
1C NW 1/4 NE 1/4 Section 1
1D SW 1/4 NE 1/4 Section 1
All are in T40S R13E Wm Section 1 Tax Lot 200

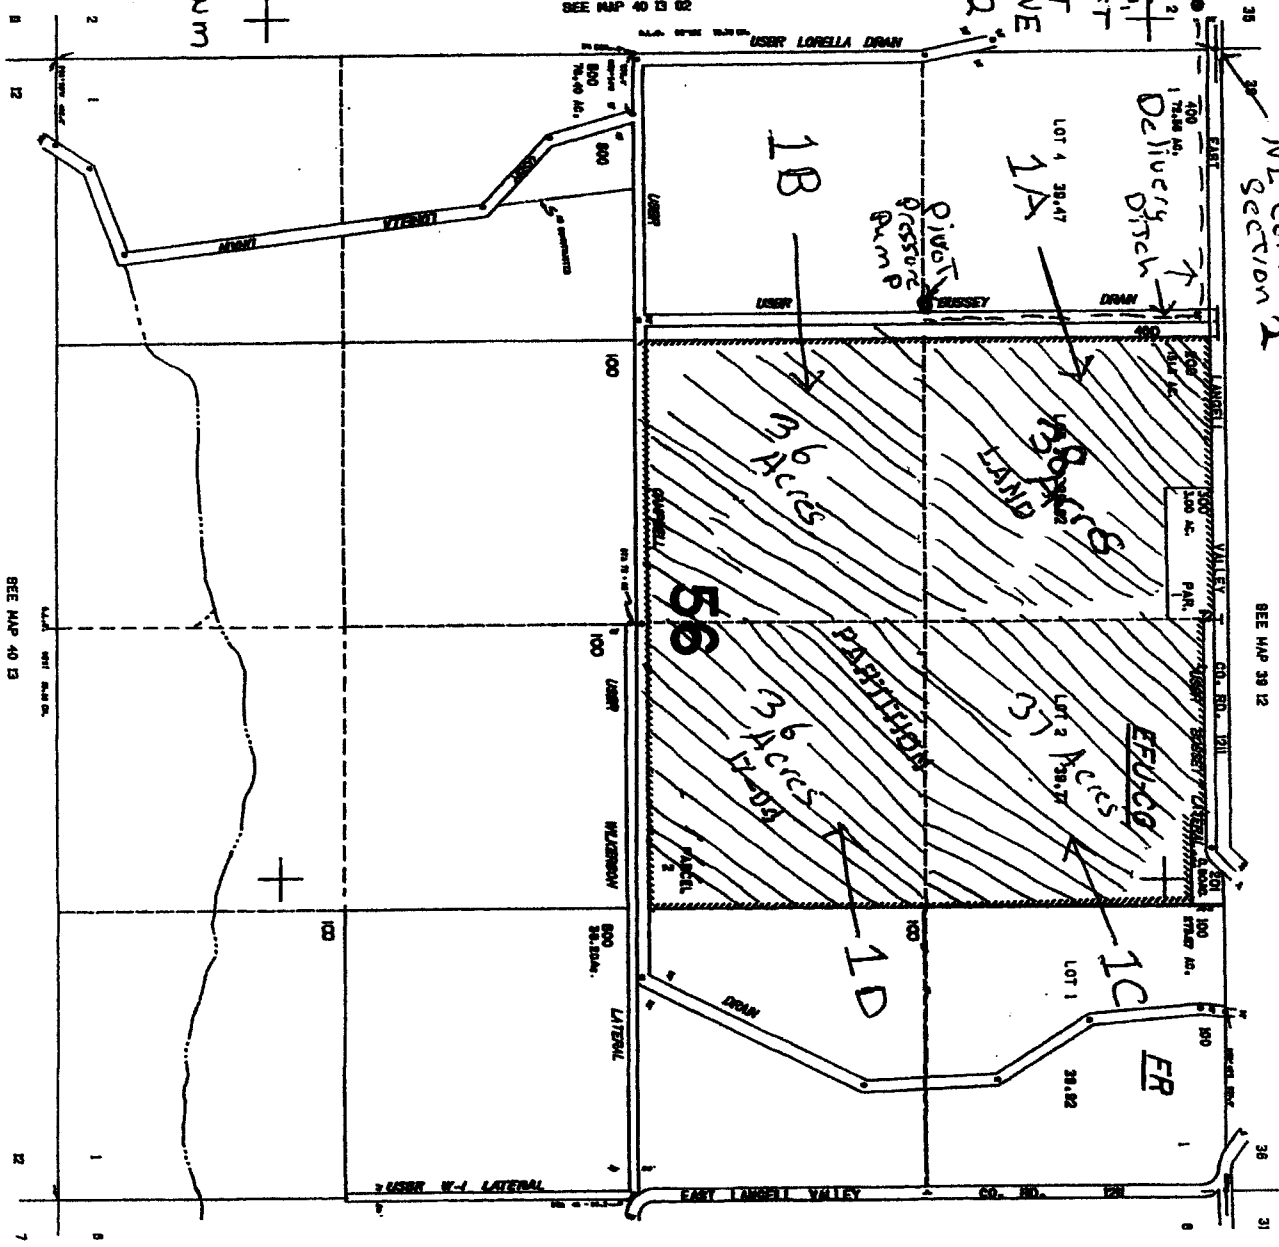

SEE MAP 40 14 6

180,000

RECEIVED BY OWRD

JUL 25 2014

Section 1

40 13 01

40 13 01

SEE MAP 40 13

780,000