


T. 36 S., R. 4 W., W.M.

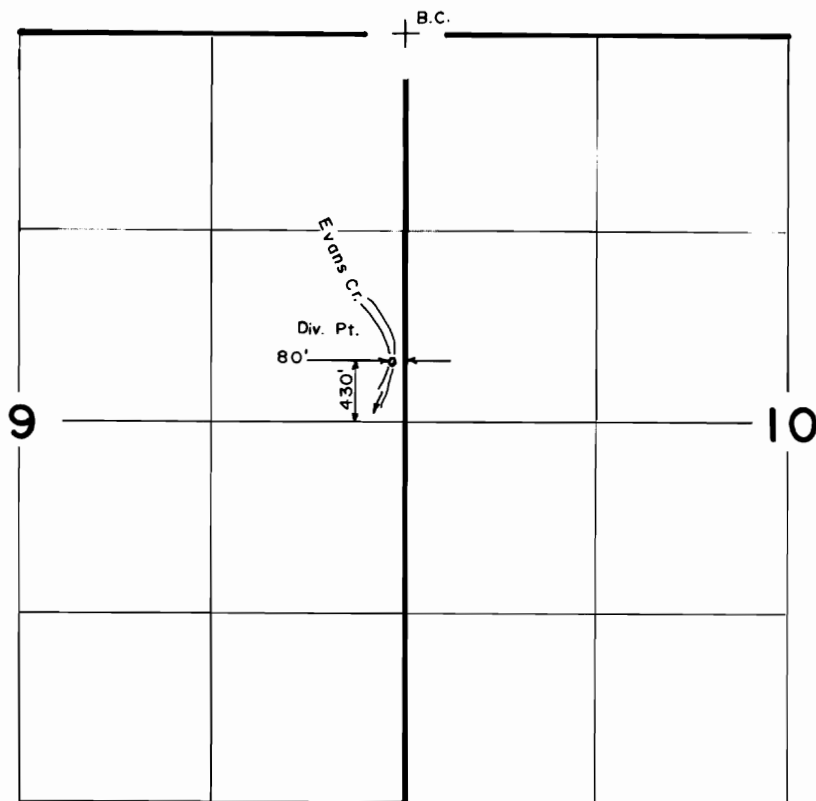

Scale: 1" = 1320'

FINAL PROOF SURVEY
UNDER

TRANSFER NO. 5007



Application No. Permit No.
IN NAME OF

..... LAURA B. DENNIS

Surveyed OCT. 13. 1986, by B. S. JAMES.


7/19/06 JWG
41029-179-10R LMS

T-5007

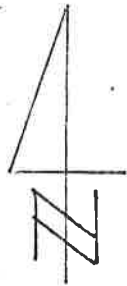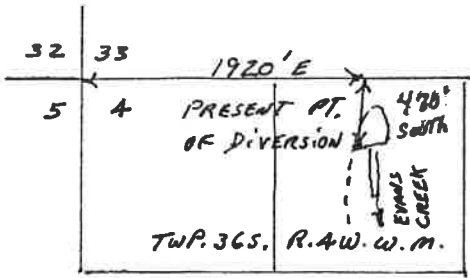

3-21-82

TWP. 36S. R. 4W. W.M.

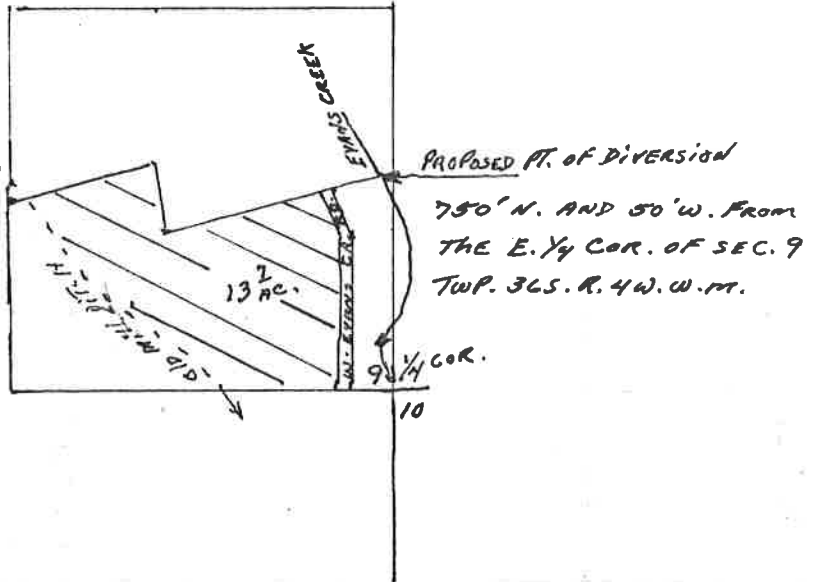

MAP TO ACCOMPANY JOEL A. AND/OR
 LAURA B. DENNIS FOR C.I.P.O.D. ON
 CERT. 32800 PRIORITY 1902